


DUNHAM SURVEYING, S.C.
SURVEYING & SUBDIVIDING
DELAVER, WISCONSIN 53115

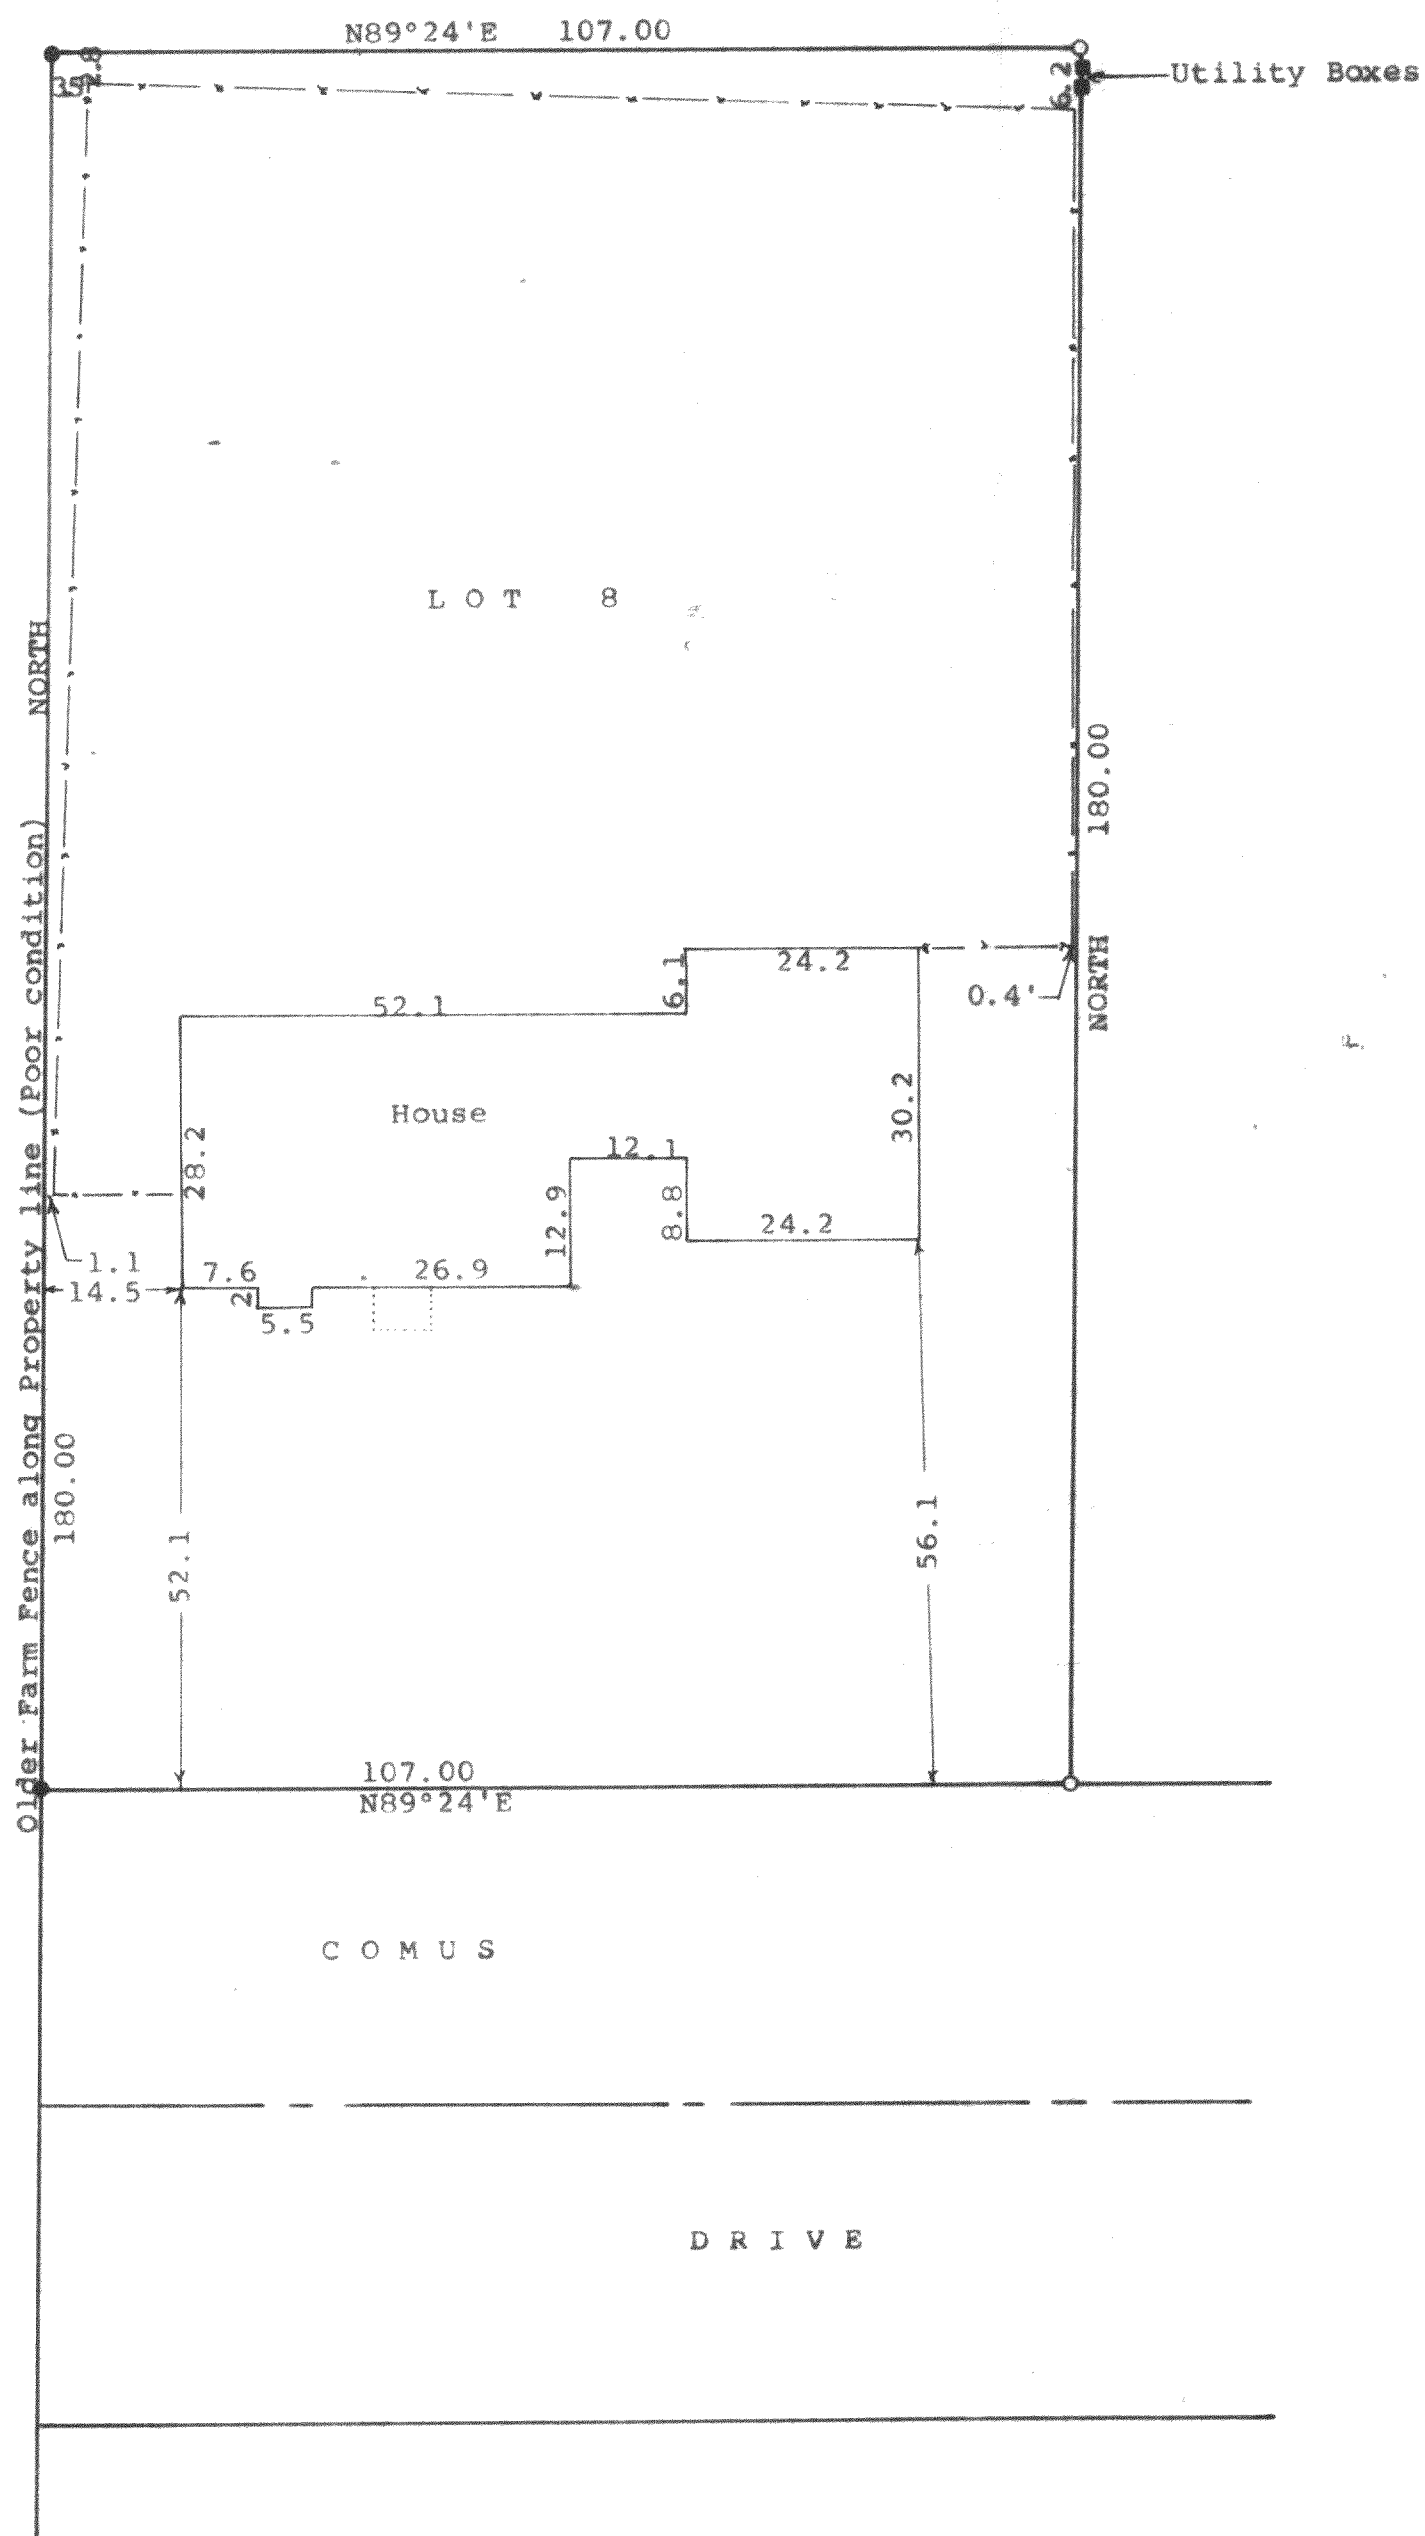

Scale - 1" = 20'
● = Concrete Monument Found
○ = 1" Iron Pipe Found
--- = Fence Line
Bearings are those on the recorded plat of
Hansen's Subdivision
Survey ordered by:
Kathleen Martin
867 Comus Drive
Delavan, WI 53115

STATE OF WISCONSIN)
COUNTY OF WALWORTH) SS

I, George T. Dunham, Surveyor, certify that I have surveyed the
property described as follows:

Lot 8, Block 1 of Hansen's Subdivision, located in the SW $\frac{1}{4}$ of
the SE $\frac{1}{4}$ and in the SE $\frac{1}{4}$ of the SW $\frac{1}{4}$ of Section 8, T 2 N, R 16 E,
Walworth County, Wisconsin,

and that the plat shown hereon is a correct representation thereof and shows
the size and location of the property, its exterior boundaries, the location
of all visible structures and dimensions of all principal buildings thereon,
boundary fences, apparent easements, roadways and visible encroachments, if
any, and that I have surveyed the property hereon described, according to the
official records, to the best of my knowledge and belief.
January 10, 1992

George T. Dunham
George T. Dunham, Surveyor

