


GEORGE T. DUNHAM
SURVEYING & SUBDIVIDING
DELAVAN, WISCONSIN



N

Scale - 1" = 20'
O = Iron Pipe
X = Cross in Concrete

Revision ordered to show proposed
garage location on Oct. 14, 1991
by: Richard Bonsall
R. 6, Box 170A
Hickory Court
Elkhorn, WI 53121

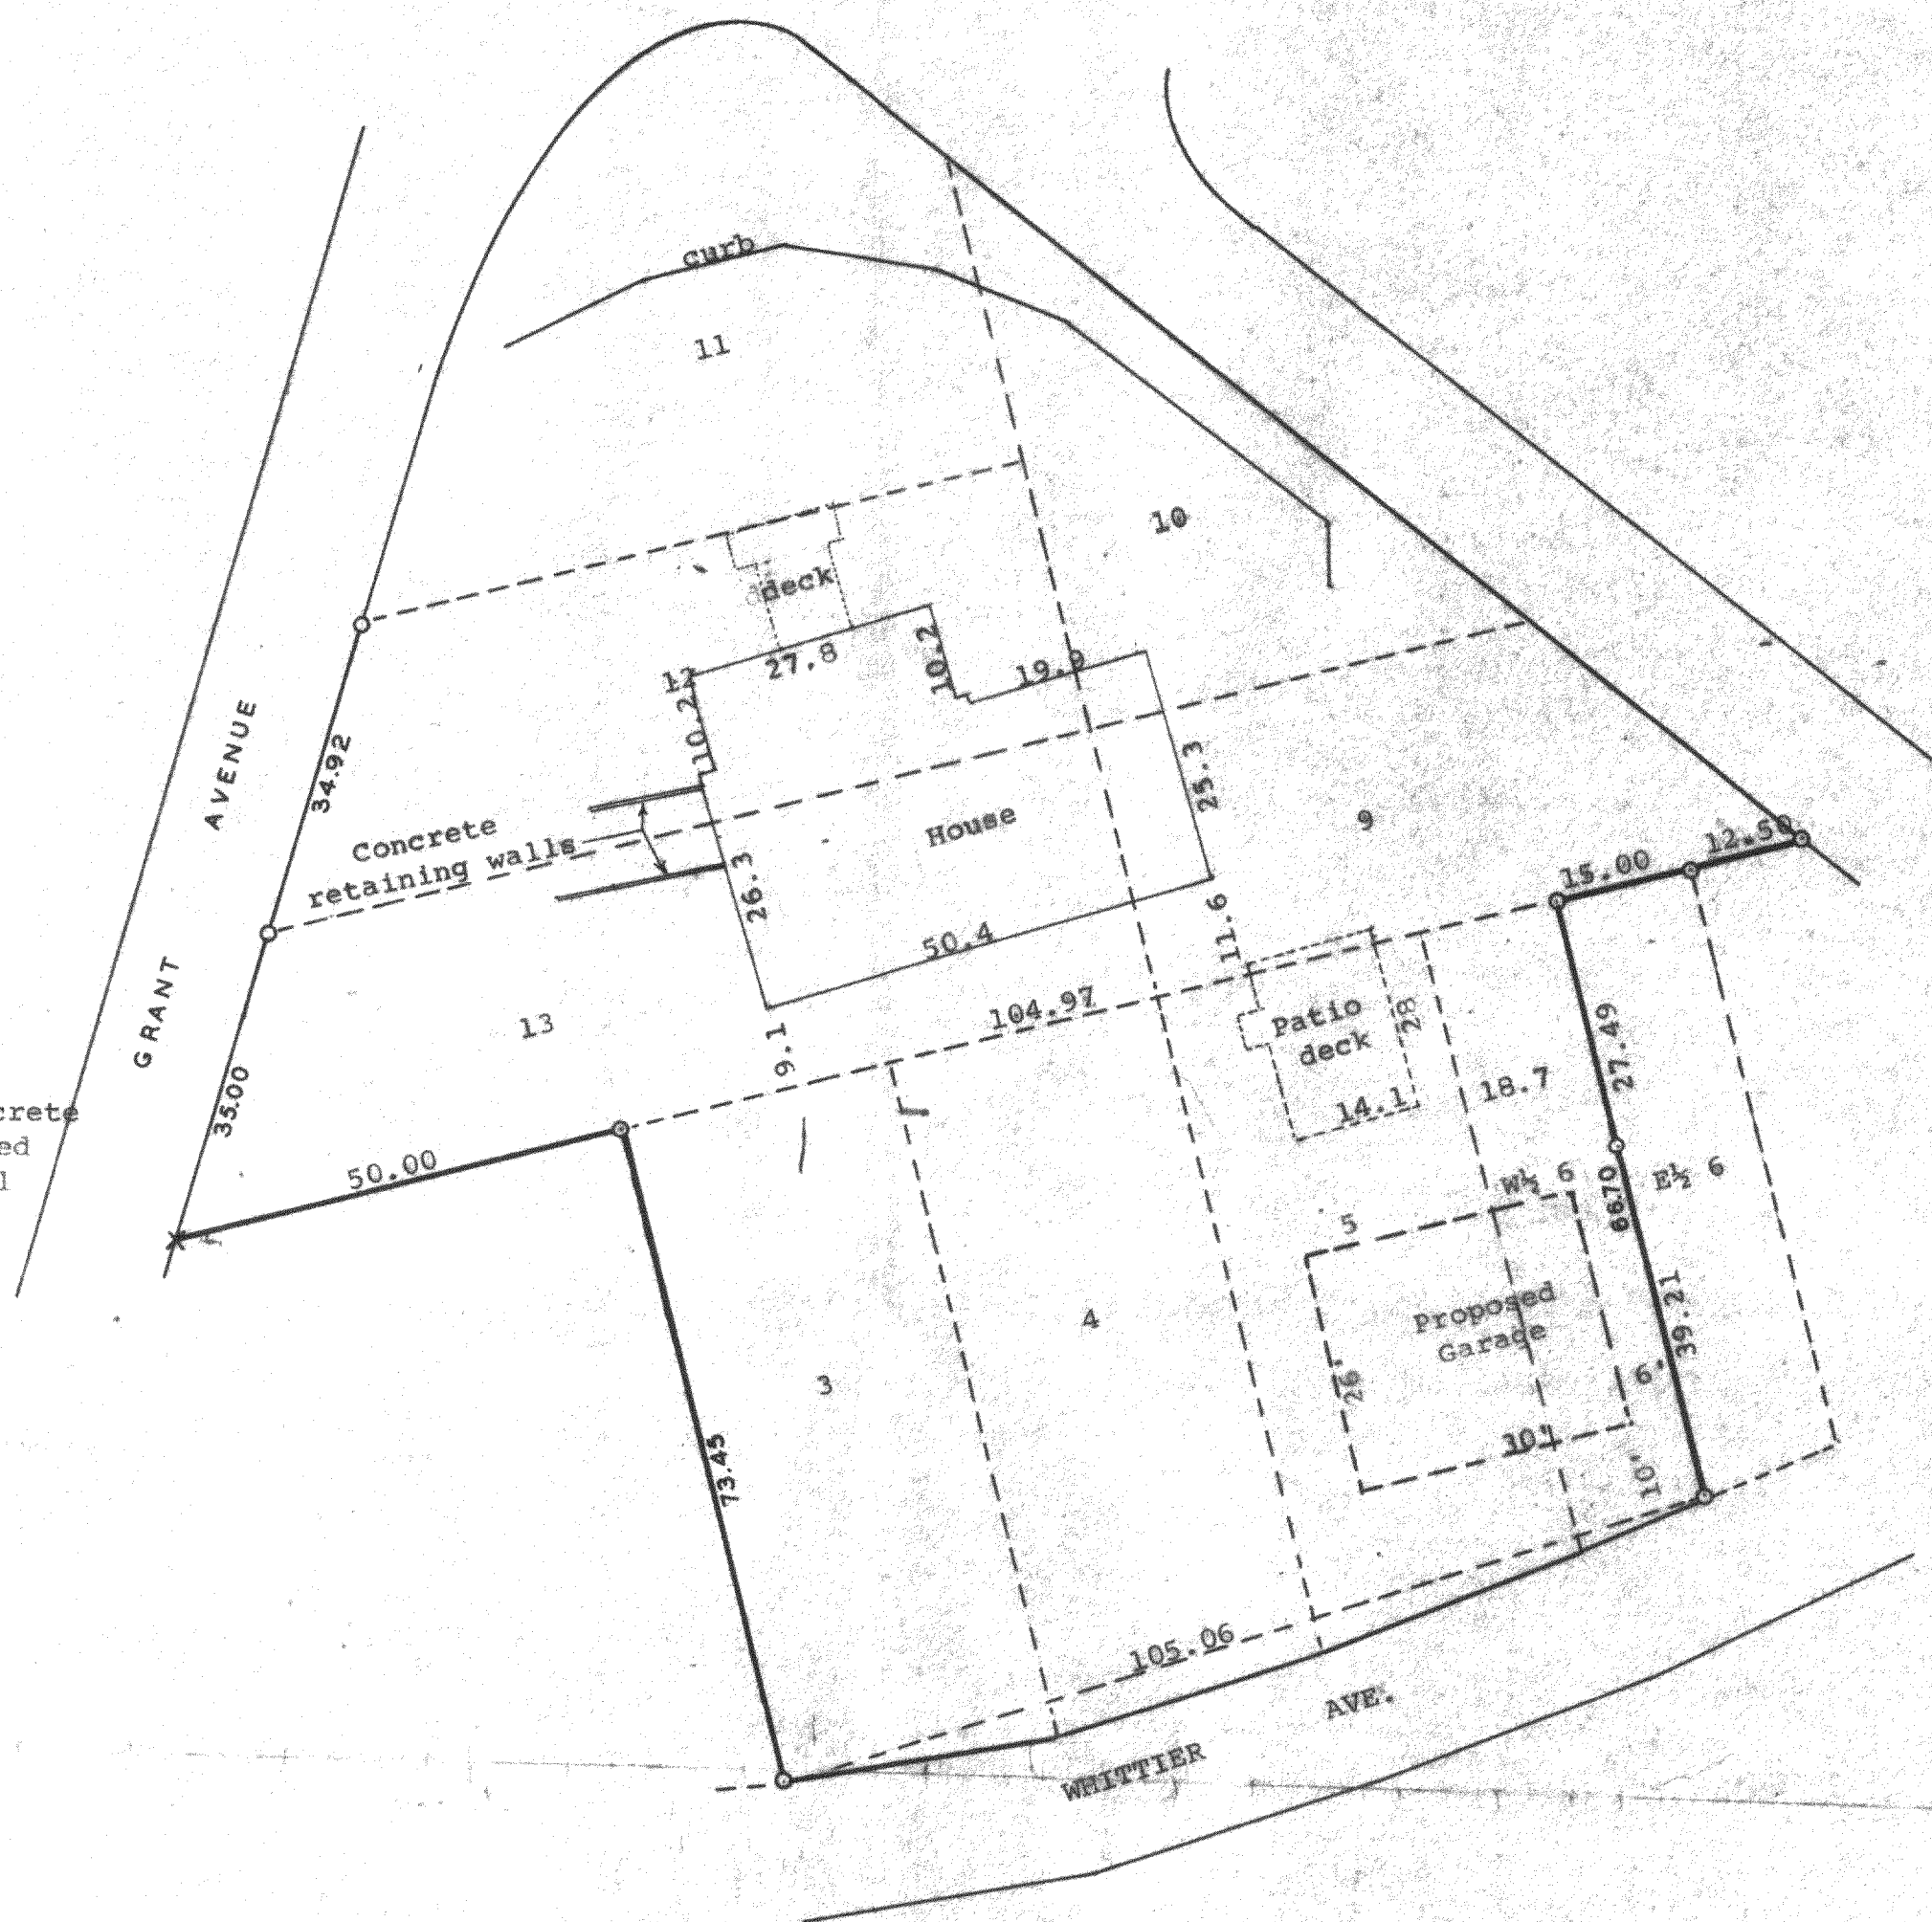

Plat of survey of Lots 3, 4, 5, West 1/2 of Lot 6, 9, 10,
11, 12, and 13 all in Block "Y" of Delavan Lake Assembly
Grounds, T 2 N, R 16 E, Walworth County, Wisconsin.
May 4, 1968
Revised 10/14/91 *George T. Dunham*
to show proposed George T. Dunham, Surveyor
Garage location
Revised 11/4/91 to show existing
buildings.

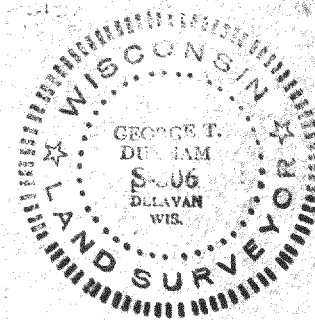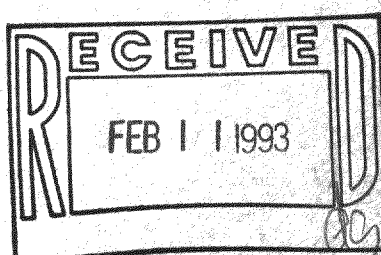


GEORGE T. DUNHAM
SURVEYING & SUBDIVIDING
DELAVER, WISCONSIN

N

Scale - 1" = 20'
O = Iron Pipe
X = Cross in Concrete

Revision ordered to show proposed
garage location on Oct. 14, 1991
by: Richard Bonsall
R. 6, Box 170A
Hickory Court
Elkhorn, WI 53121
Revision ordered to show proposed
house addition 3/6/92 by:
Richard Bonsall

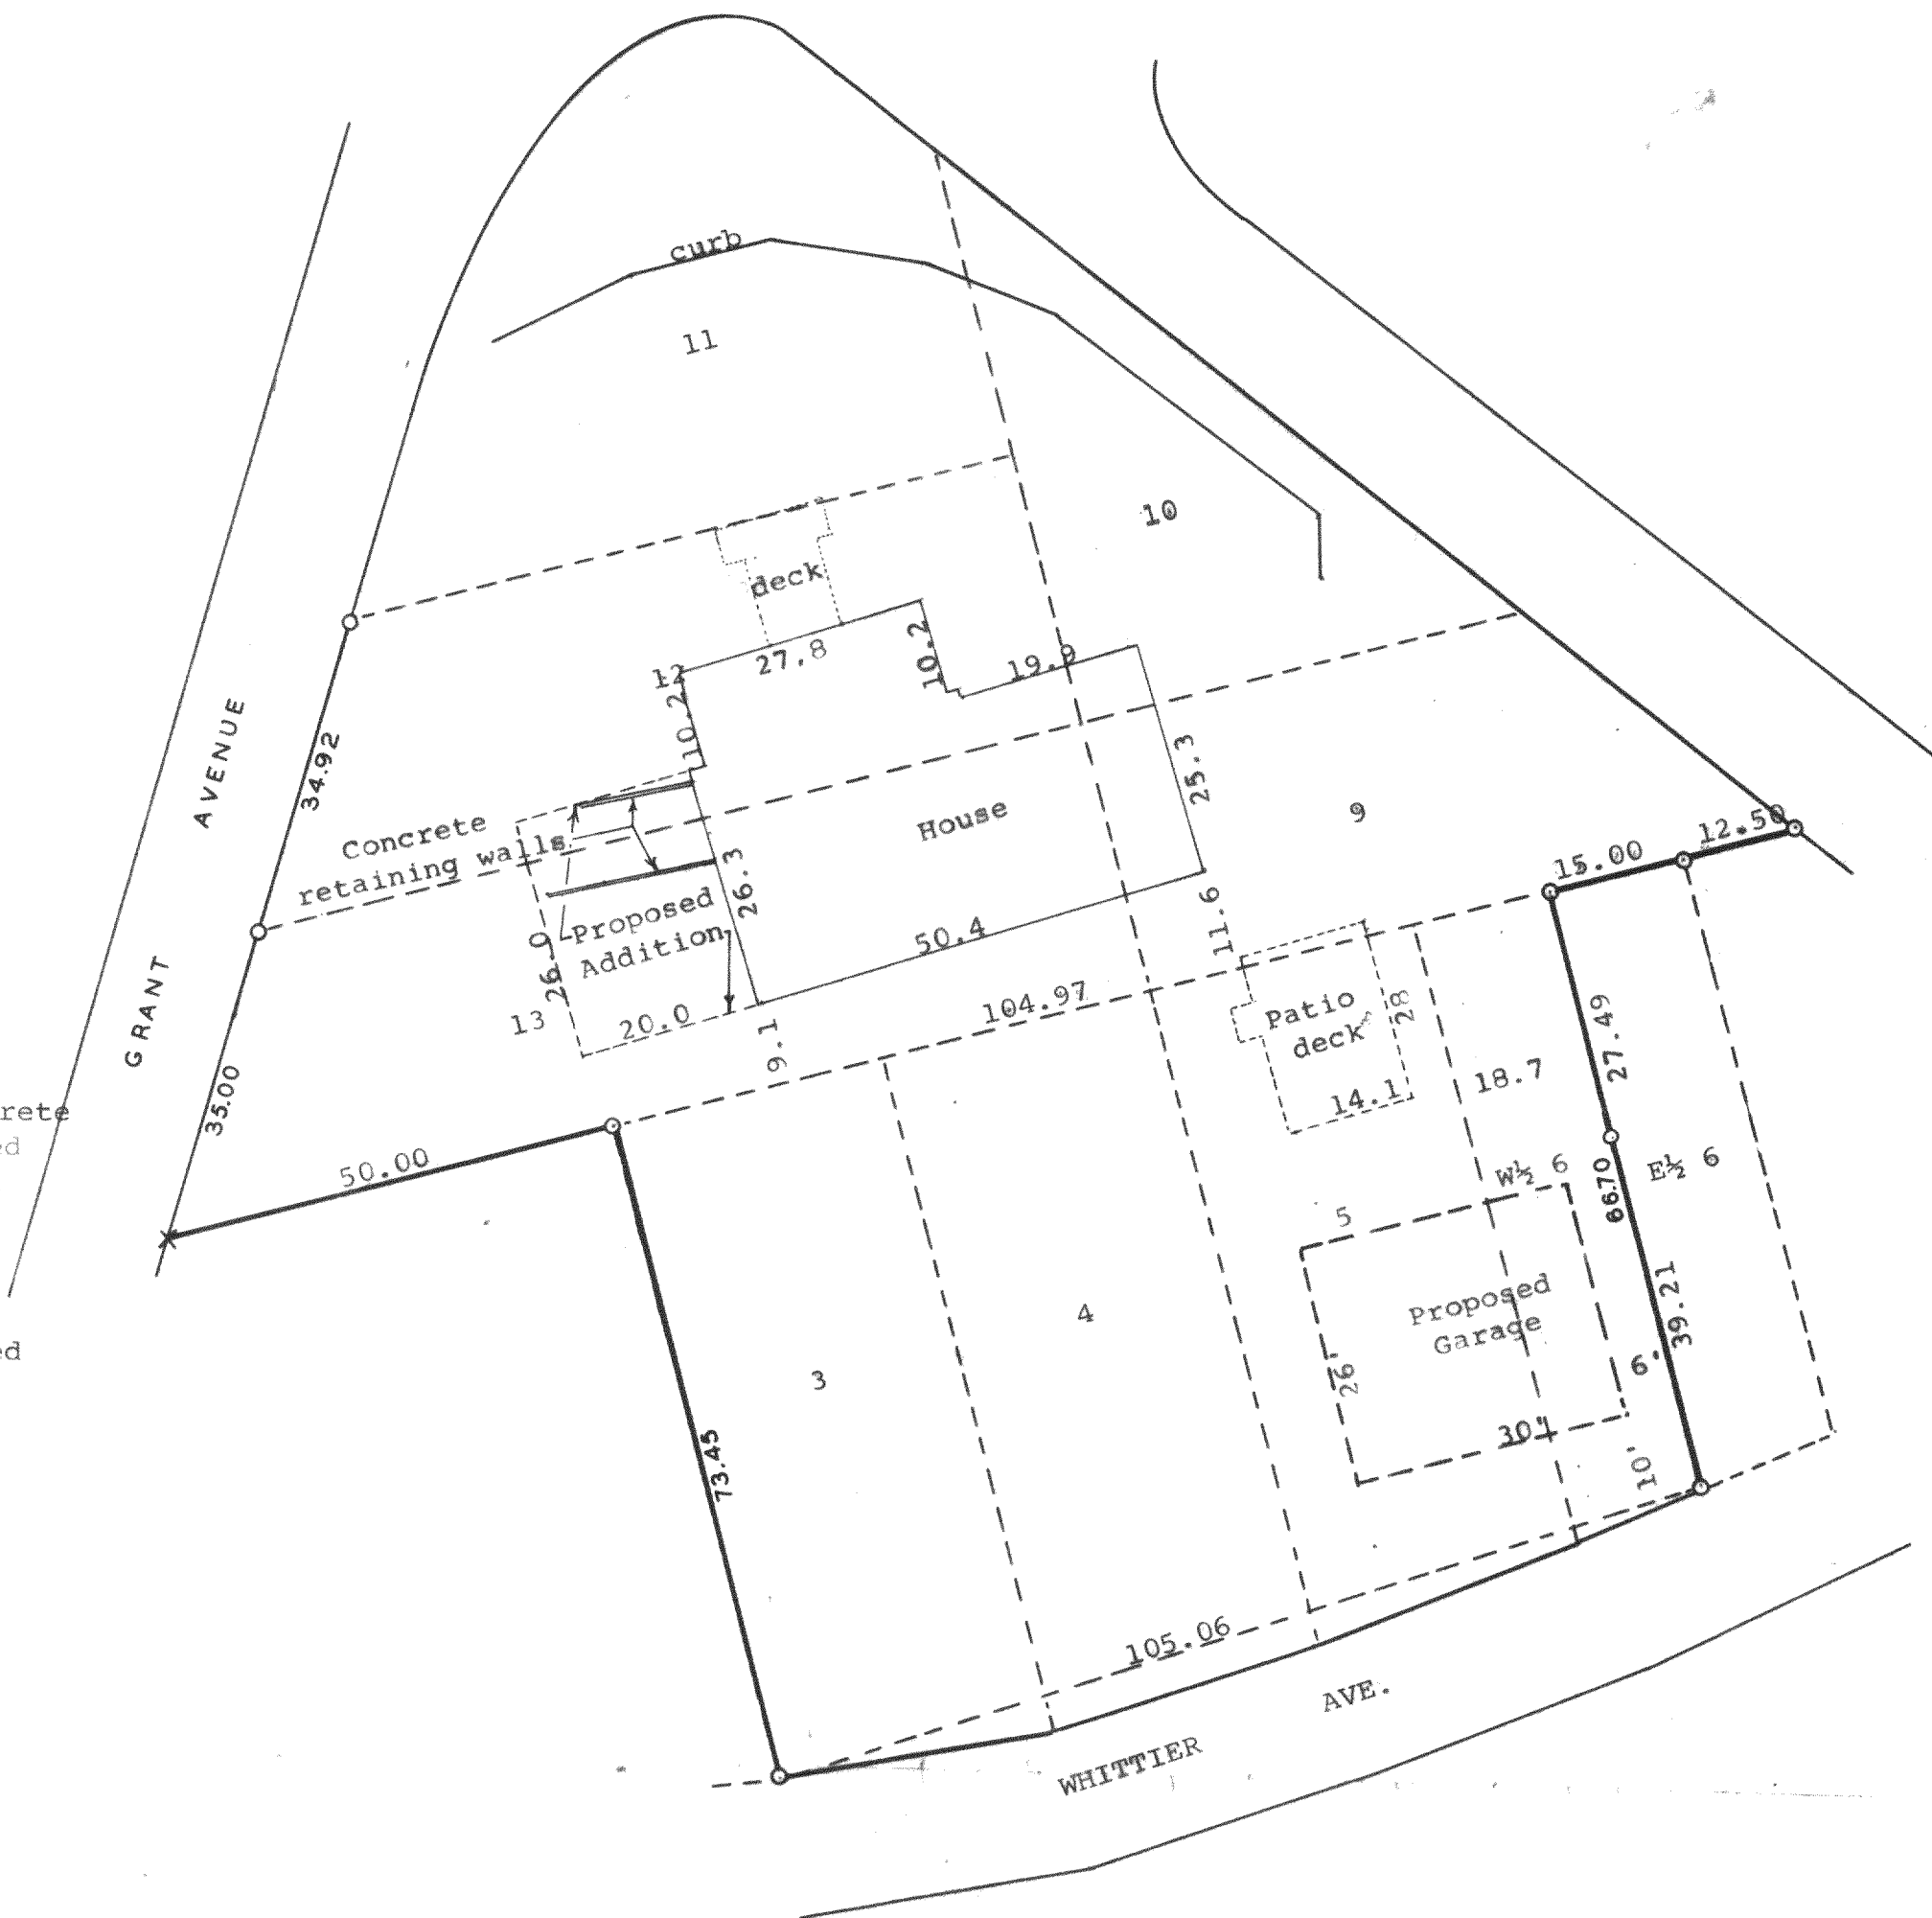

Plat of survey of Lots 3, 4, 5, West 1/2 of Lot 6, 9, 10,
11, 12, and 13 all in Block "Y" of Delavan Lake Assembly
Grounds, T 2 N, R 16 E, Walworth County, Wisconsin.
May 4, 1968
Revised 10/14/91 to show proposed
Garage location
Revised 11/4/91 to show existing
buildings.
Revised 3/6/92 to show proposed
house addition

George T. Dunham
George T. Dunham, Surveyor

