


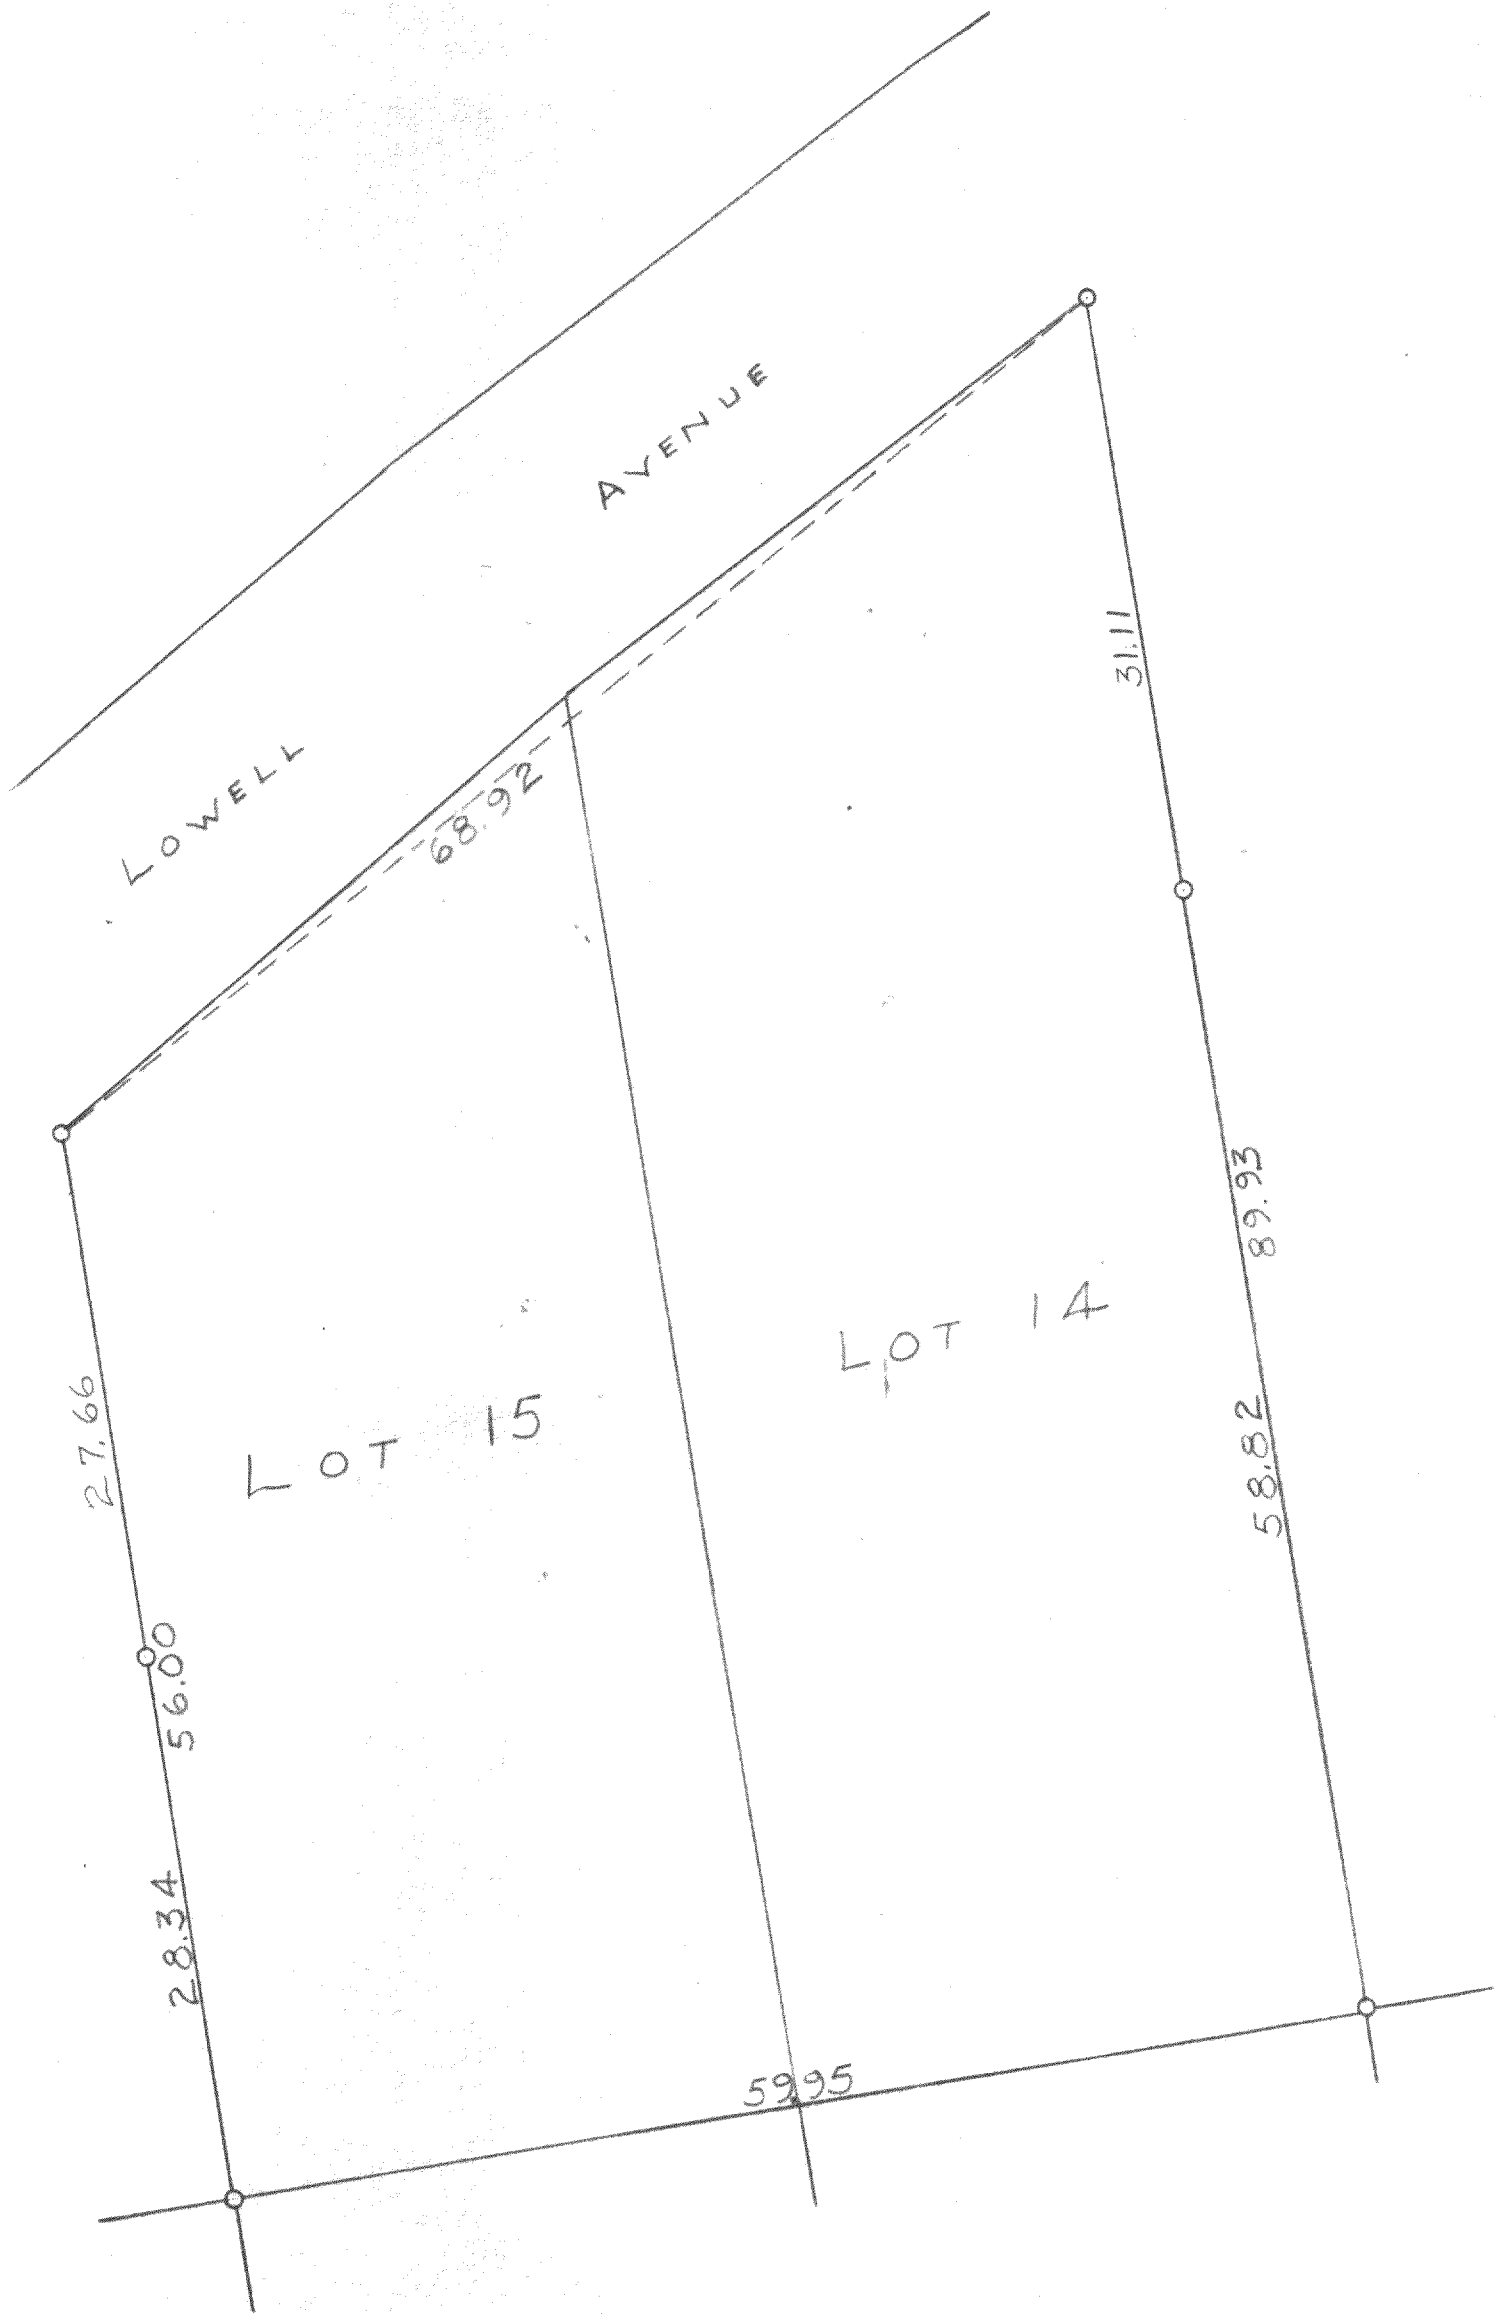

SCALE ~ 1" = 10'
O = IRON PIPE



PLAT OF SURVEY OF LOTS 14 AND 15, BLOCK "M" OF
ASSEMBLY PARK LOCATED IN SECTION 21, T2N R16E
OF WALWORTH COUNTY, WISCONSIN
SEPT. 17, 1954

216-17

George T. Dunham
GEORGE T. DUNHAM, SURVEYOR
DELAVER, WISCONSIN

FDLA-129