


GEORGE T. DUNHAM  
SURVEYING & SUBDIVIDING  
DELAVAN, WISCONSIN

N

Scale - 1" = 60'

○ = Iron Pipe

● = Concrete Monument

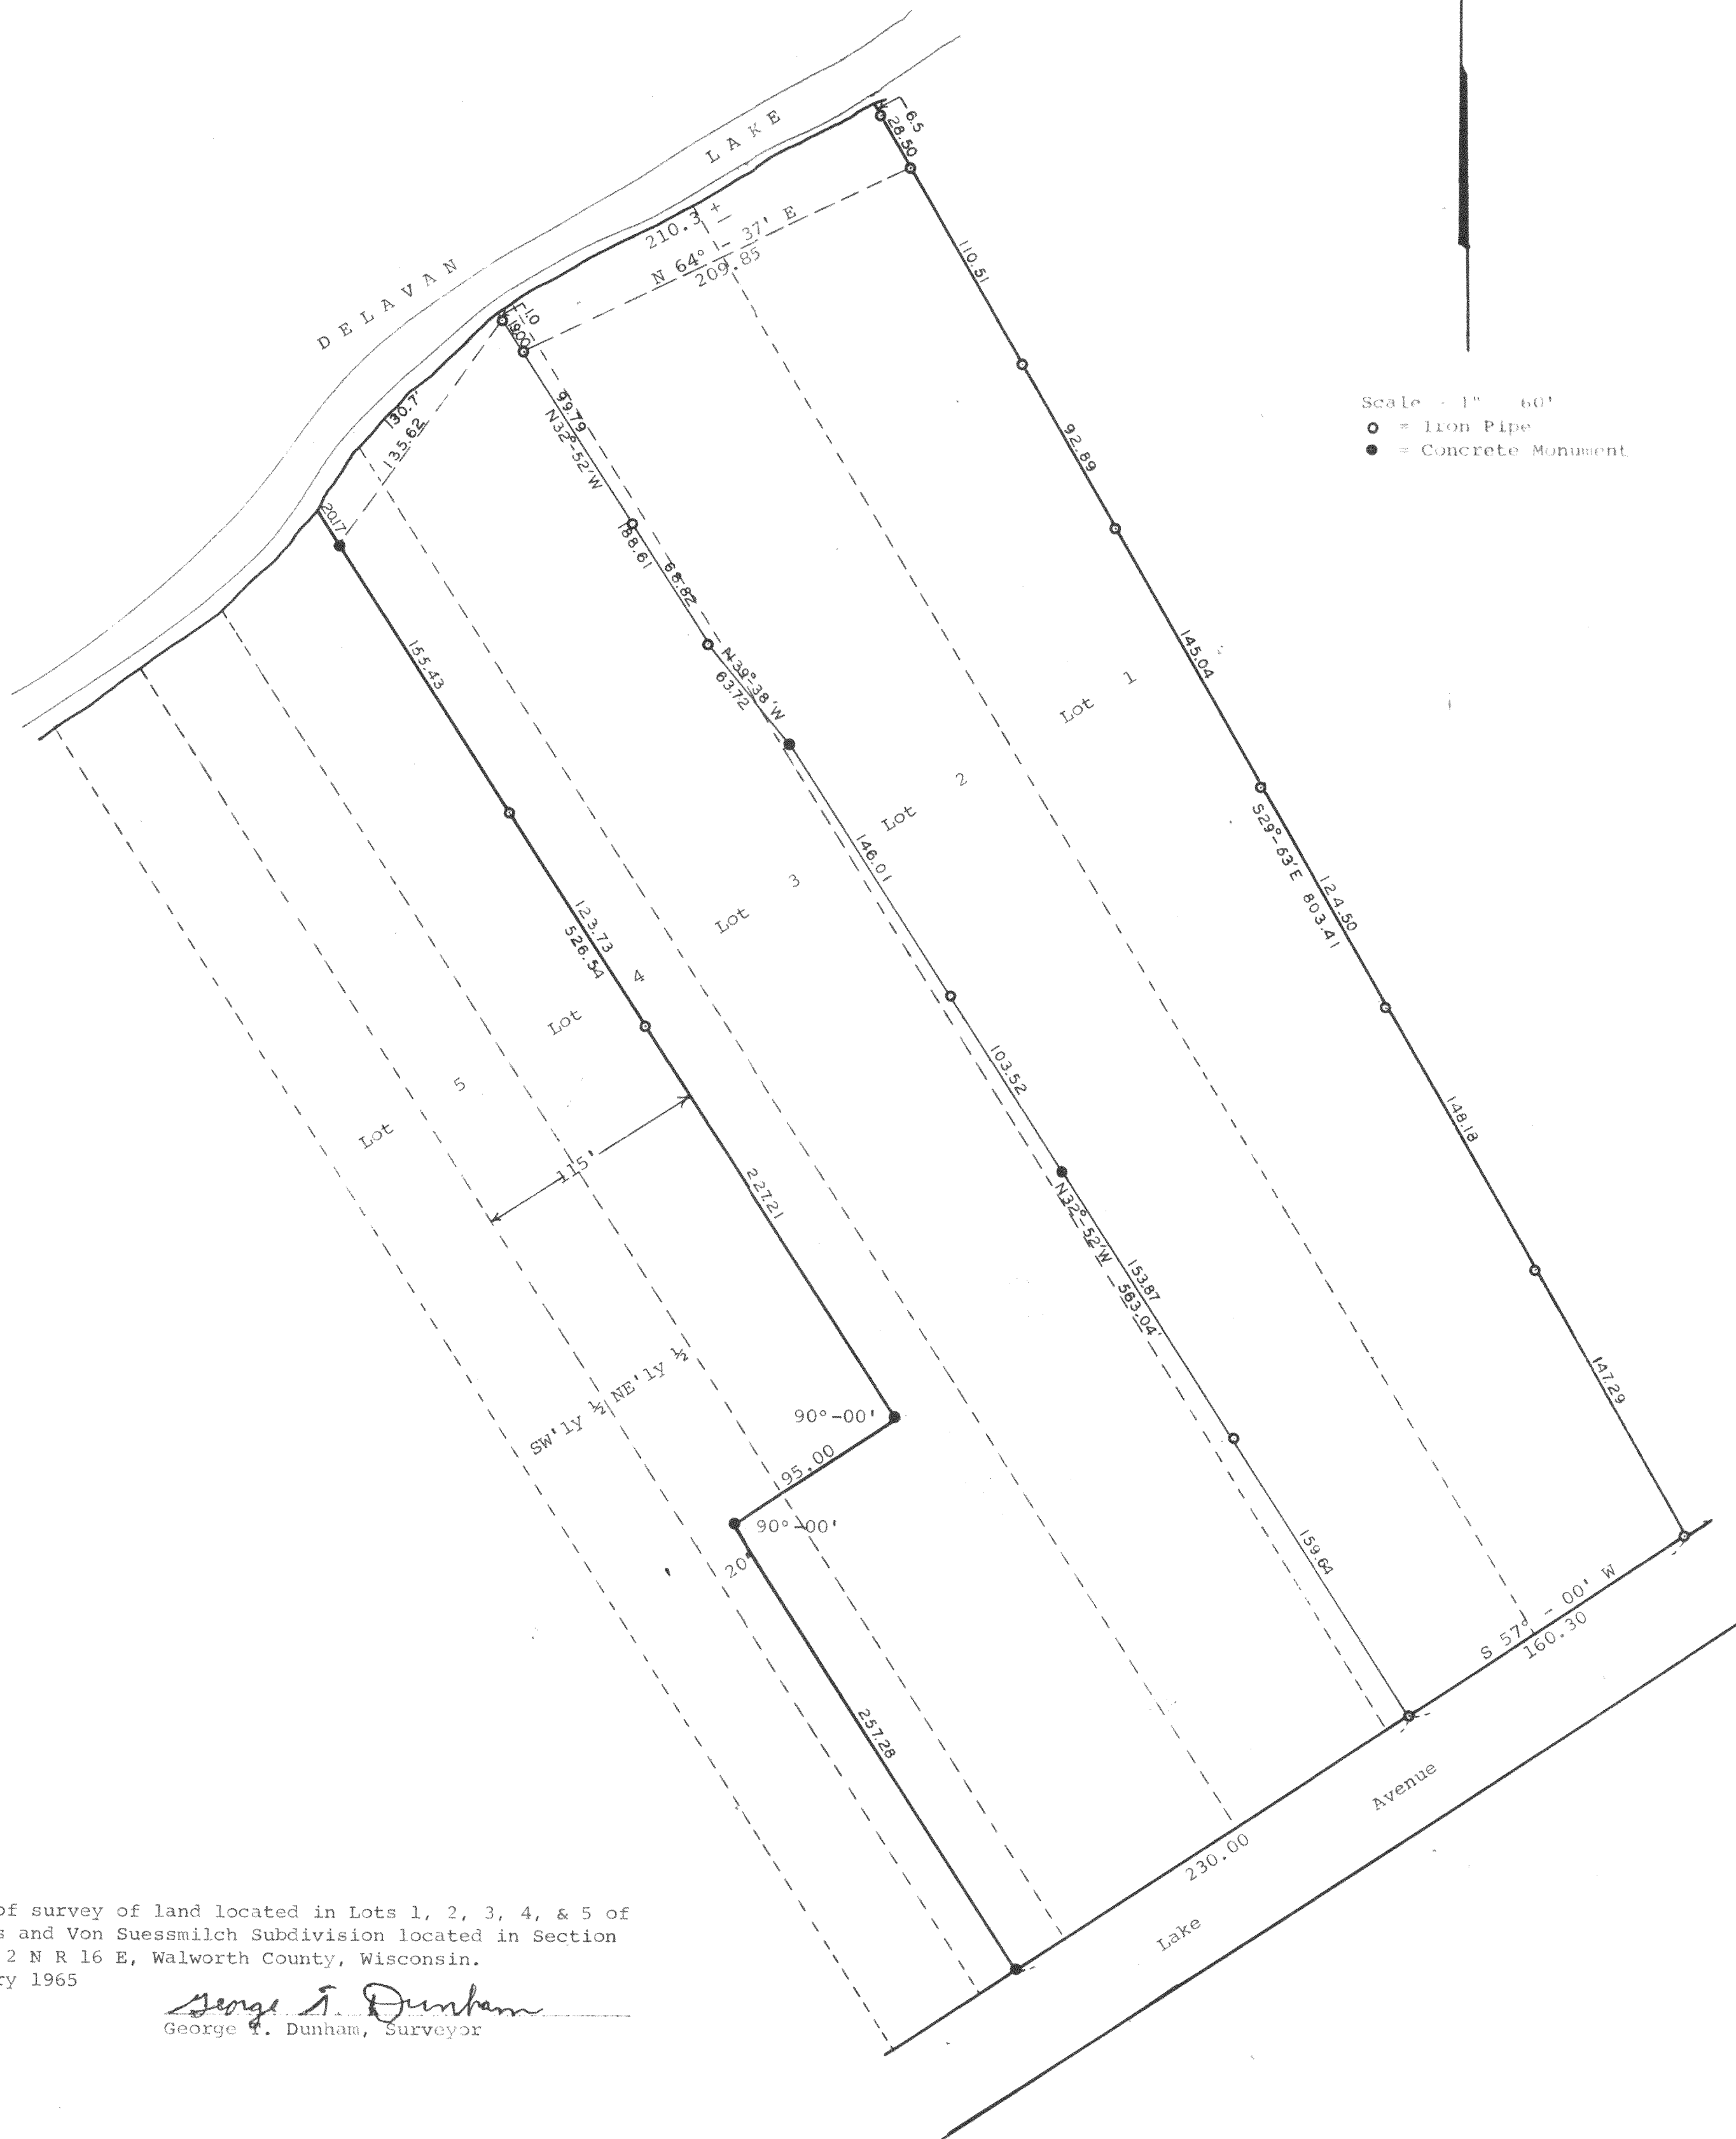

Plat of survey of land located in Lots 1, 2, 3, 4, & 5 of  
Barnes and Von Suessmilch Subdivision located in Section  
33, T 2 N R 16 E, Walworth County, Wisconsin.  
January 1965

*George T. Dunham*  
George T. Dunham, Surveyor

FBA-1

" 2

" 2A

and just Lot 1 of Cert Sur. 399