


# ABELL SURVEYING & MAPPING

DELAVAN, WISCONSIN 53115

414-728-6737

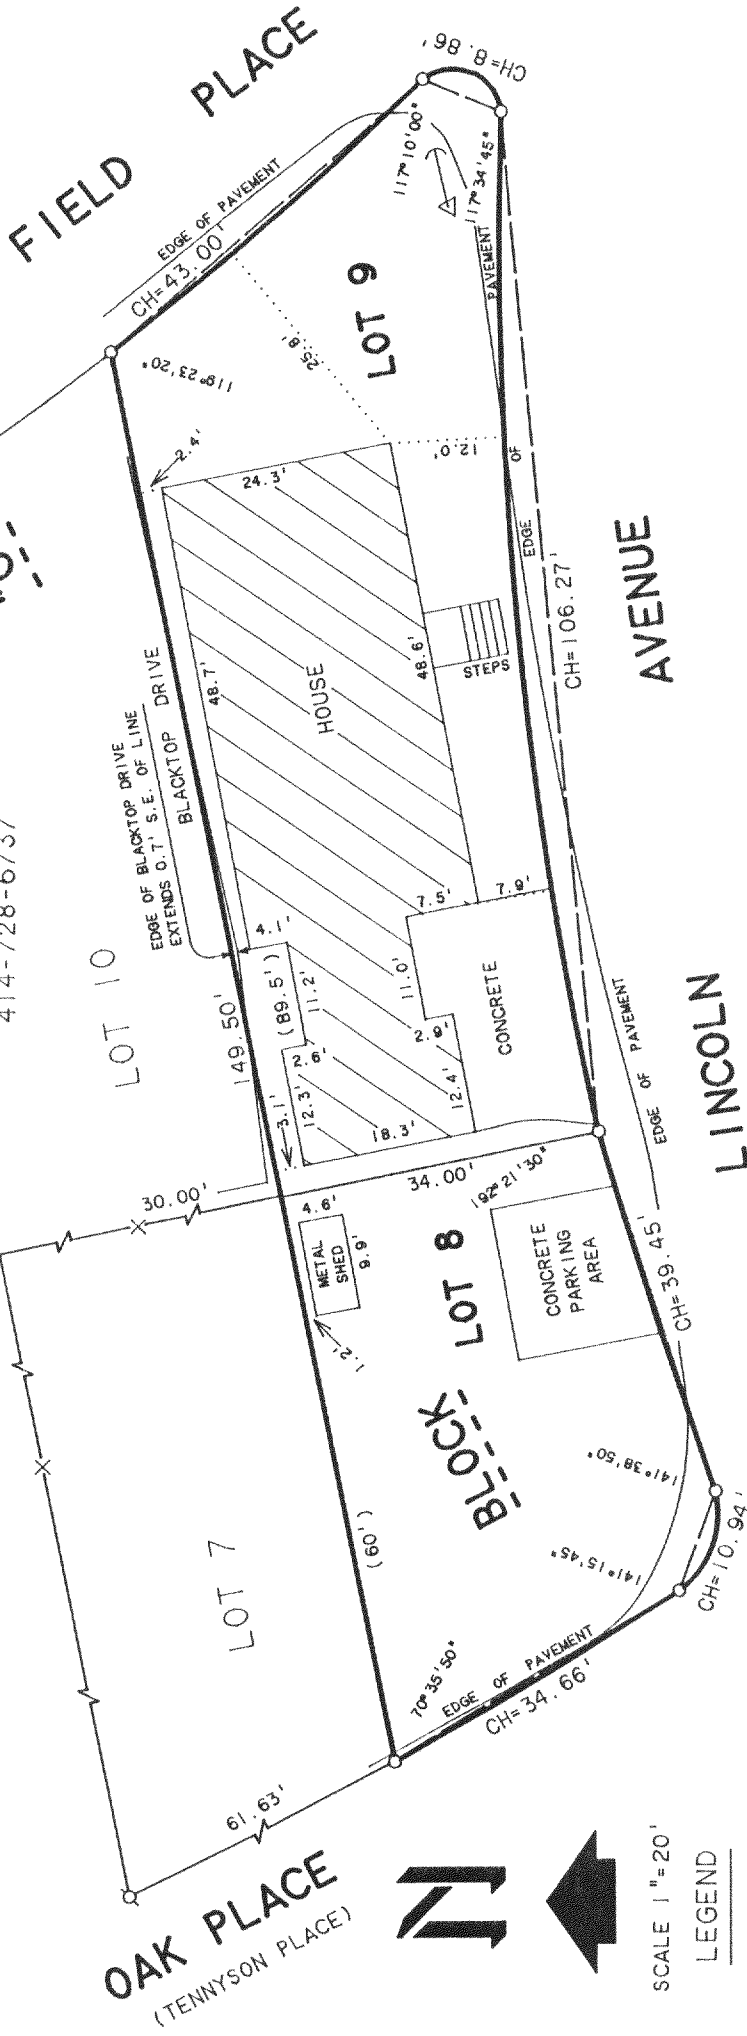

## PLAT OF SURVEY OF

LOTS 8 AND 9, BLOCK "G", DELAVAN LAKE  
ASSEMBLY GROUNDS, LOCATED IN T2N, R16E,  
WALWORTH COUNTY, WISCONSIN.



- - IRON PIPE FOUND
- ✕ - CUT CROSS IN
- - CONCRETE FOUND
- - IRON ROD SET
- △ - UTILITY POLE
- ← - UTILITY POLE ANCHOR
- ( ) - RECORDED AS

ORDERED BY: STEBNITZ BUILDERS  
P.O. BOX 526  
DELAVAN, WI 53115

I, DAVID F. ABELL, DO HEREBY CERTIFY THAT I HAVE SURVEYED THE PROPERTY HEREON DESCRIBED ACCORDING TO THE OFFICIAL RECORDS AND THAT THE PLAT HEREON IS A CORRECT REPRESENTATION OF THE PROPERTY LINES TO THE BEST OF MY KNOWLEDGE AND BELIEF.

*David F. Abell*

DAVID F. ABELL  
WISCONSIN REGISTERED LAND SURVEYOR, S-1596

*October 1, 1992*

DATE: *October 1, 1992*  
NOTE: THIS IS NOT A CERTIFIED COPY UNLESS SEALED.

216-1713

FDLA-84