

ABELL
SURVEYING & MAPPING


DELAVAN, WISCONSIN 53115

414-728-6737

LOT 13

WOOD GARBAGE
CAN
RACK
136.91' (137')

ADDITIONAL IRON PIPE
FOUND 0.49' WEST AND
0.06' SOUTH OF CORNER

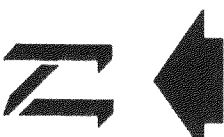

SCALE 1" = 20'

LEGEND

- IRON PIPE FOUND
- △ UTILITY POLE
- () - RECORDED AS


ORDERED BY: CLAIR LAW OFFICES, S.C.
P.O. BOX 445
DELAVAN, WI 53115

LOT 14

LOT 15

PLAT OF SURVEY OF

LOT 14, LAKEVIEW SUBDIVISION, LOCATED
IN T2N, R16E, WALWORTH COUNTY, WISCONSIN

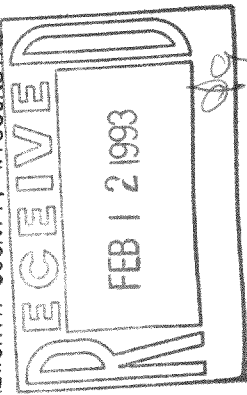

I HEREBY CERTIFY THAT I HAVE SURVEYED THE ABOVE DESCRIBED PROPERTY AND THAT THE ABOVE MAP IS A TRUE REPRESENTATION THEREOF AND SHOWS THE SIZE AND LOCATION OF THE PROPERTY, ITS EXTERIOR BOUNDARIES, THE LOCATION OF ALL VISIBLE STRUCTURES AND DIMENSIONS OF ALL PRINCIPAL BUILDINGS THEREON, BOUNDARY FENCES, APPARENT EASEMENTS, ROADWAYS AND VISIBLE ENCROACHMENTS, IF ANY, TO THE BEST OF MY KNOWLEDGE AND BELIEF.

THIS SURVEY IS MADE FOR THE USE OF THE PRESENT OWNERS OF THE PROPERTY, AND ALSO THOSE WHO PURCHASE, MORTGAGE, OR GUARANTEE THE TITLE THERETO WITHIN ONE (1) YEAR FROM DATE HEREON.

David F. Abell

DAVID F. ABELL
WISCONSIN REGISTERED LAND SURVEYOR, S-1596

November 11, 1992

DATE JOB NUMBER - 92251
NOTE: THIS IS NOT A CERTIFIED COPY UNLESS SEALED.

216-1721

FLAS-13