


DUNHAM SURVEYING, S.C.

SURVEYING & SUBDIVIDING
DELAVER, WISCONSIN 53115

Place of beginning described as being located by:
Commencing at the southeast corner of Lot 1 of
Mereness Springs Subdivision; thence S26°35'E, 49.50
feet; thence N66°25'E 111 feet; thence N38°10'E
150.96 feet; thence S25°56'E 133.34 feet

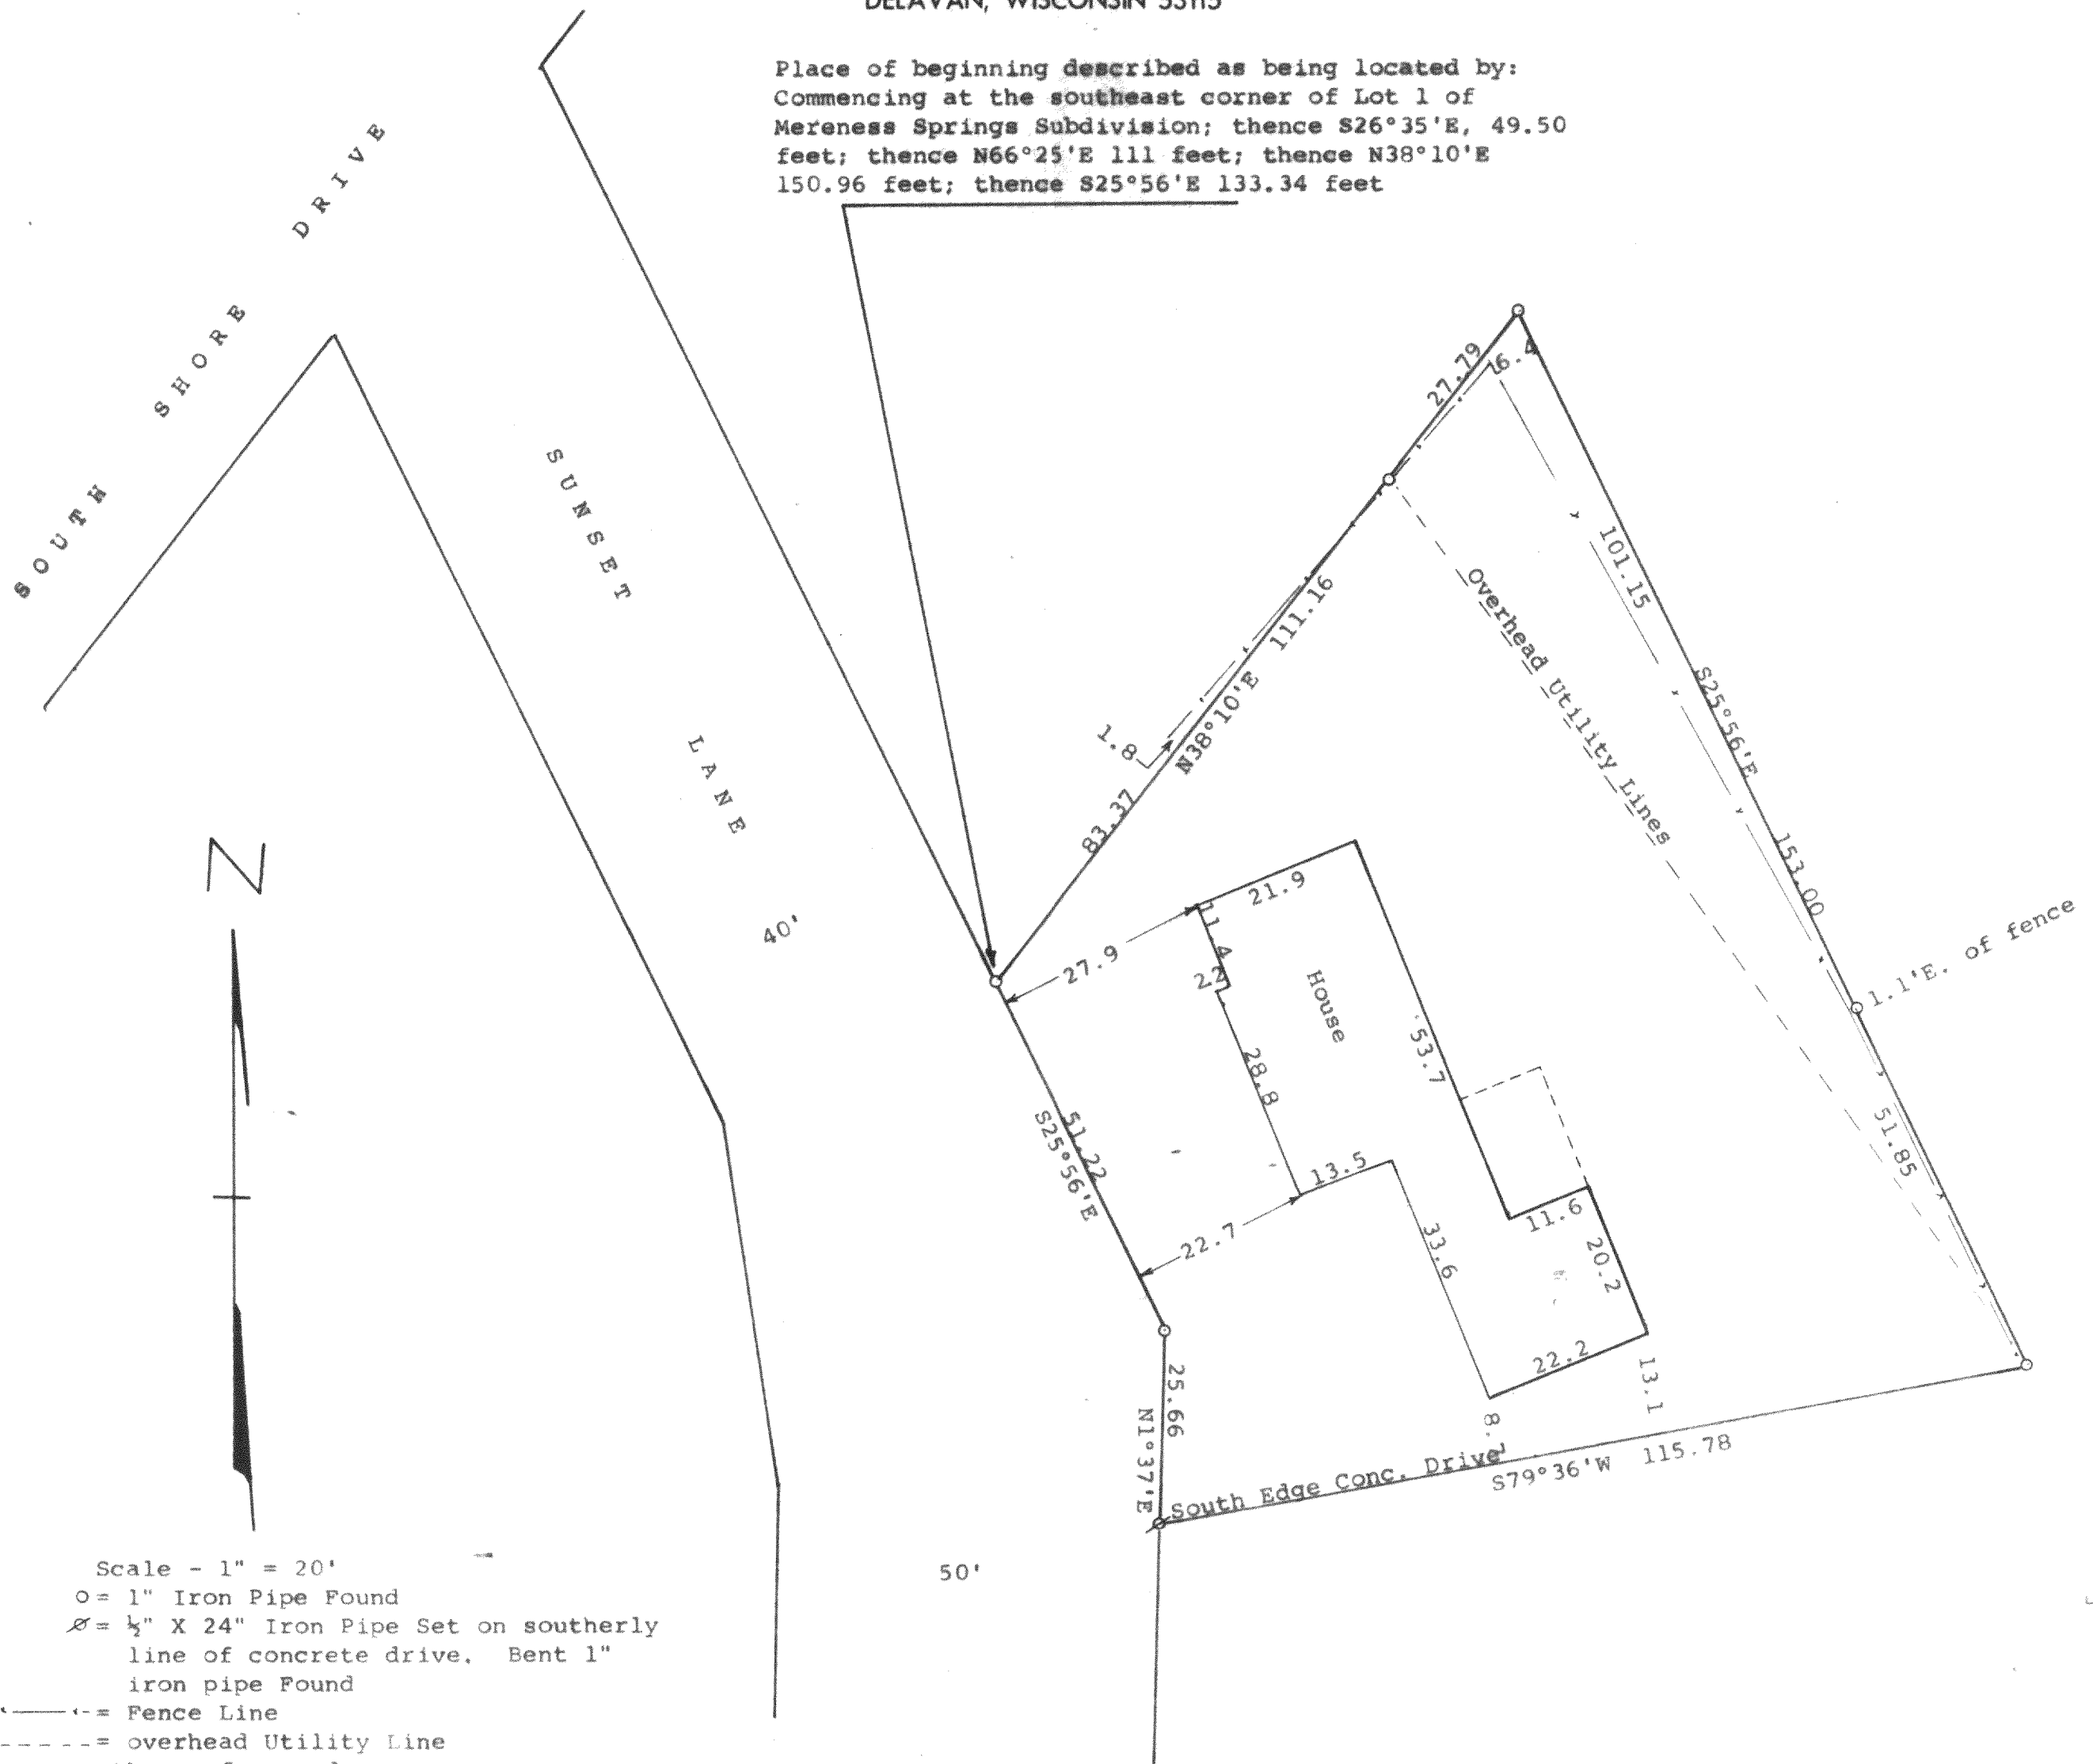

STATE OF WISCONSIN) ss
COUNTY OF WALWORTH)

I, George T. Dunham, Surveyor, certify that I have surveyed the property described as follows:

A parcel of land located in the Southeast Fractional 1/4 of Fractional Section 22, T 2 N, R 16 E, Walworth County, Wisconsin, described as follows: Commencing at the southeast corner of Lot 1, Mereness Springs Subdivision; thence S26°35'E 49.50 feet; thence N66°25'E 111.00 feet; thence N38°10'E 150.96 feet; thence S25°56'E 133.34 feet to the place of beginning; thence N38°10'E 111.16 feet; thence S25°56'E 153.00 feet; thence S79°36'W 115.78 feet; thence N1°37'E 25.66 feet; thence N25°56'W 51.22 feet to the place of beginning

and that the plat shown hereon is a correct representation thereof and shows the size and location of the property, its exterior boundaries, the location of all visible structures and dimensions of all principal buildings thereon, boundary fences, apparent easements, roadways and visible encroachments, if any, and that I have surveyed the property hereon described, according to the official records, to the best of my knowledge and belief.
December 11, 1991

George T. Dunham
George T. Dunham, Surveyor

