


GEORGE T. DUNHAM
SURVEYING & SUBDIVIDING
DELAVAN, WISCONSIN

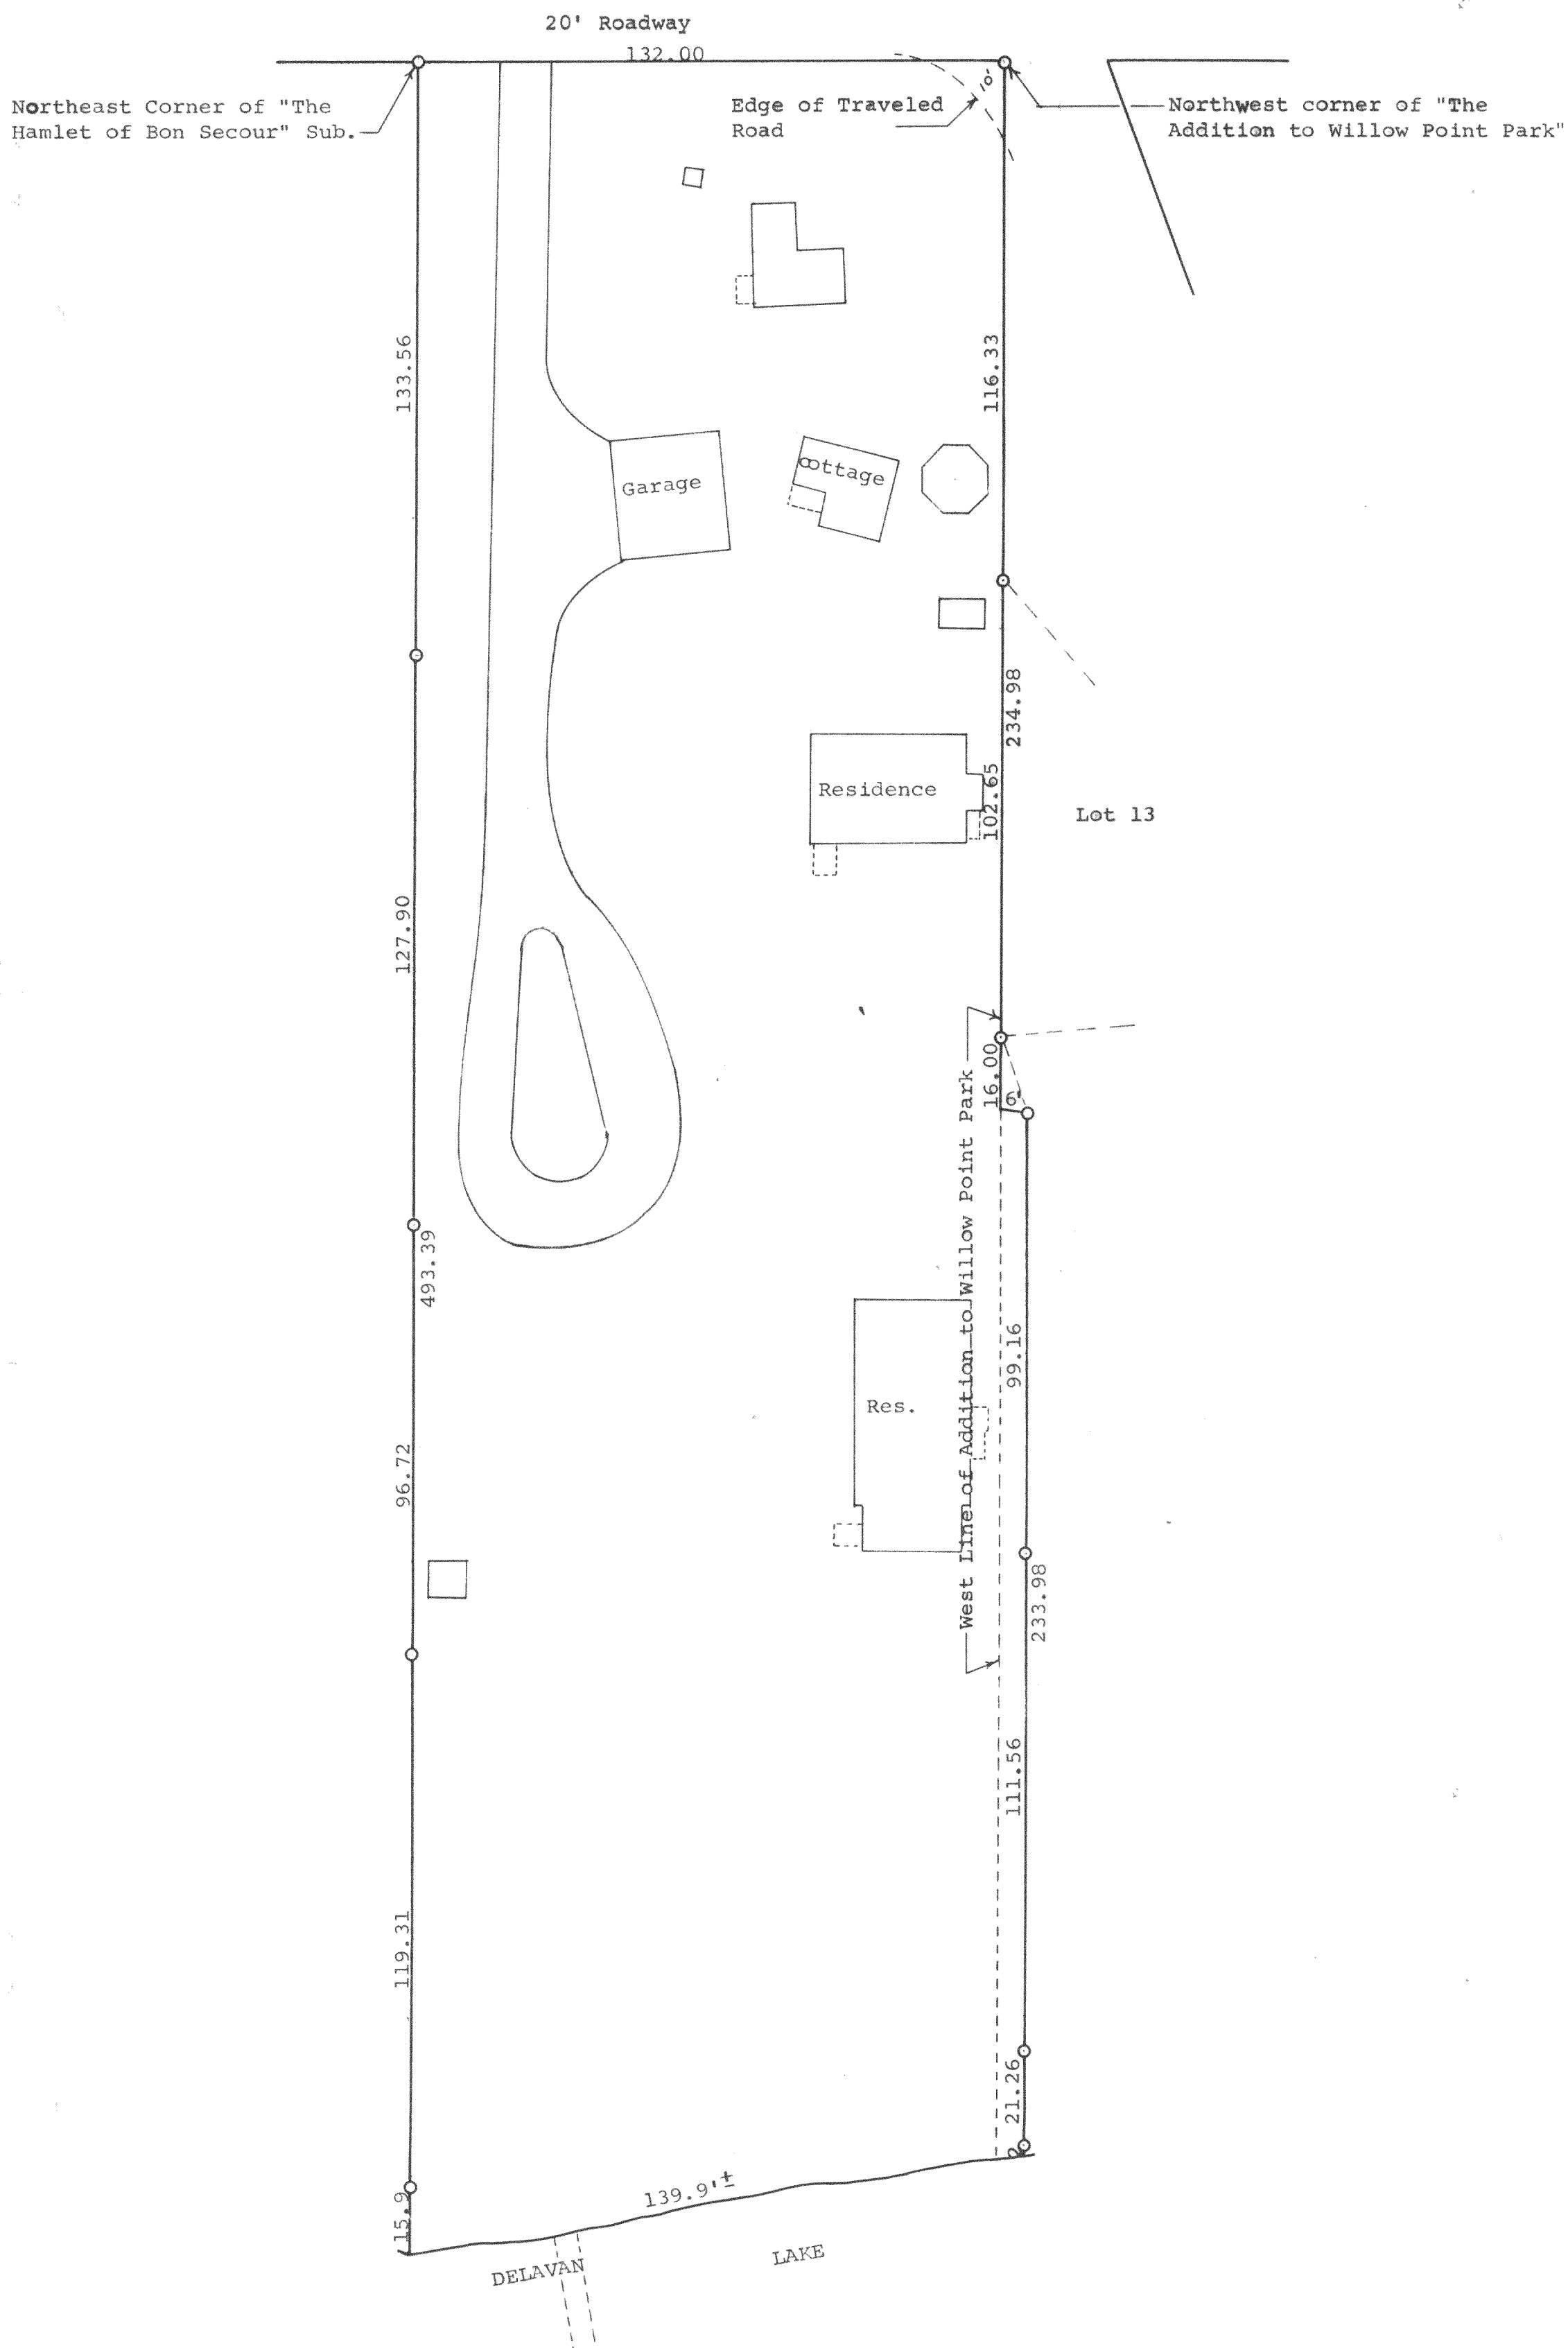

Scale - 1" = 30'
O = Iron Pipe

D-29-20

Plat of survey of parcel of land located in the Southeast 1/4 of
Section 29, T 2 N R 16 E, Walworth County, Wisconsin
July 1963
September 3, 1963 George T. Dunham
George T. Dunham, Surveyor

now C.S. 959