



ABELL
SURVEYING & MAPPING
DELAVAL, WISCONSIN 53115
414-728-6737

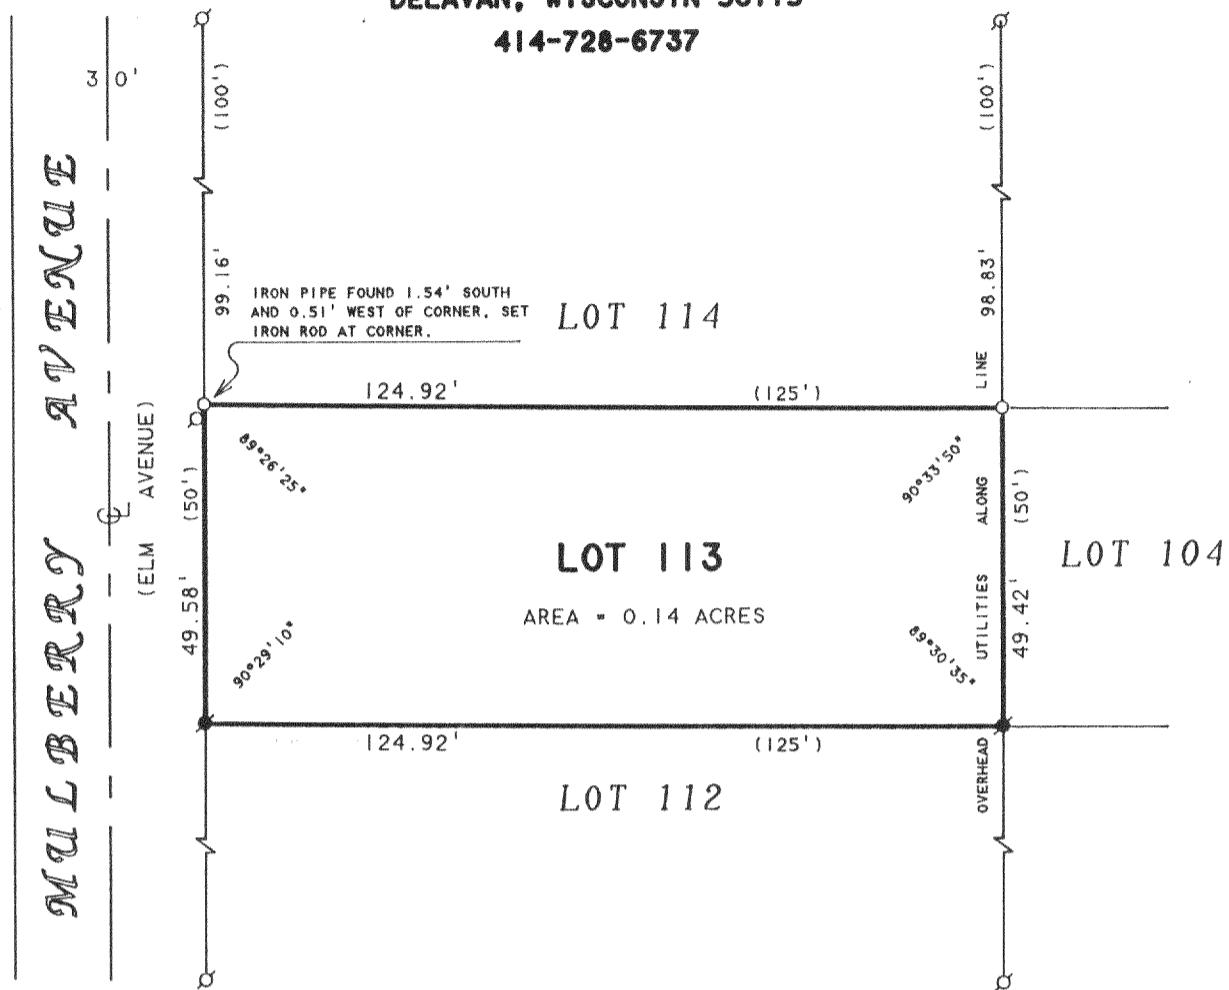

SCALE 1"=20'

LEGEND

- (○) - IRON PIPE FOUND
- (●) - IRON ROD FOUND
- (○) - IRON ROD SET
- () - RECORDED AS

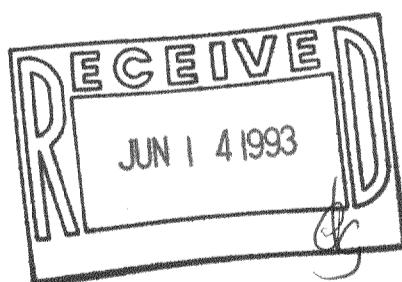

ORDERED BY: RANDALL LEECE
 P.O. BOX 318
 ELKHORN, WI 53121

I HEREBY CERTIFY THAT I HAVE SURVEYED THE ABOVE DESCRIBED PROPERTY AND THAT THE ABOVE MAP IS A TRUE REPRESENTATION THEREOF AND SHOWS THE SIZE AND LOCATION OF THE PROPERTY, ITS EXTERIOR BOUNDARIES, THE LOCATION OF ALL VISIBLE STRUCTURES AND DIMENSIONS OF ALL PRINCIPAL BUILDINGS THEREON, BOUNDARY FENCES, APPARENT EASEMENTS, ROADWAYS AND VISIBLE ENCROACHMENTS, IF ANY, TO THE BEST OF MY KNOWLEDGE AND BELIEF.

THIS SURVEY IS MADE FOR THE USE OF THE PRESENT OWNERS OF THE PROPERTY, AND ALSO THOSE WHO PURCHASE, MORTGAGE, OR GUARANTEE THE TITLE THERETO WITHIN ONE (1) YEAR FROM DATE HEREON.

David F. Abell

DAVID F. ABELL
 WISCONSIN REGISTERED LAND SURVEYOR, S-1596

March 29, 1993

DATE JOB NUMBER - 93028
 NOTE: THIS IS NOT A CERTIFIED COPY UNLESS SEALED.

FLAD-93

216-1790