


GEORGE T. DUNHAM
SURVEYING & SUBDIVIDING
DELAVAN, WISCONSIN

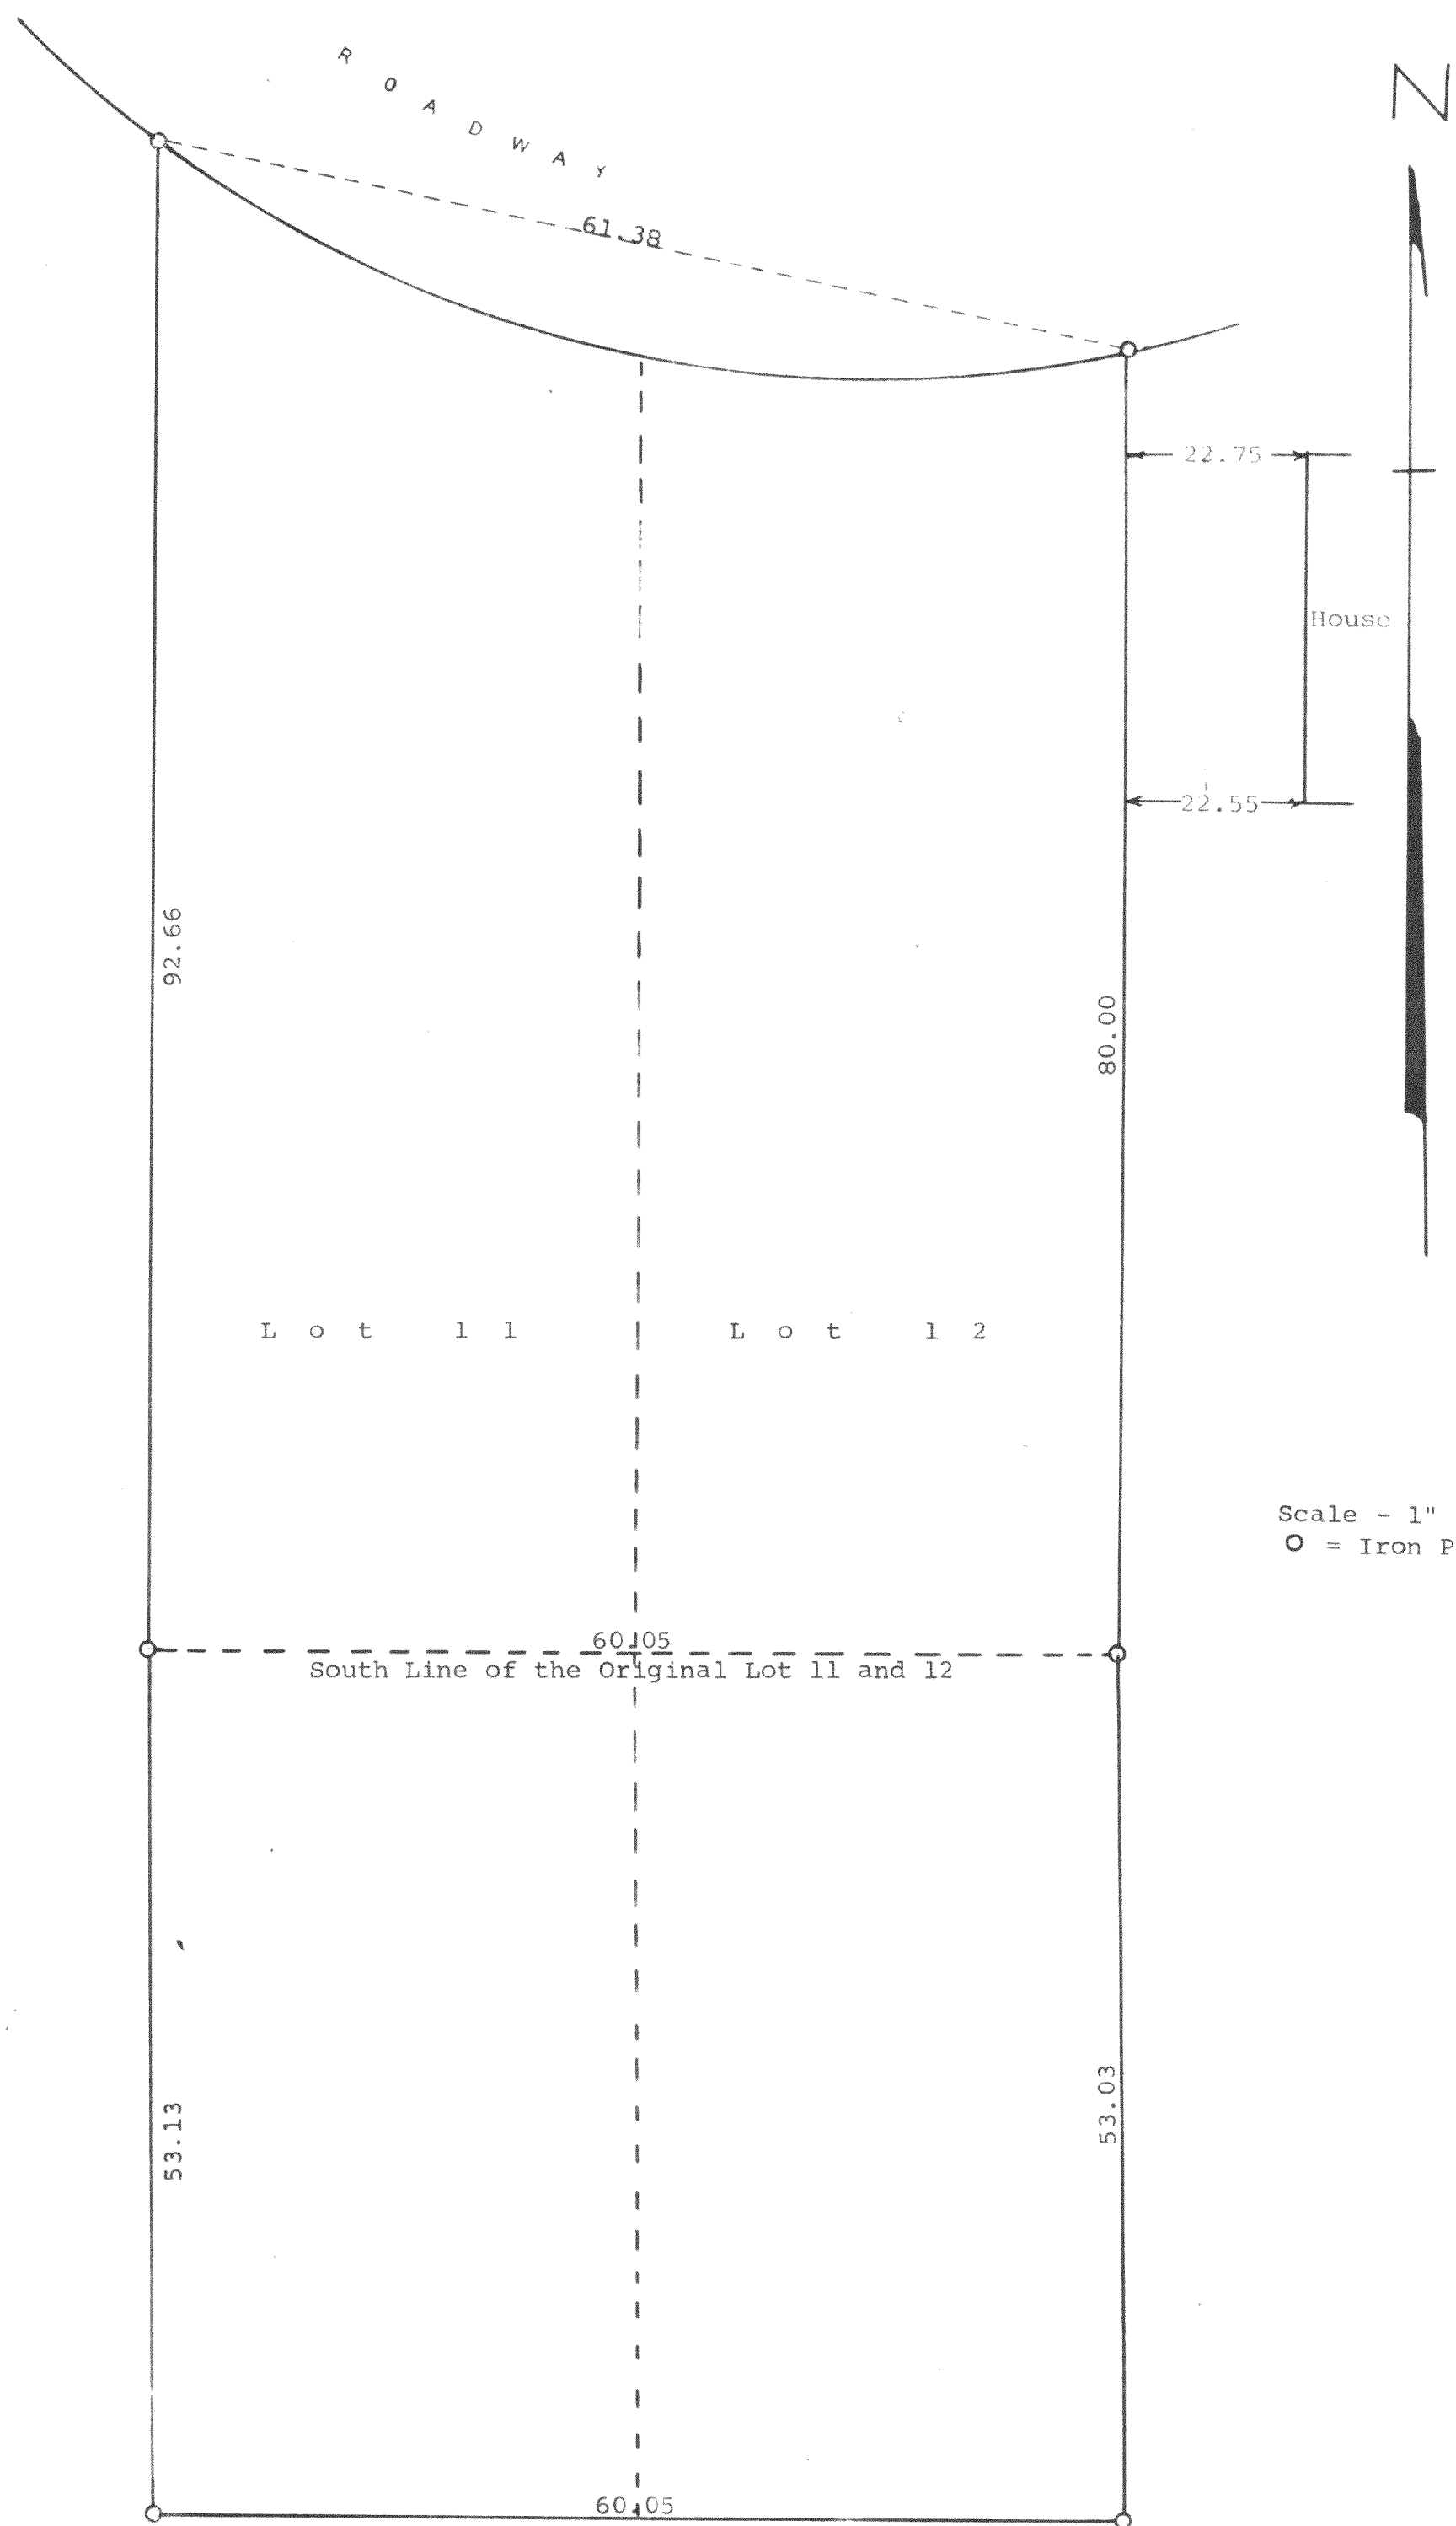

Plat of survey of Lots 11 and 12, Block "C",
Delavan Lake Assembly Grounds, located in
Section 21, T 2 N R 16 E, Walworth County, Wisc.
December 9, 1963
Resurveyed George T. Dunham
7/30/70 George T. Dunham, Surveyor

Scale - 1" = 20'
O = Iron Pipe

F 31 A-27C (RVD)