

**SURVEYING & SUBDIVIDING
DELA VAN, WISCONSIN 53115**



STATE OF WISCONSIN) SS
COUNTY OF WALWORTH)

I, James M. Dunham, Surveyor, certify that I have surveyed the property described as follows.

Lot 179 through 183 inclusive, of Krumhaar's 2nd Addition to Ravenswood, a subdivision located in Section 31, T 2 N, R 16 E, Walworth County, Wisconsin.

and the above map is a true representation thereof and shows the size and location of the property, its exterior boundaries, the location and dimensions of all structures thereon, fences, apparent easements and roadways and visible encroachments, if any.



This survey is made for the exclusive use of the present owners of the property, and also those who purchase, mortgage, or guarantee the title thereto within one (1) year from date hereof; and as to them I warrant the accuracy of said survey and map.

November 14, 1978

Updated and recertified to this
4th day of May, 1993

James M. Dunham
James M. Dunham, Surveyor

George T. Dunham
George T. Dunham, Surveyor

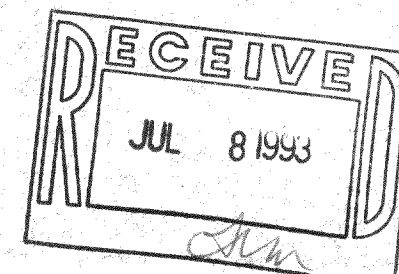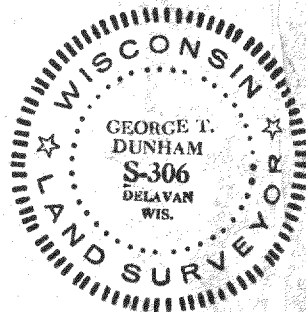

FRA2-61