


GEORGE T. DUNHAM
 SURVEYING & SUBDIVIDING
 DELAVAN, WISCONSIN

N

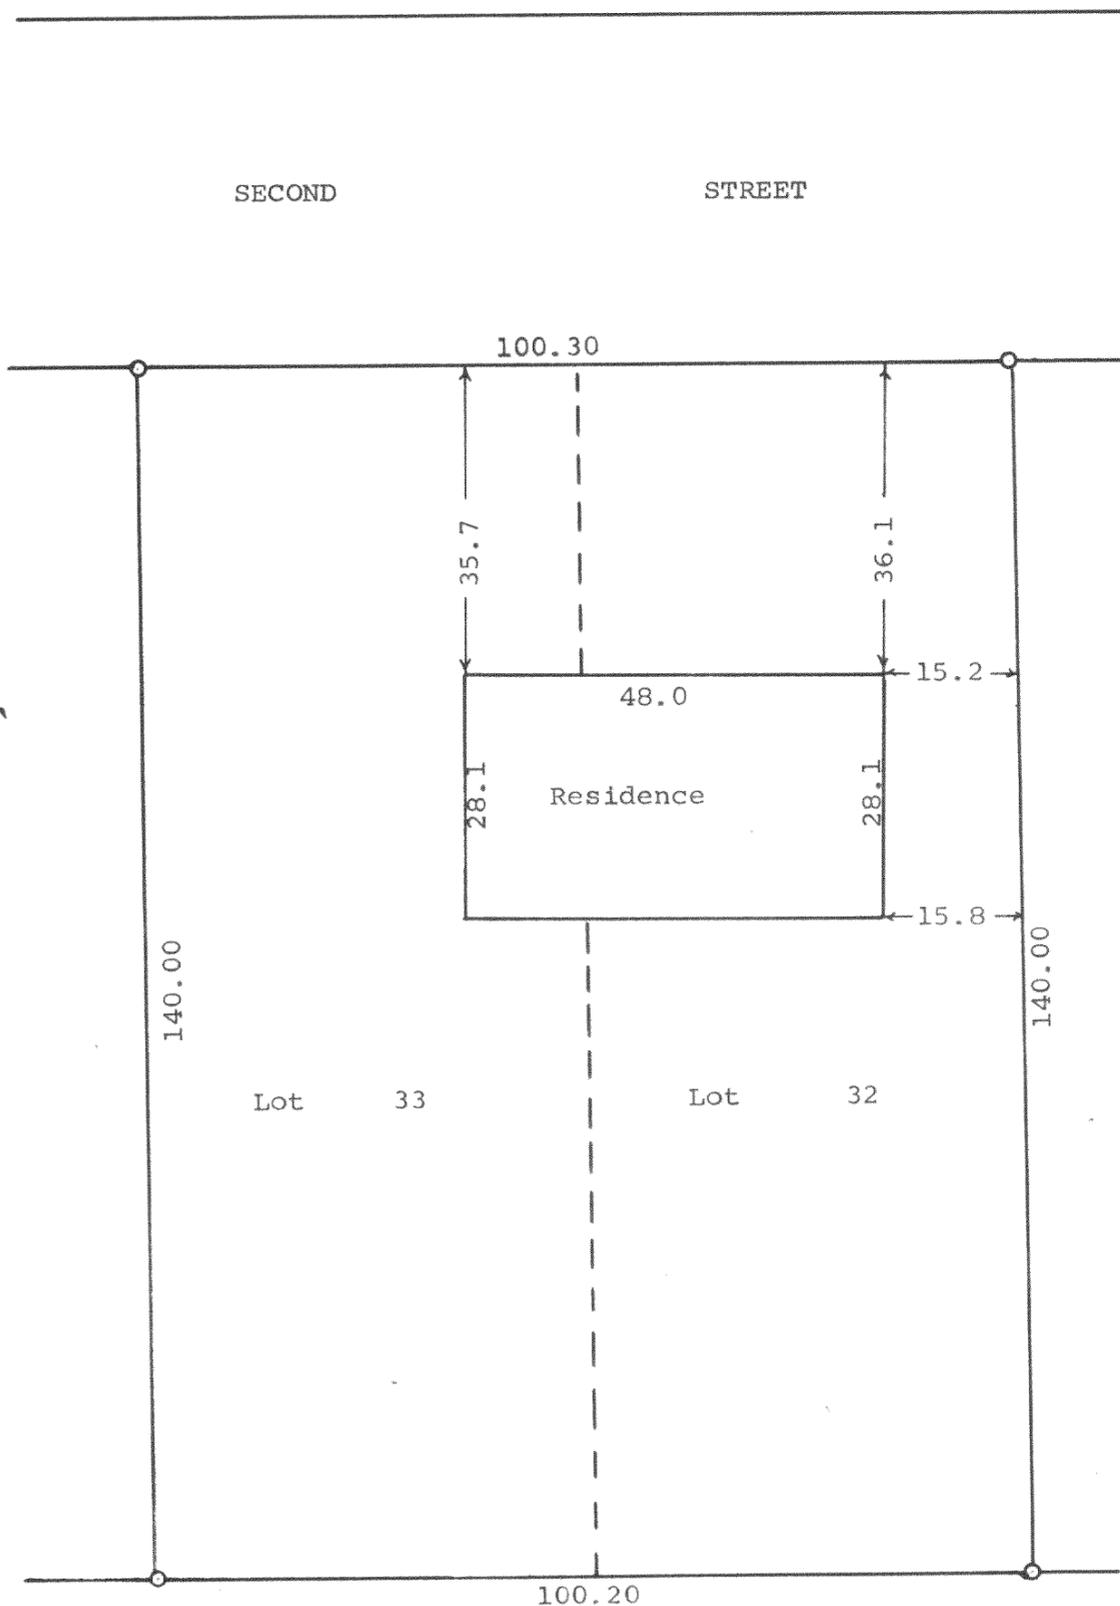

Scale - 1" = 20'
 O = Iron Pipe

STATE OF WISCONSIN)
 WALWORTH COUNTY) SS

I, George T. Dunham, surveyor, do hereby certify that I have surveyed the property described as follows, Lots 32 and 33 in Block No. 2 of Inlet Oaks Subdivision No. 3 located in the Town of Delavan, Walworth County, Wisconsin.

and that the plat shown above is an accurate survey and a true representation thereof and correctly shows the exterior boundary lines and the location of the buildings and other improvements on said property and the correct measurements thereof.
 October 10, 1963

George T. Dunham
 George T. Dunham, Surveyor

216-189