


PLAT OF SURVEY

20' Wide
(Byrant Avenue)
Evergreen Street

Set Railroad Spike is 1.1'±
from edge of Blacktop.

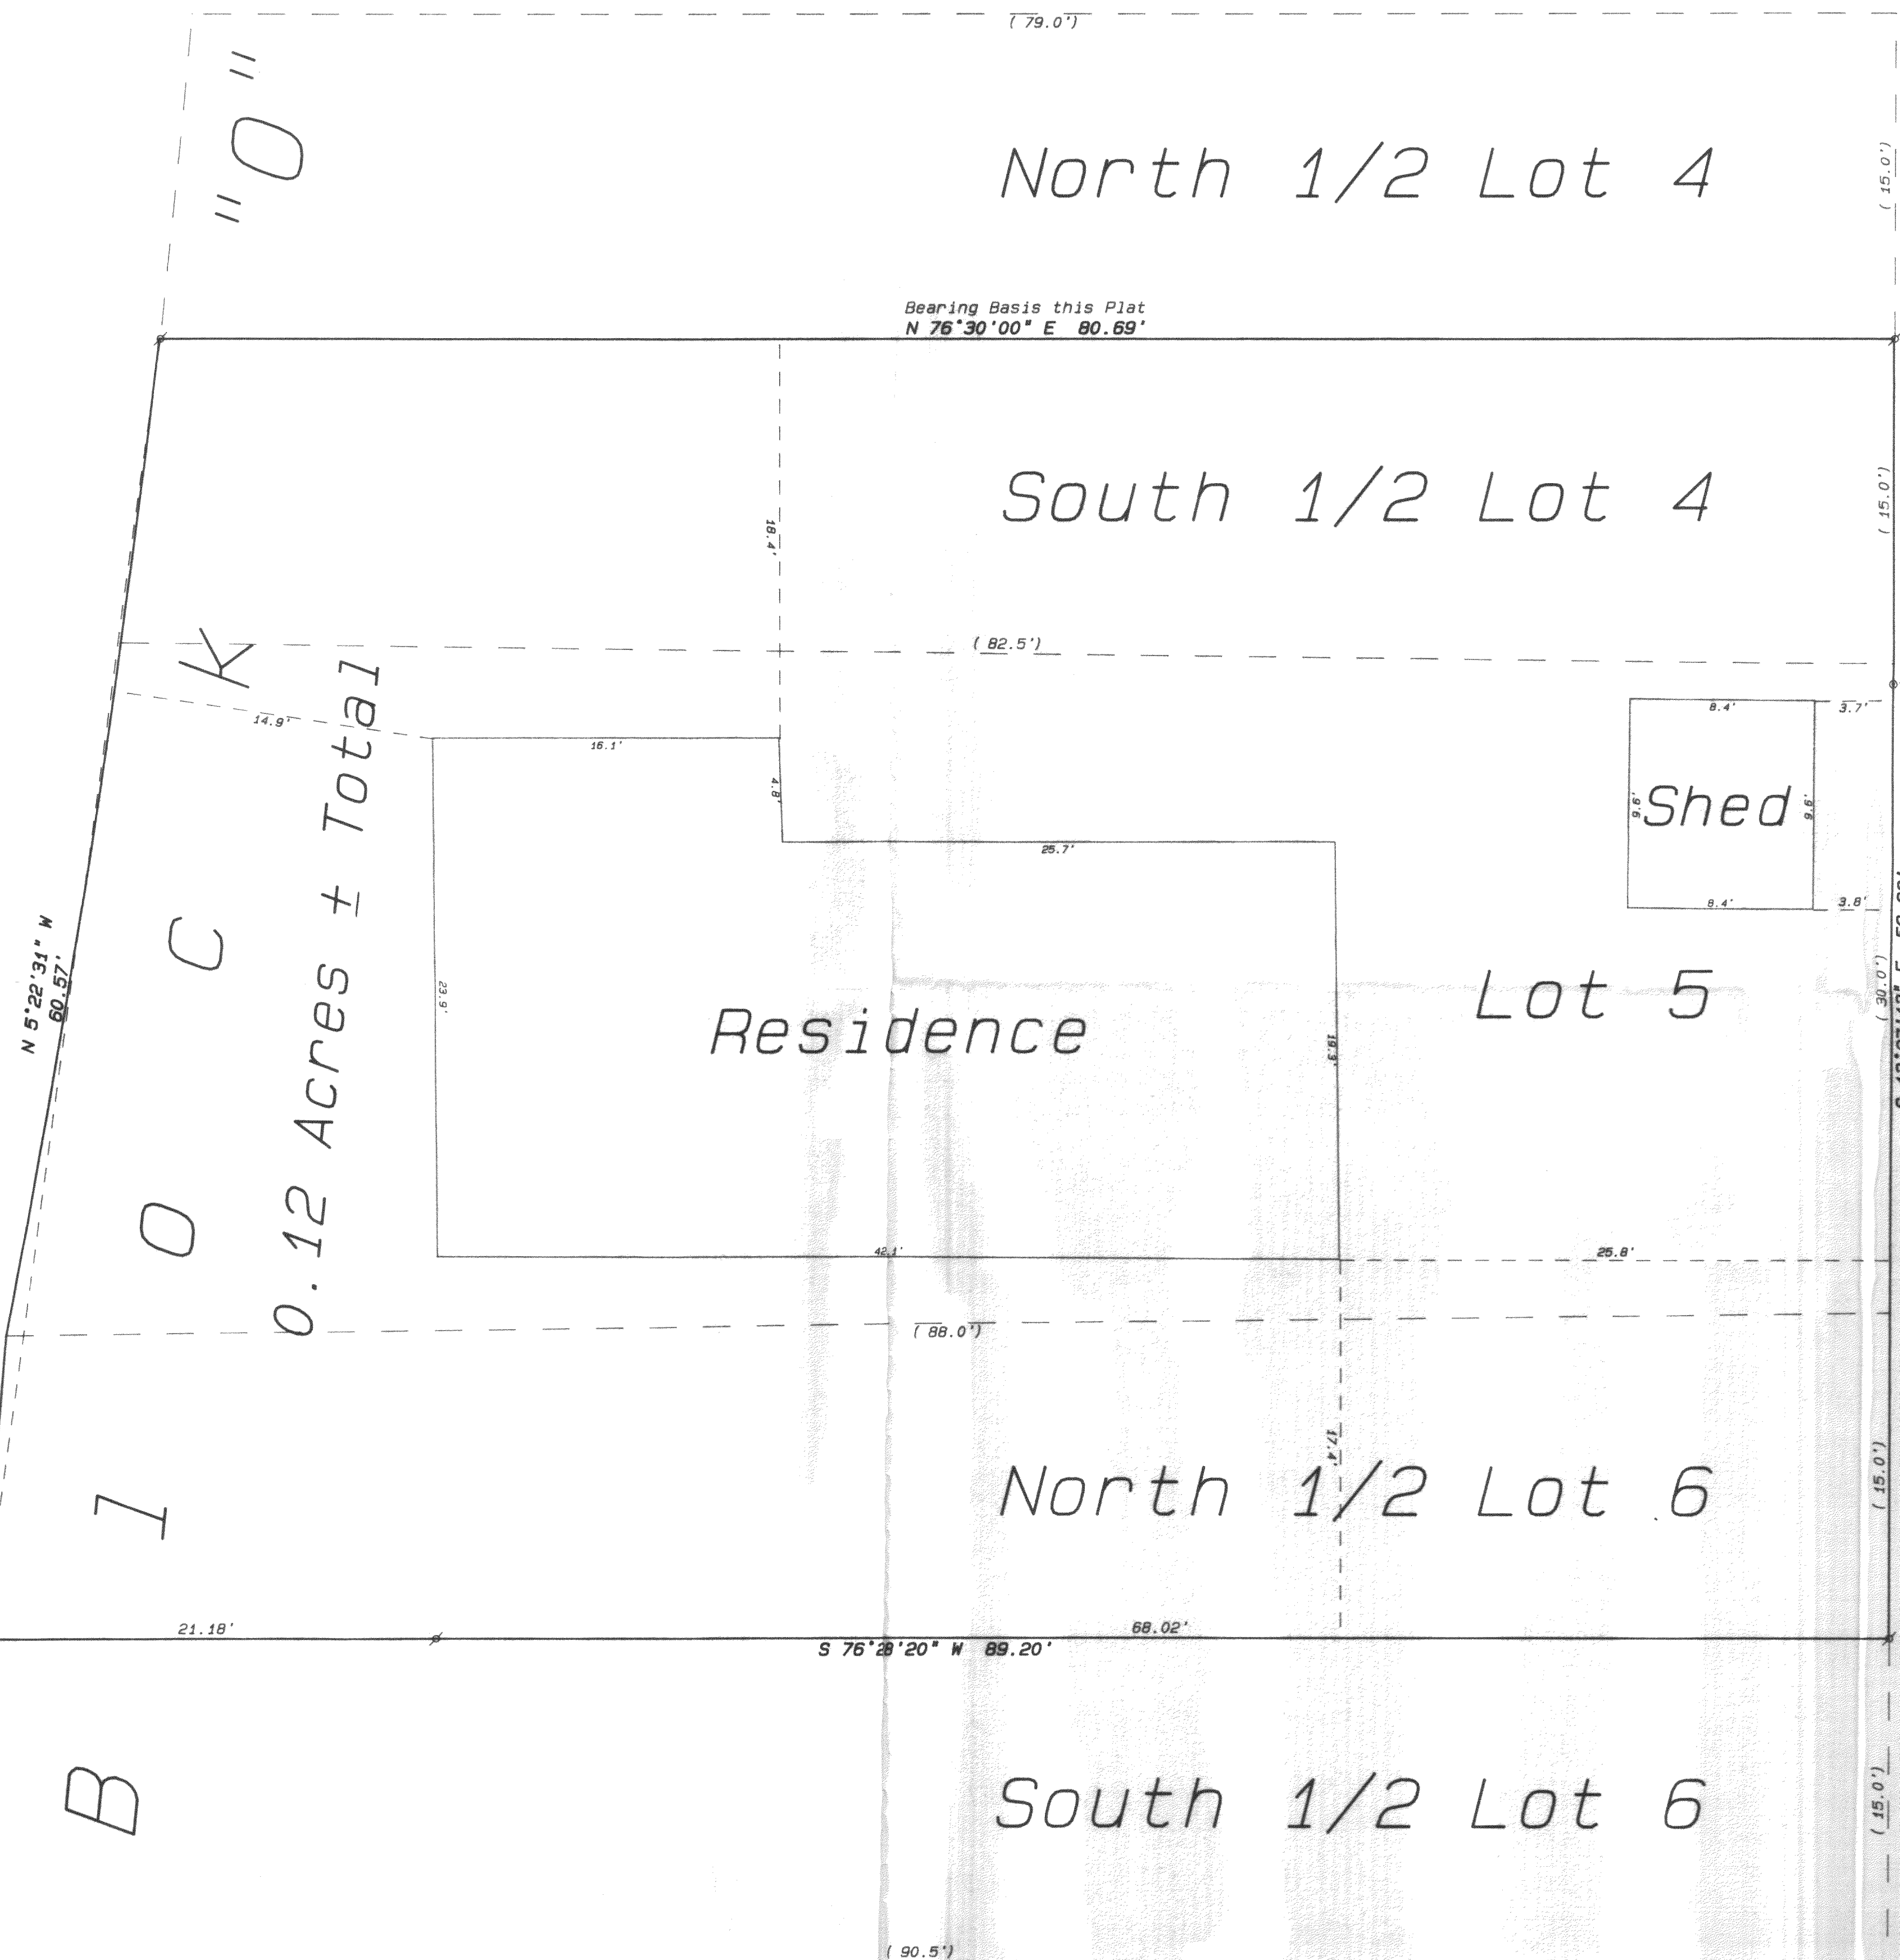


The South 1/2 of Lot 4, Lot 5, and the North 1/2 of Lot 6 of Block 0 of the recorded Plat of Delavan Lake Assembly Grounds, located in the Southeast 1/4 of Section 21, Town 2 North, Range 16 East, Town of Delavan, County of Walworth, State of Wisconsin.

Note

The North Line of the South 1/2 of Lot 4 was assumed to bear N 76°30'00" E as shown on previous Plats of Survey by George T. Dunham, Wisconsin Registered Land Surveyor #S-306, Dated September 28, 1967 and November 19, 1984. The Original Plat of Delavan Lake Assembly Grounds shows no curve data for the road right-of-way lines, the curve shown on this plat was drafted from the aforesaid surveys of record.


Owner: Mary Michalak
2829 Edgington Street
Franklin Park, Illinois 60131

Ordered by: Goodman & Witanen
Attorneys at Law
1030 Higgins Road, Suite 220
Park Ridge, Illinois 60068

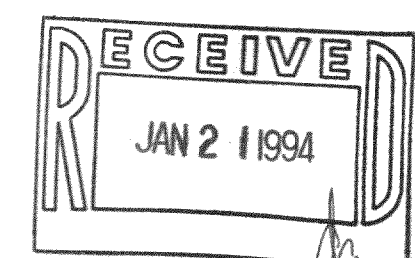

Legend

- FOUND IRON PIPE
- FOUND IRON ROD
- FOUND BRASS CAPPED MONUMENT
- FOUND CONCRETE MONUMENT
- CHISEL CUT IN CONCRETE
- SET IRON ROD, 24" LONG, WEIGHING 1.5 LBS./LINEAL FT., 3/4" DIA.
- SET IRON ROD, 30" LONG, WEIGHING 4.5 LBS./LINEAL FT., 1-11/16" DIA.
- RECORDED AS DIMENSION
- EXISTING FENCE

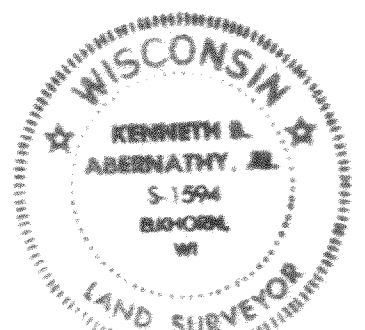

SCALE: 1"= 5 FEET

I hereby certify that the above described property has been surveyed by me or under my direction and that the above map is a true representation thereof and shows the size and location of the property, its exterior boundaries, the location of all visible structures and dimensions of all principal buildings thereon, boundary fences, apparent easements, roadways and visible encroachments, if any.
This survey is made for the use of the present owners of the property, and also those who purchase, mortgage, or guarantee the title thereto within one year from date hereof.

Kenneth B. Abernathy, Jr.
KENNETH B. ABERNATHY, JR.
WISCONSIN REGISTERED LAND SURVEYOR,
S-1594

Date: December 17, 1993 Job No. 1993.1206