


ABELL
SURVEYING & MAPPING
DEHAVAN, WISCONSIN 53115
414-728-6737

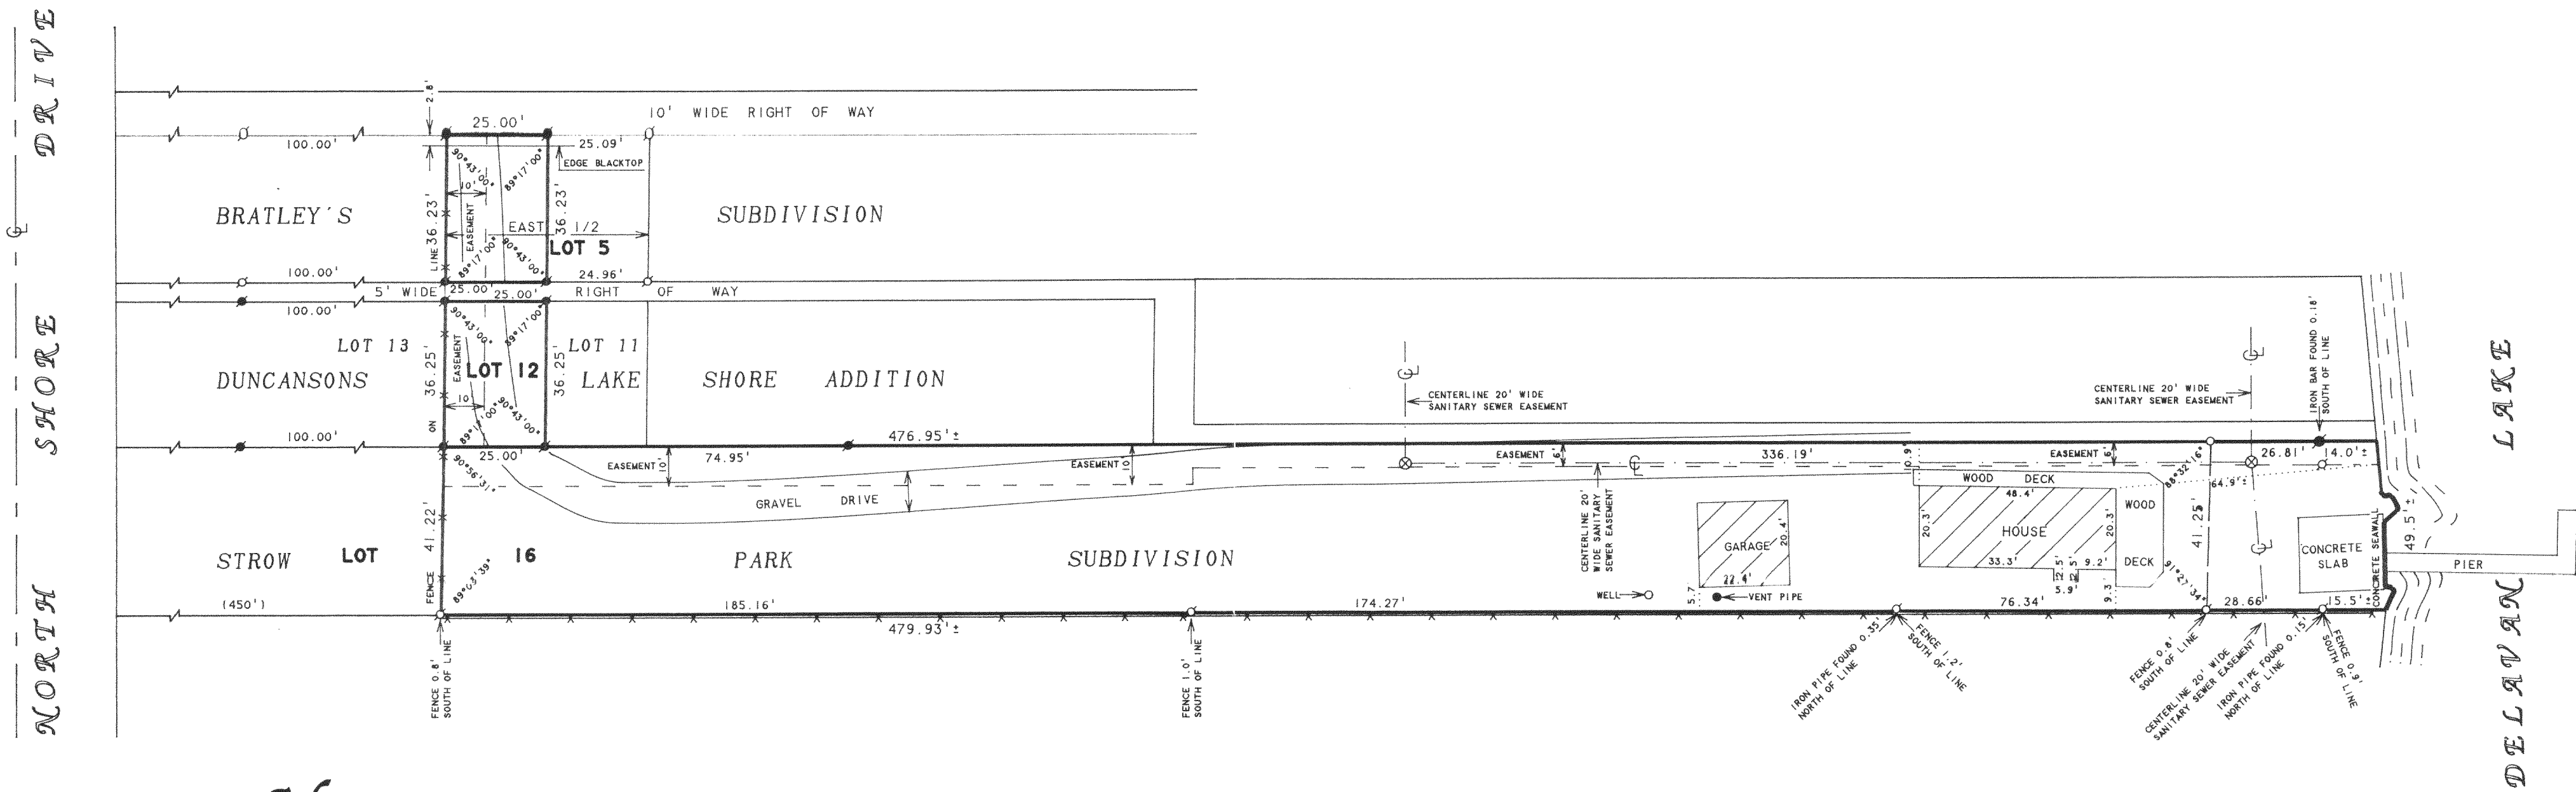

SCALE 1"=30'

LEGEND


- - IRON PIPE FOUND
- - IRON ROD FOUND
- - IRON BAR FOUND
- ⊗ - MANHOLE COVER
- X— - WOOD FENCE
- () - RECORDED AS

PLAT OF SURVEY OF

All of Lot 12 of Duncanson's Lake Shore Addition, and the West 1/2 of the East 1/2 of Lot 5 of Bratley's Subdivision, both subdivisions being in the Township of Delavan, and that part of Lot 16 of Strow Park Subdivision lying East of the West line of Lot 12 of Duncanson's Lake Shore Addition extended south to the South line of said Lot 16 of Strow Park, all in Walworth County, Wisconsin.

Driveway to be used in common with others over the North side of Lots 1 to 9 inclusive, as designated on the plat of Bratley's Subdivision. Easement over the West 10 feet of the East 1/2 of Lot 5, Bratley's Subdivision the west 10 feet of Lot 12 of Duncanson's Lake Shore Addition, and the North 10 feet and the North 6 feet of that part of Lot 16 of Strow Park described in the description herein, all as set forth in the following documents: Warranty Deed from Russell N. Schwartz et ux to Charles F. Huss et ux, recorded Jan. 3, 1968 in Vol. 658 of Deeds on page 83 as Document No. 598593, Deed from Personal Representative of the Estate of Russell N. Schwartz to Charles F. Huss et ux recorded July 10, 1974 in Vol. 117 of Records on page 635 as Document No. 680461, Warranty Deed from Charles F. Huss et ux to John K. Walsh recorded Dec. 1, 1975 in Vol. 148 of Records on page 301 as Document No. 699443, and Affidavit of Charles F. Huss recorded Aug. 18, 1977 in Volume 194 of Records on page 459 as Document No. 21668.

ORDERED BY: PROFESSIONAL REALTY
706 E. GENEVA ST.
DEHAVAN, WI. 53115

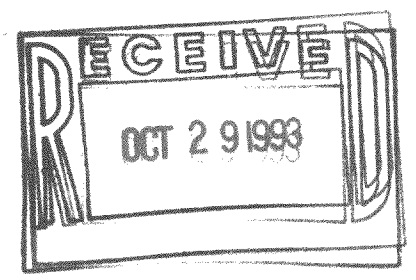

I HEREBY CERTIFY THAT I HAVE SURVEYED THE ABOVE DESCRIBED PROPERTY AND THAT THE ABOVE MAP IS A TRUE REPRESENTATION THEREOF AND SHOWS THE SIZE AND LOCATION OF THE PROPERTY, ITS EXTERIOR BOUNDARIES, THE LOCATION OF ALL VISIBLE STRUCTURES AND DIMENSIONS OF ALL PRINCIPAL BUILDINGS THEREON, BOUNDARY FENCES, APPARENT EASEMENTS, ROADWAYS AND VISIBLE ENCROACHMENTS, IF ANY, TO THE BEST OF MY KNOWLEDGE AND BELIEF.

THIS SURVEY IS MADE FOR THE USE OF THE PRESENT OWNERS OF THE PROPERTY, AND ALSO THOSE WHO PURCHASE, MORTGAGE, OR GUARANTEE THE TITLE THERETO WITHIN ONE (1) YEAR FROM DATE HEREON.

David F. Abell

DAVID F. ABELL
WISCONSIN REGISTERED LAND SURVEYOR, S-1596

August 26, 1993

DATE: August 26, 1993 JOB NUMBER - 86046
NOTE: THIS IS NOT A CERTIFIED COPY UNLESS SEALED.

FDW-4
FBR-548
FST-8

216-1856