


ABELL
SURVEYING & MAPPING
DELAVAN, WISCONSIN 53115
414-728-6737


COLLIE STREET

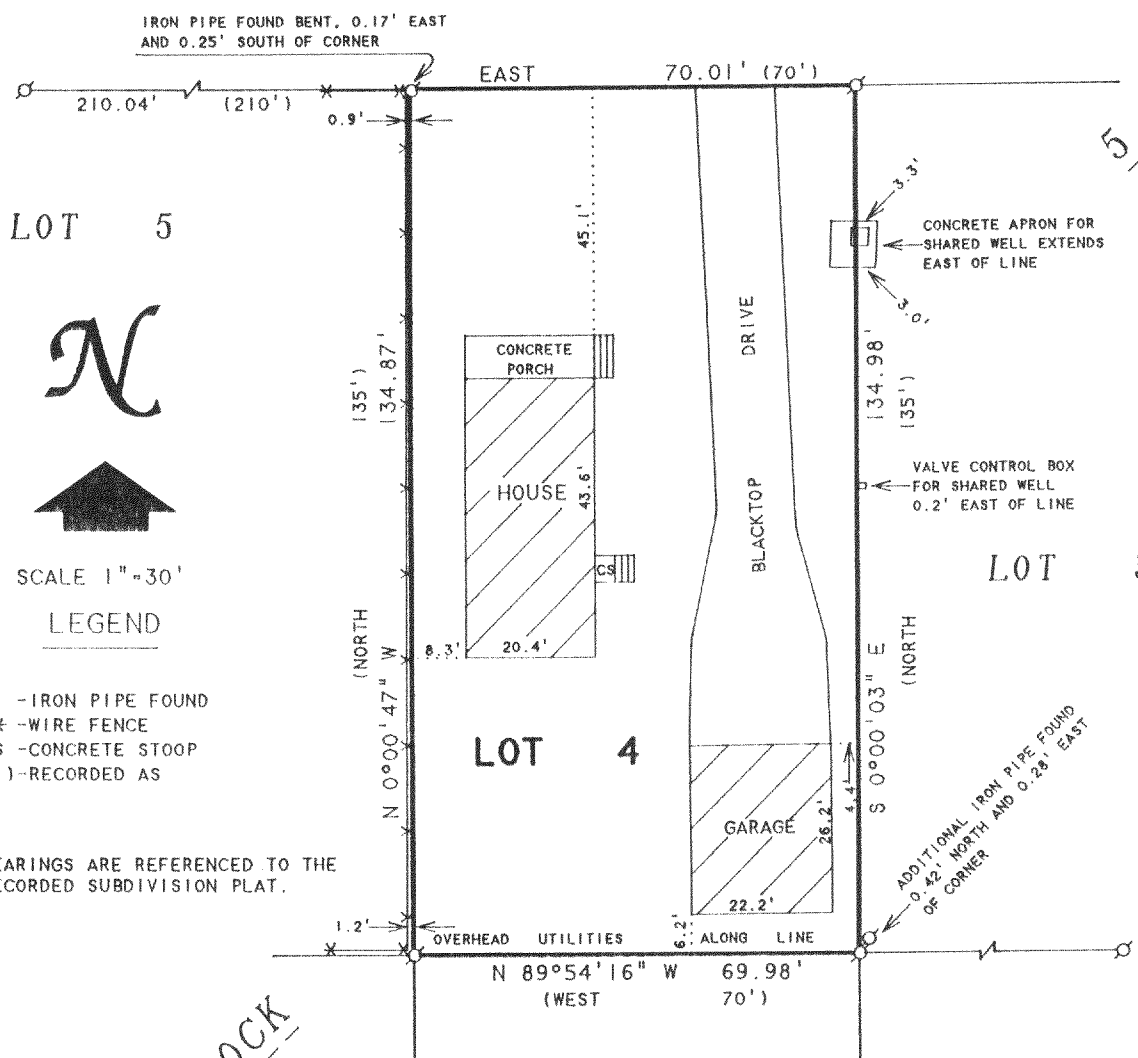

PLAT OF SURVEY OF

ORDERED BY: CENTURY 21-SKANDIA REALTY
312 S. 7th STREET
DELAVAN, WI. 53115

LOT 4, BLOCK 5, DELMAR SUBDIVISION,
LOCATED IN T2N, R16E, WALWORTH
COUNTY, WISCONSIN.

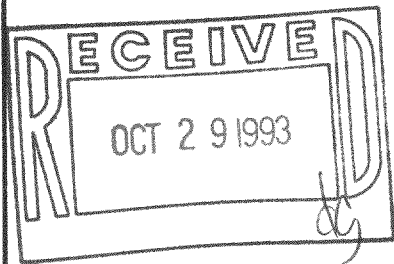

I HEREBY CERTIFY THAT I HAVE SURVEYED THE ABOVE DESCRIBED PROPERTY AND THAT THE ABOVE MAP IS A TRUE REPRESENTATION THEREOF AND SHOWS THE SIZE AND LOCATION OF THE PROPERTY, ITS EXTERIOR BOUNDARIES, THE LOCATION OF ALL VISIBLE STRUCTURES AND DIMENSIONS OF ALL PRINCIPAL BUILDINGS THEREON, BOUNDARY FENCES, APPARENT EASEMENTS, ROADWAYS AND VISIBLE ENCROACHMENTS, IF ANY, TO THE BEST OF MY KNOWLEDGE AND BELIEF.

THIS SURVEY IS MADE FOR THE USE OF THE PRESENT OWNERS OF THE PROPERTY, AND ALSO THOSE WHO PURCHASE, MORTGAGE, OR GUARANTEE THE TITLE THERETO WITHIN ONE (1) YEAR FROM DATE HEREON.

Edward J. Nezworski
EDWARD J. NEZWORSKI
WISCONSIN REGISTERED LAND SURVEYOR, S-2139

JULY 12, 1993

DATE JOB NUMBER - 93135
NOTE: THIS IS NOT A CERTIFIED COPY UNLESS SEALED.