



ABELL
SURVEYING & MAPPING
DELAVAN, WISCONSIN 53115
414-728-6737

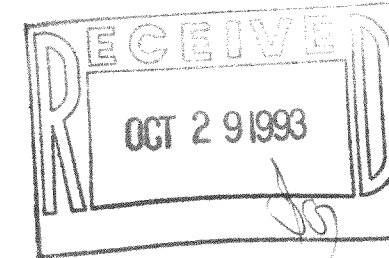

BRATLEY'S

SUBDIVISION

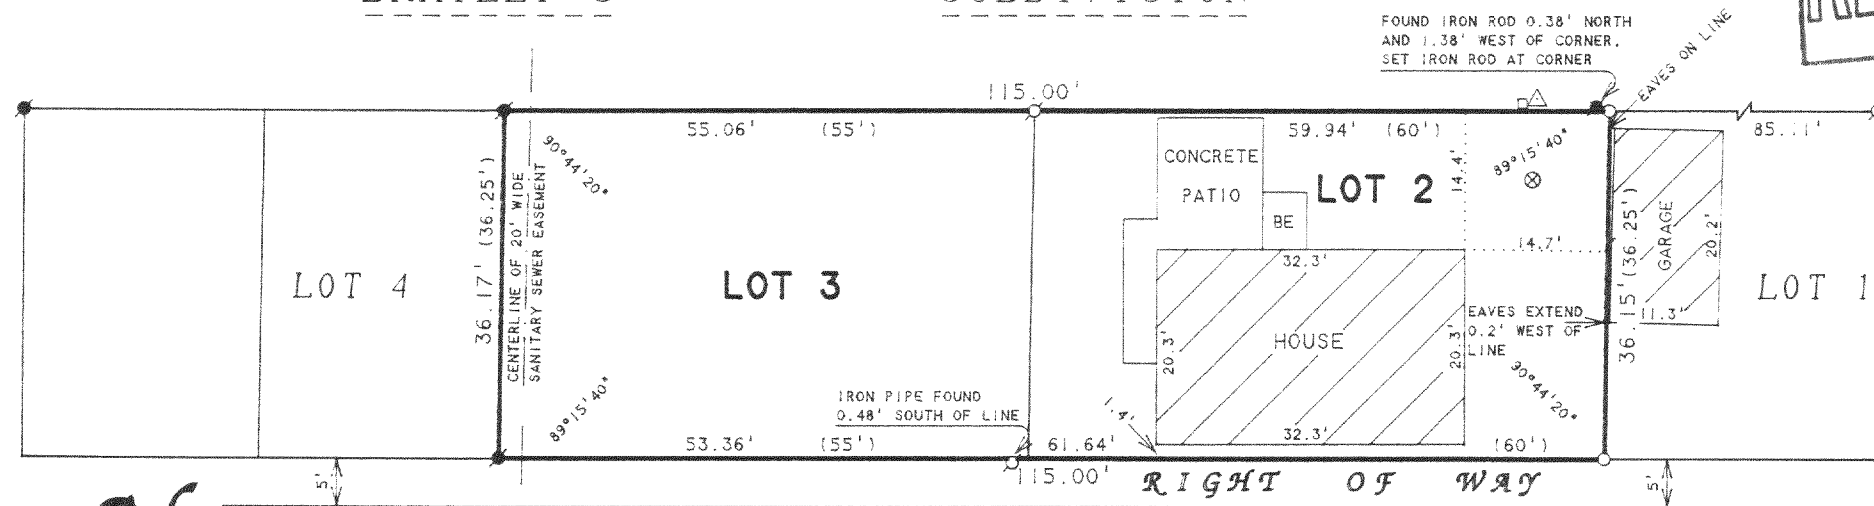

N



SCALE 1"=20'

LEGEND

- -IRON PIPE FOUND
- -IRON ROD FOUND
- -IRON ROD SET
- ⊗ -CONCRETE COVER
- BE -BASEMENT ENTRY
- △ -UTILITY POLE
- -UTILITY PED.
- () -RECORDED AS

PLAT OF SURVEY OF

LOTS 2 & 3, DUNCANSONS LAKE SHORE
ADDITION, LOCATED IN T2N. R16E.
WALWORTH COUNTY, WISCONSIN.

ORDERED BY: RICHARD STEIN
10429 S. HAMLIN
CHICAGO, IL 60655

I, DAVID F. ABELL, DO HEREBY CERTIFY THAT I HAVE SURVEYED THE PROPERTY HEREON DESCRIBED ACCORDING TO THE OFFICAL RECORDS AND THAT THE PLAT HEREON IS A CORRECT REPRESENTATION OF THE PROPERTY LINES TO THE BEST OF MY KNOWLEDGE AND BELIEF.

David F. Abell

DAVID F. ABELL
WISCONSIN REGISTERED LAND SURVEYOR, S-1596

October 15, 1993

DATE JOB NUMBER - 93231
NOTE: THIS IS NOT A CERTIFIED COPY UNLESS SEALED.

FDW-2
FDW-3

216-1888