



NEGLAY
30'
AVE.

INLET SHORE DRIVE

INLET AVENUE

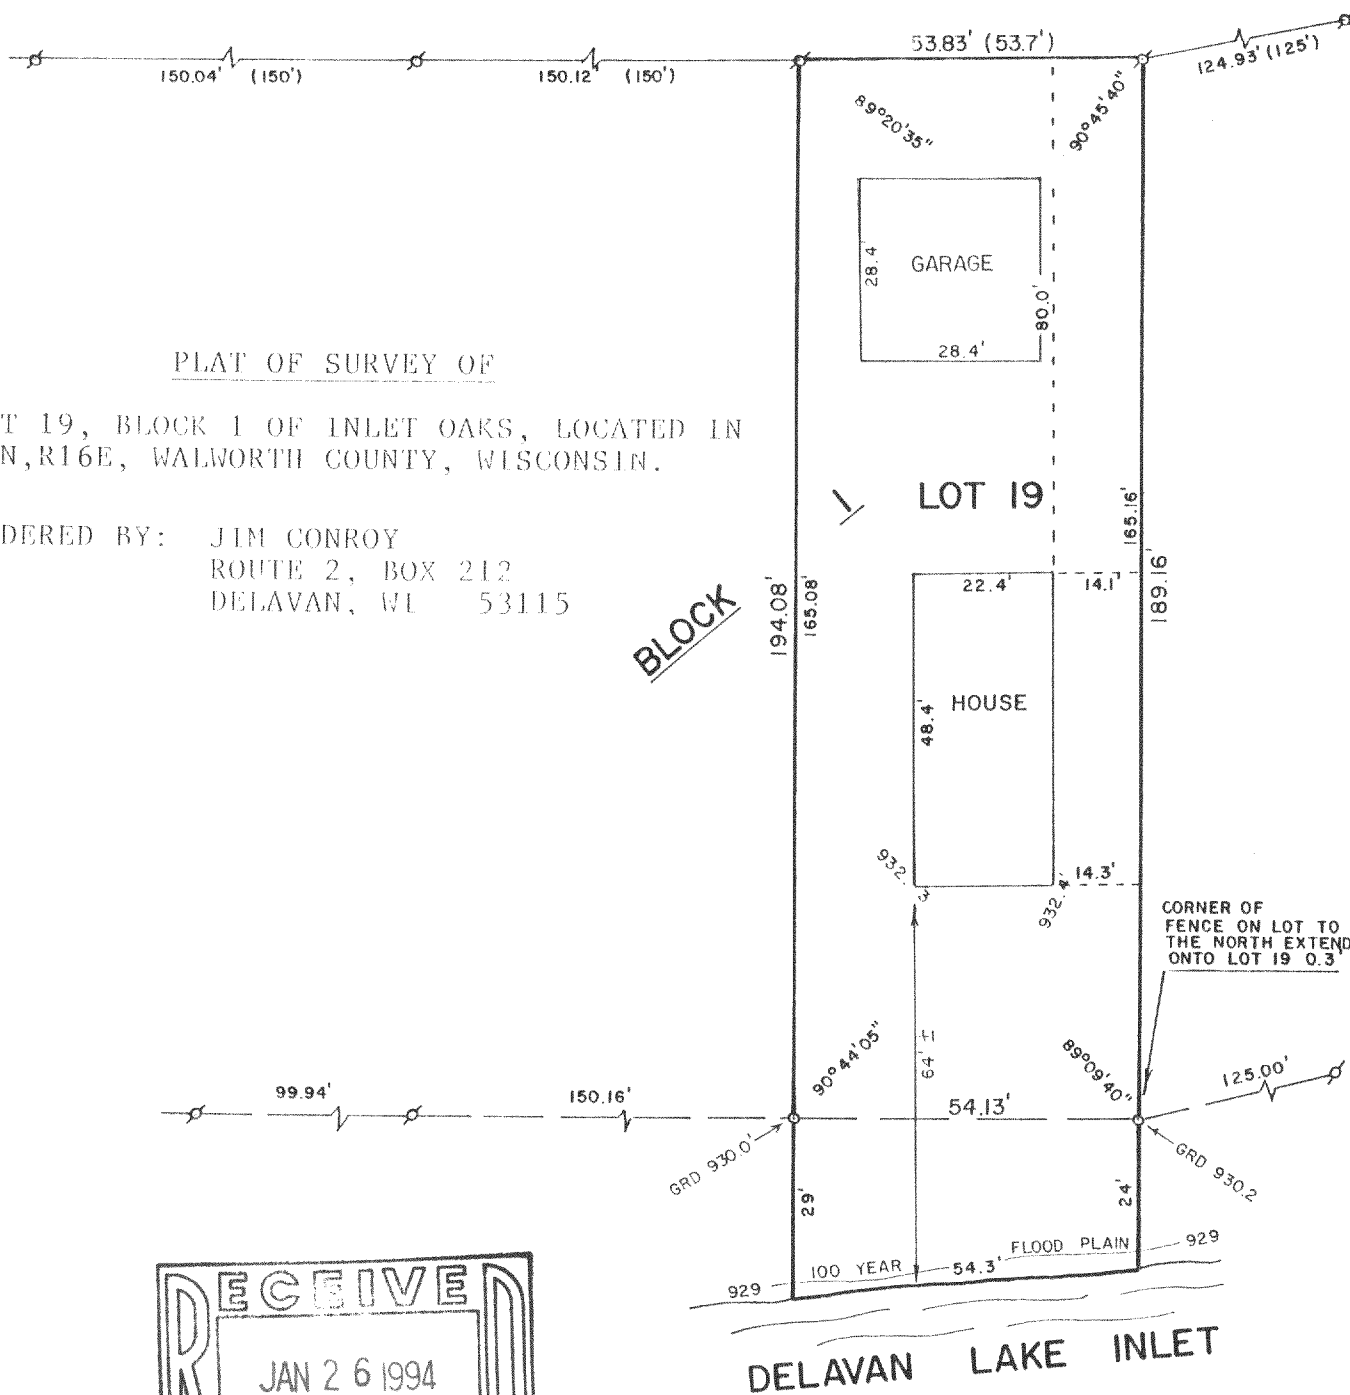

RECEIVED
JAN 26 1994

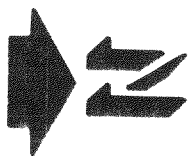

SCALE 1"=30'

Ø - IRON PIPE FOUND
O - 3/4" DIA. IRON ROD
SET FOUND 10/16/93
() - RECORDED AS

I, DAVID F. ABELL, DO HEREBY CERTIFY THAT I HAVE SURVEYED THE PROPERTY HEREON DESCRIBED ACCORDING TO THE OFFICIAL RECORDS AND THAT THE PLAT HEREON IS A CORRECT REPRESENTATION OF THE PROPERTY LINES TO THE BEST OF MY KNOWLEDGE AND BELIEF.

DAVID F. ABELL
WISCONSIN REGISTERED LAND SURVEYOR, S-1596

DATE August 6, 1987 REVISED: 10/28/93
JOB NUMBER - 87104

NOTE: THIS IS NOT A CERTIFIED COPY UNLESS SEALED.