


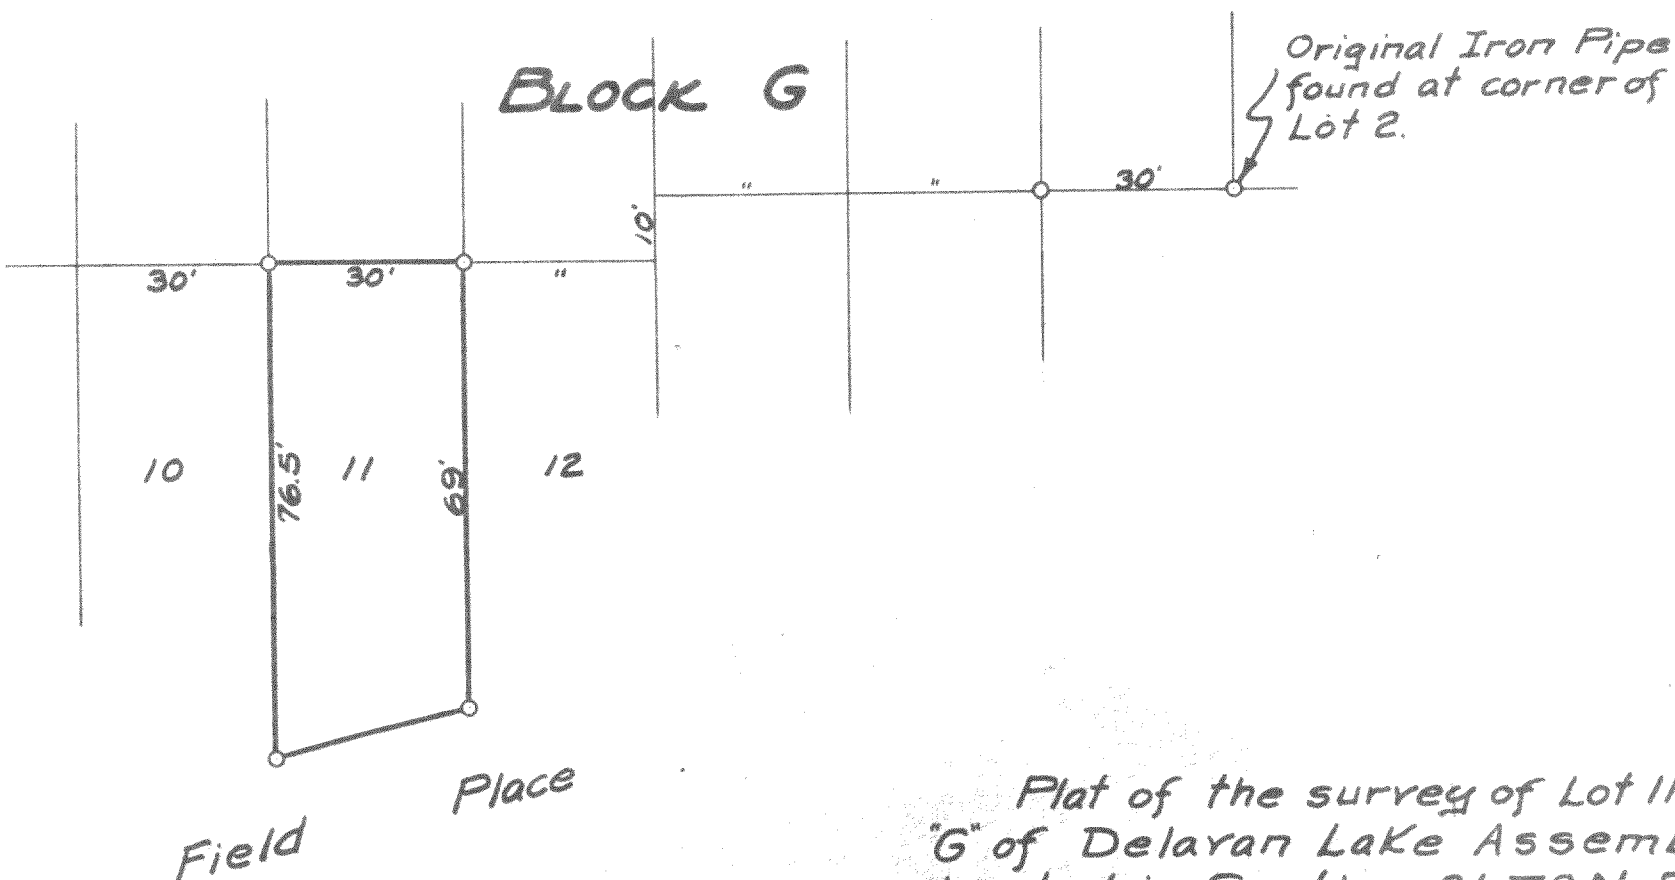

Plat of the survey of Lot 11 of Block
"G" of Delavan Lake Assembly grounds,
located in Section 21, T2N, R16E, Walworth
County, Wisconsin.

Scale 1" = 30'
May 14, 1935
o - Iron stake

Lloyd V. Jensen
County Surveyor

216-201