


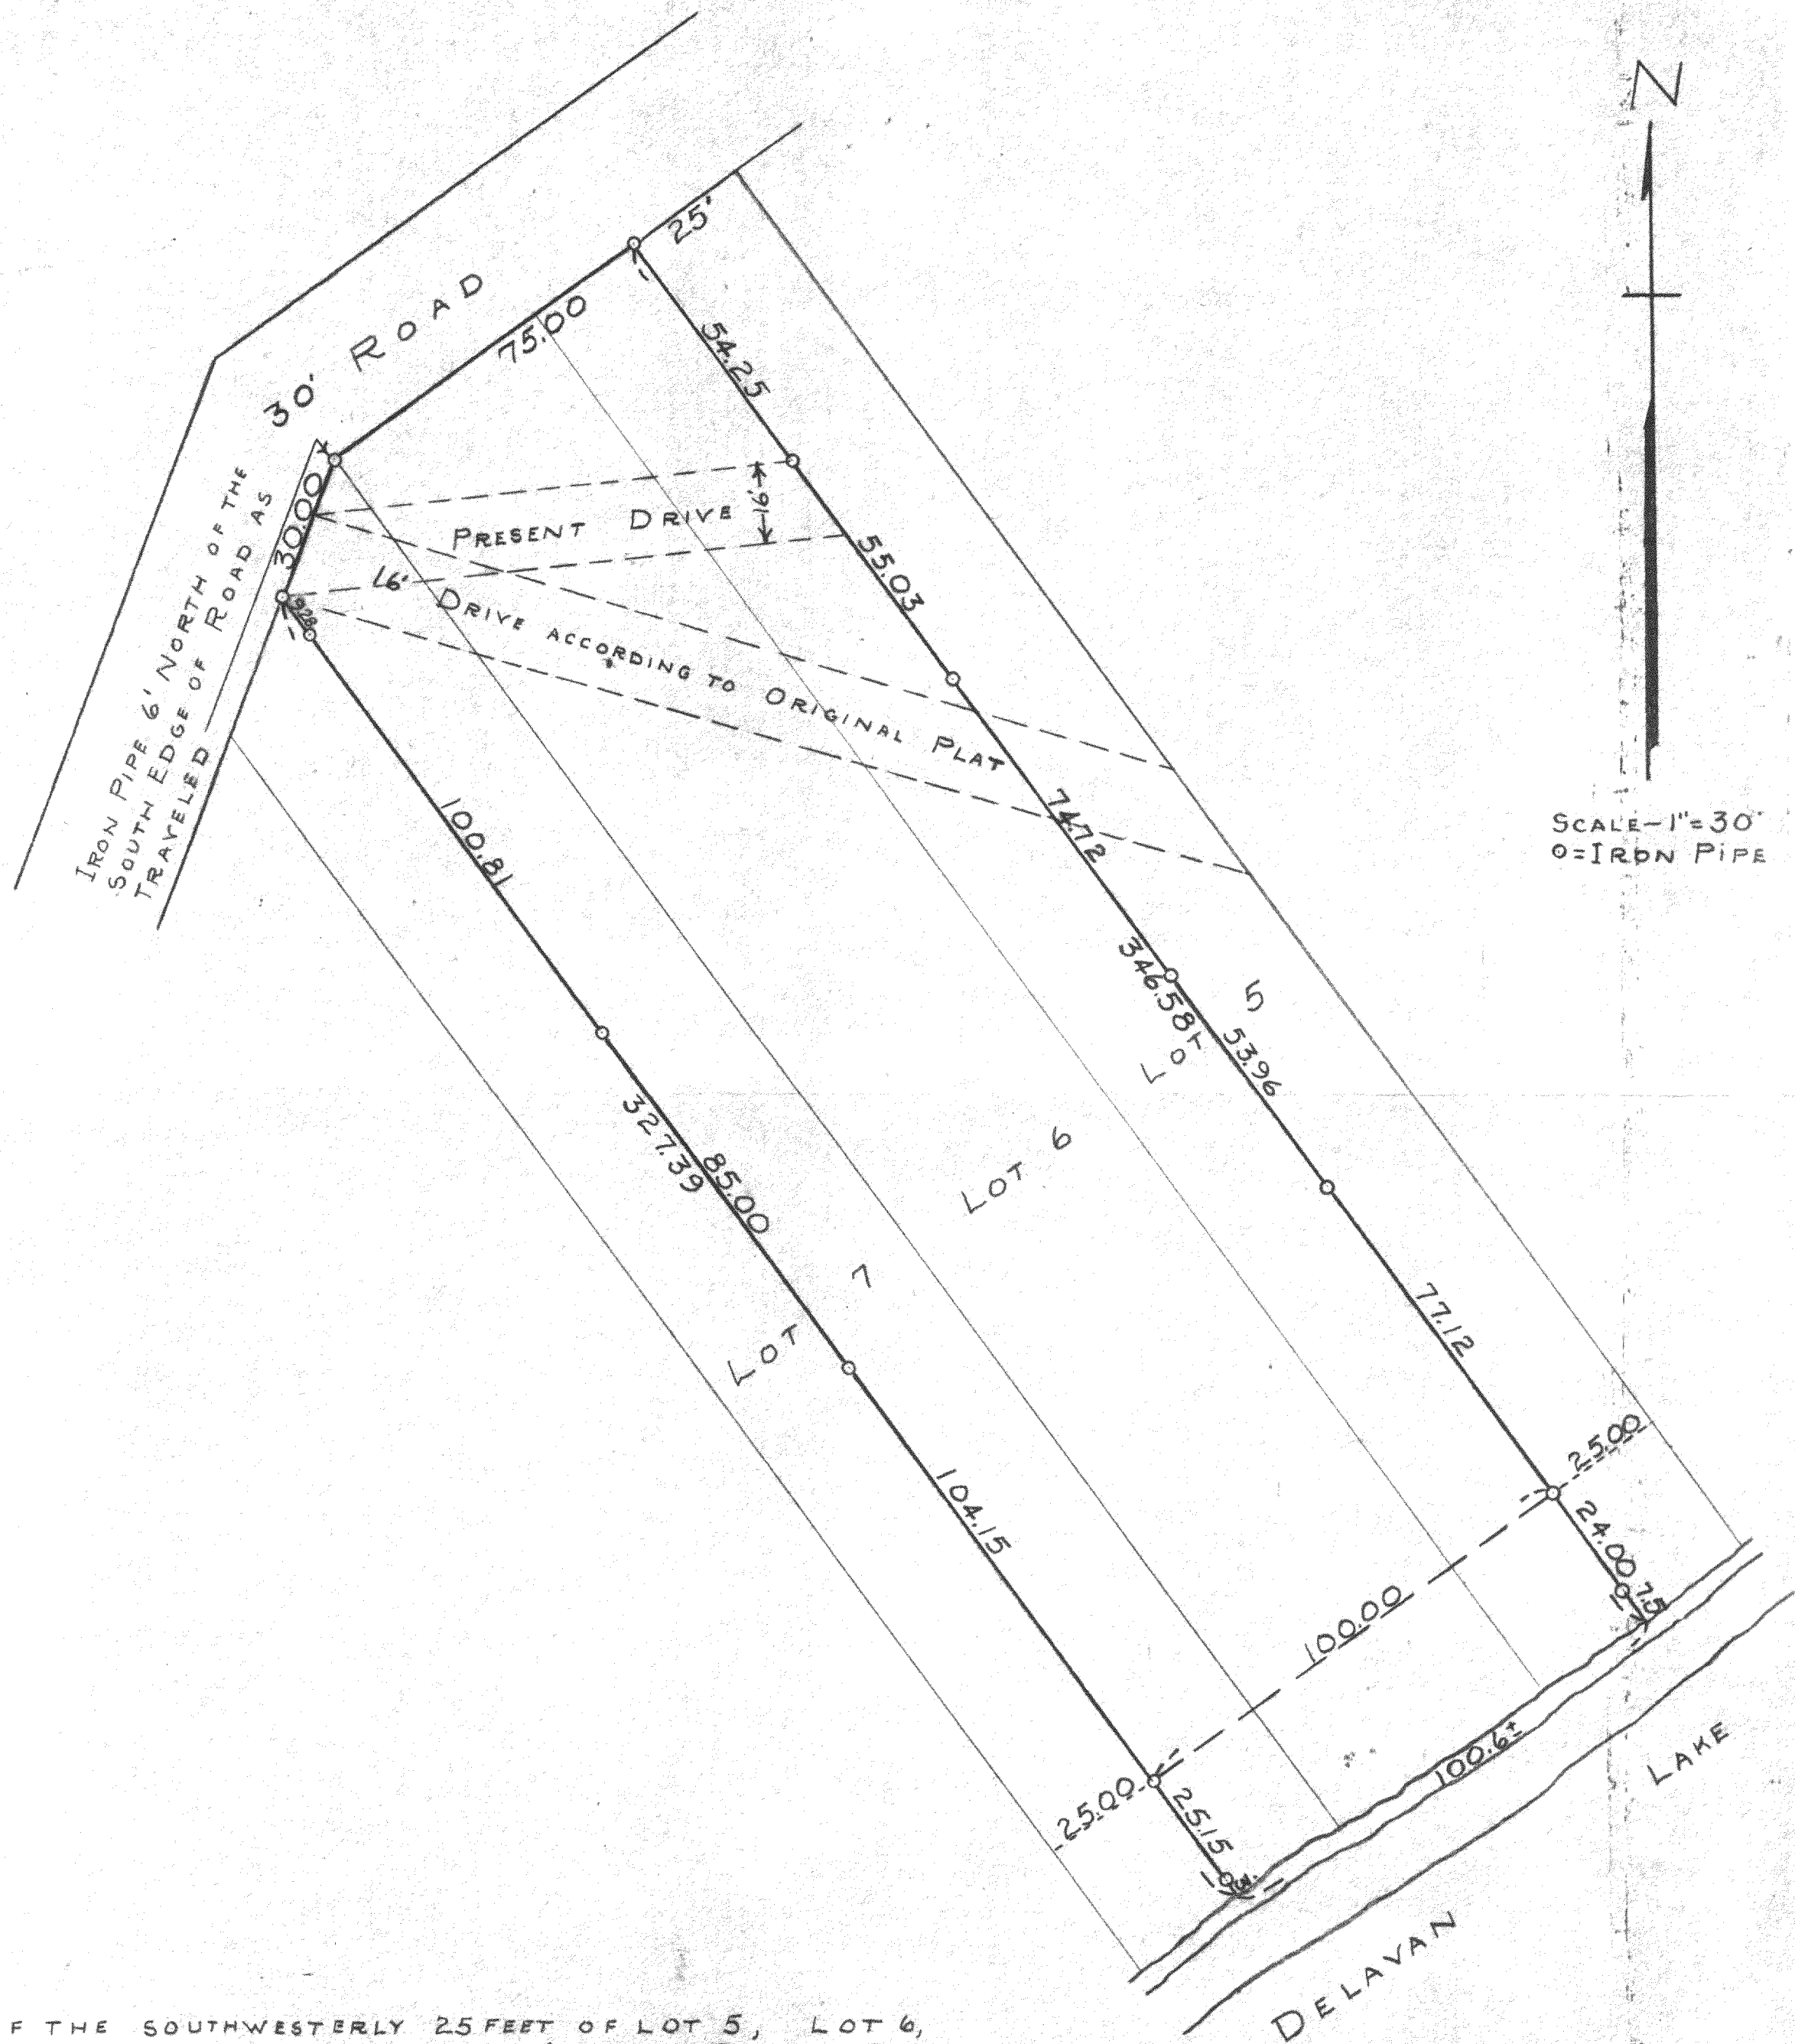

FWI-3,4,5

PLAT OF SURVEY OF THE SOUTHWESTERLY 25 FEET OF LOT 5, LOT 6, AND THE NORTHEASTERLY 1/2 OF LOT 7 OF WILLOW POINT PARK LOCATED IN THE SOUTHEAST 1/4 OF SECTION 29, T2N R16E OF WALWORTH COUNTY, WISCONSIN
APRIL 23, 1954

FWI - 4 and 5

George T. Dunham
GEORGE T. DUNHAM, SURVEYOR
DELAVAN, WISCONSIN

216-20