

KOLB LAND CONSULTING, INC.

LAND SURVEYING • SUBDIVIDING • LAND PLANNING

929 WILLIAMS STREET


LAKE GENEVA, WISCONSIN 53147

414 248-3697

PLAT OF SURVEY OF


LOT 35 OF KRUMHAARS ADDITION
TO RAVENSWOOD SUBDIVISION
LOCATED IN T2N, R16E, TOWN
OF DELAVAN, WALWORTH COUNTY,
WISCONSIN.

ORDERED BY: JAMES CONWAY
1253 SELWYN LANE
BUFFALO GROVE, IL.
60089

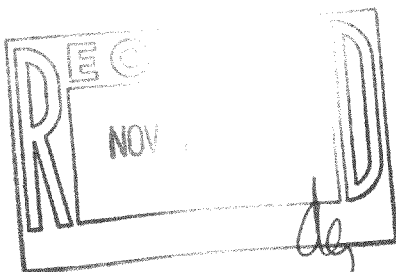

SHED


2.8'

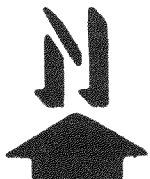

SCALE: 1" = 30'

LEGEND

- ⌀ - IRON PIPE FOUND
- - IRON ROD FOUND
- () - AS RECORDED
- o - IRON PIPE SET
- S - SHED

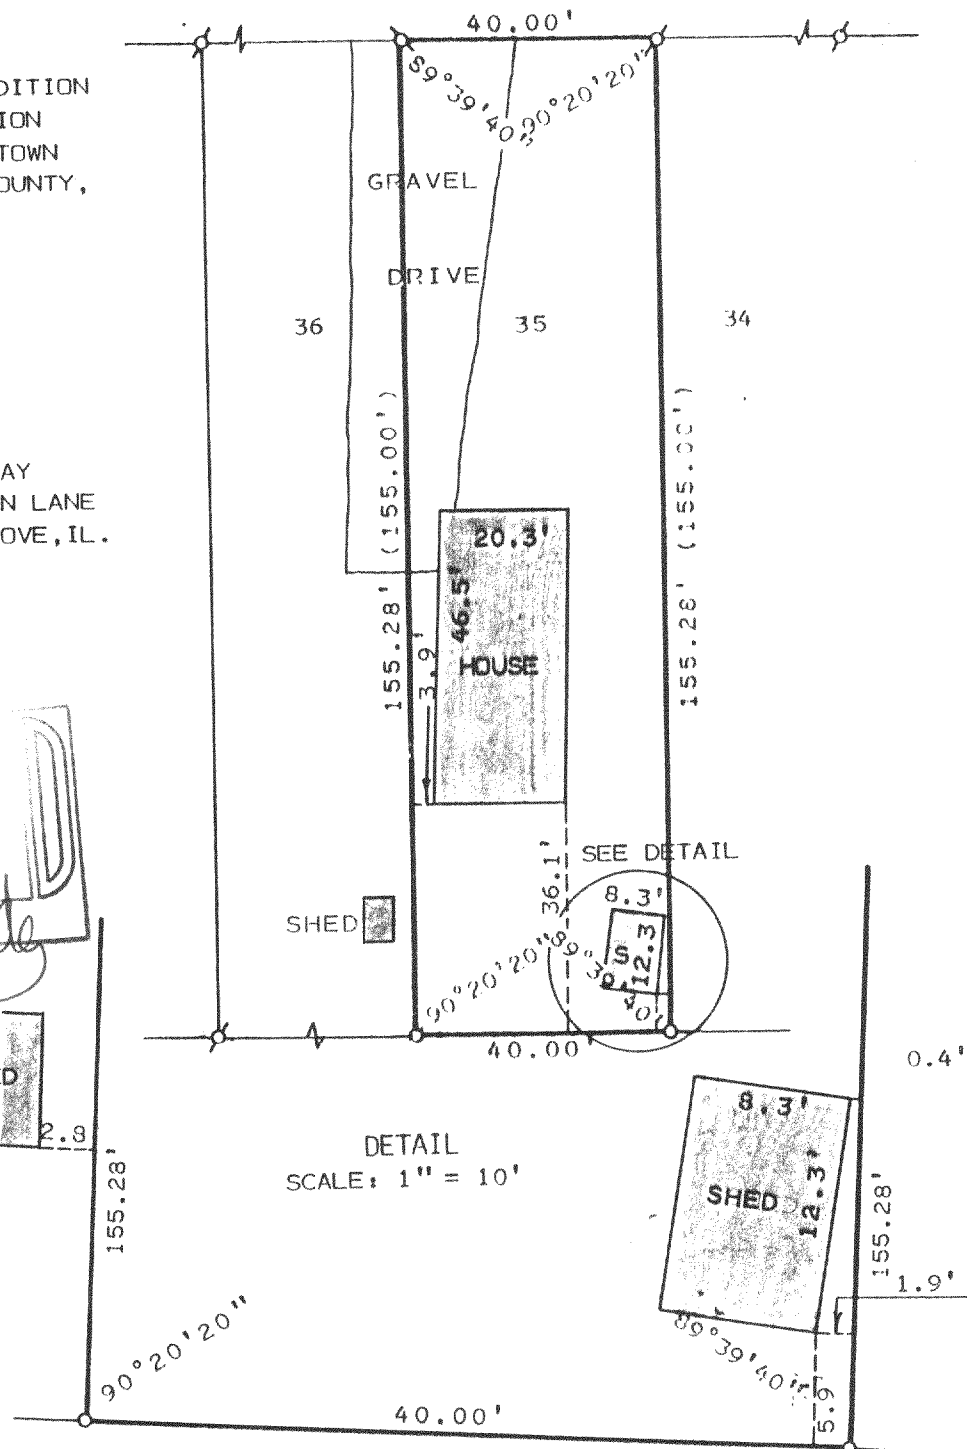

I, HAROLD H. KOLB, DO HEREBY CERTIFY
THAT I HAVE SURVEYED THE PROPERTY
HEREON DESCRIBED ACCORDING TO THE
OFFICIAL RECORDS AND THAT THE PLAT
HEREON IS A CORRECT REPRESENTATION
OF THE LOT LINES AND THE PRINCIPAL
LINES OF THE BUILDINGS TO THE BEST
OF MY KNOWLEDGE AND BELIEF.
SURVEY NOT VALID UNLESS SURVEYOR'S SIGNATURE
IS IN RED.

HAROLD H. KOLB

WISCONSIN REGISTERED LAND SURVEYOR, S-187

DATE AUGUST 30, 1993

REVISED

REVISED

2-16-36

FRA-32

216-2001