


PLAT OF SURVEY

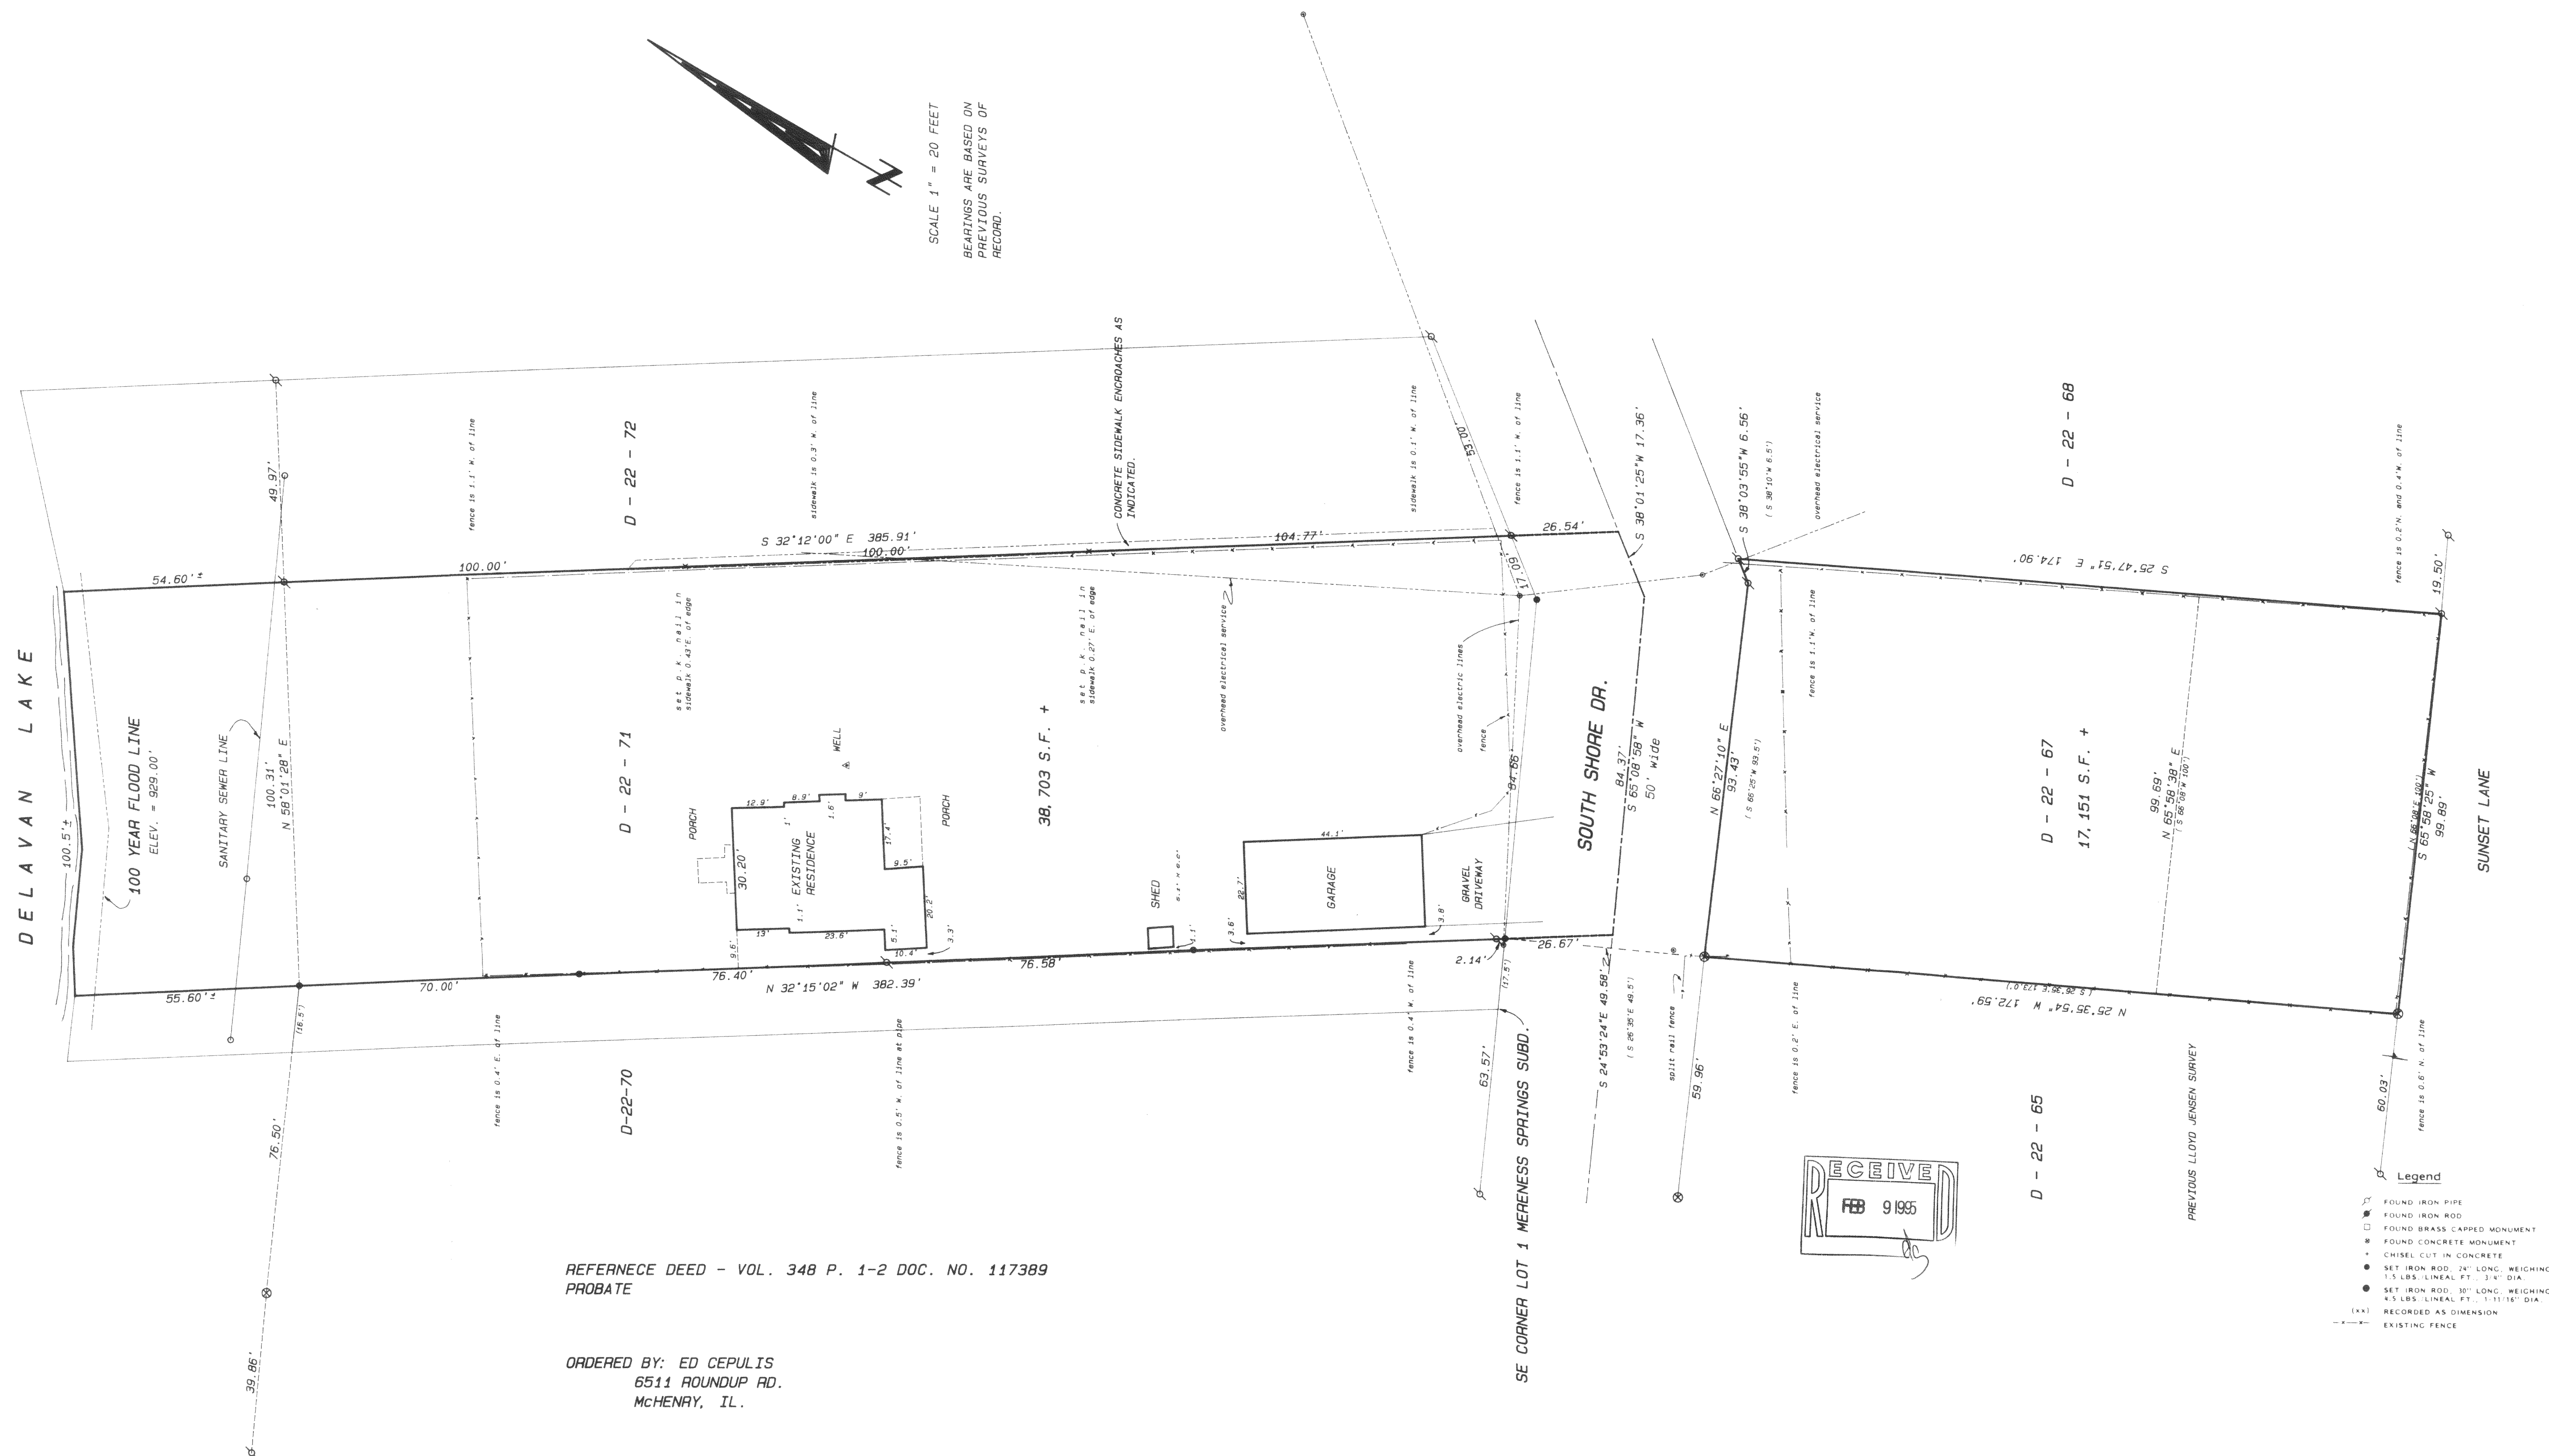

REFERNECE DEED - VOL. 348 P. 1-2 DOC. NO. 117389
PROBATE

ORDERED BY: ED CEPULIS
6511 ROUNDUP RD.
McHENRY, IL.

SCALE: 1" = 20 FEET

"I hereby certify that the above described property has been surveyed by me or under my direction and that the above map is a true representation thereof and shows the size and location of the property, its exterior boundaries, the location of all visible structures and dimensions of all principal buildings thereon, boundary fences, apparent easements, roadways and visible encroachments, if any."

Kenneth B. Arnold

KENNETH B. ABERNATHY, JR.
WISCONSIN REGISTERED LAND SURVEYOR

Date: FEB. 3, 1995 Job No. 95.116

Kenneth B. Arnold

KENNETH B. ABERNATHY, JR.
WISCONSIN REGISTERED LAND SURVEYOR

Date: FEB. 3, 1995 Job No. 95.116

FD22-71
FD-22-67

216-2010