


DUNHAM SURVEYING, S.C.
SURVEYING & SUBDIVIDING
DELAVER, WISCONSIN 53115

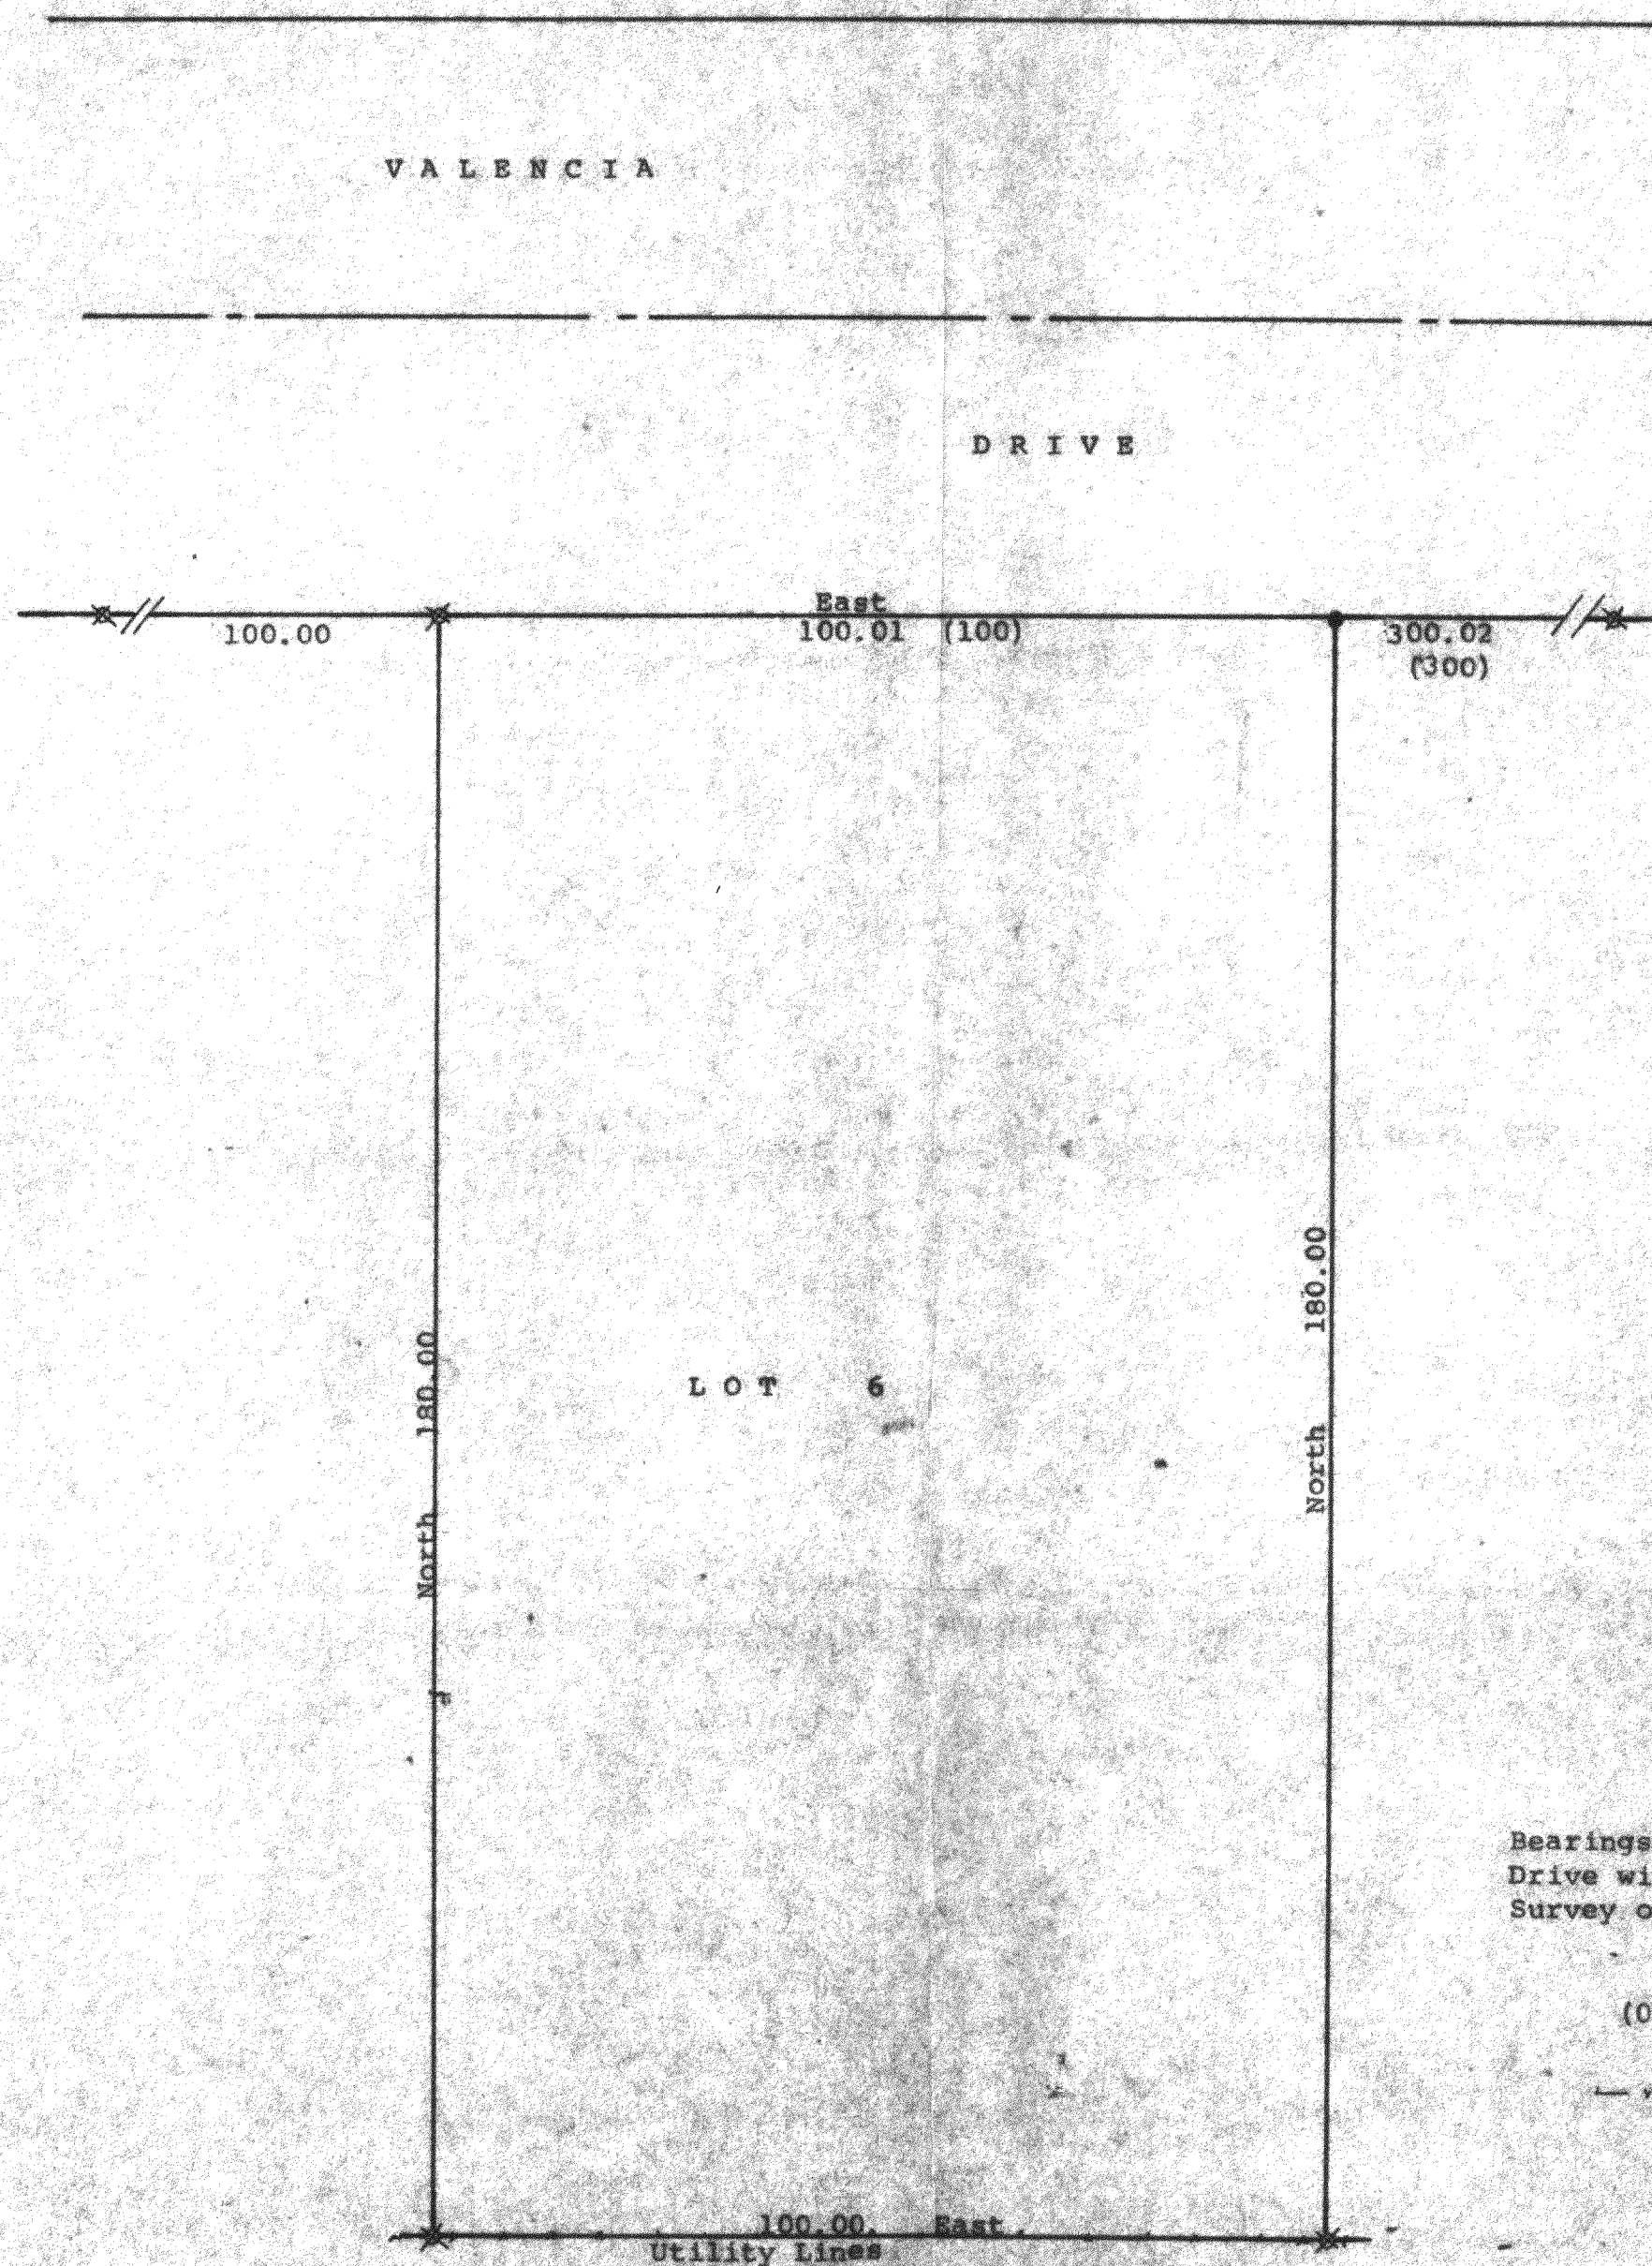

Scale - 1" = 100'
Ø = 3/4" Iron Pipe Found
X = 1" Iron Pipe Found
o = 3/4" Iron Pipe Set
Bearings referenced to the south line of Valencia Drive with recorded bearing of East
Survey ordered by: Professional Realty, Inc
706 East Geneva Street
Delaver, WI 53115
(0.00) = recorded distance
• = 1 1/4" iron pipe set
--- = fence line

STATE OF WISCONSIN) SS
COUNTY OF WALWORTH)

I, George T. Dunham, Surveyor, certify that I have surveyed the property described as follows:

Lot 6 in Block 10 of Inlet Oaks Subdivision No. 5, located in Section 15, T 2 N, R 16 E, Walworth County, Wisconsin.

and that the plat shown hereon is a correct representation thereof and shows the size and location of the property, its exterior boundaries, the location of all visible structures and dimensions of all principal buildings thereon, boundary fences, apparent easements, roadways and visible encroachments, if any, and that I have surveyed the property hereon described, according to the official records, to the best of my knowledge and belief.

October 14, 1994

George T. Dunham
George T. Dunham, Surveyor

