




GEORGE T. DUNHAM
SURVEYING & SUBDIVIDING
DELAVER, WISCONSIN

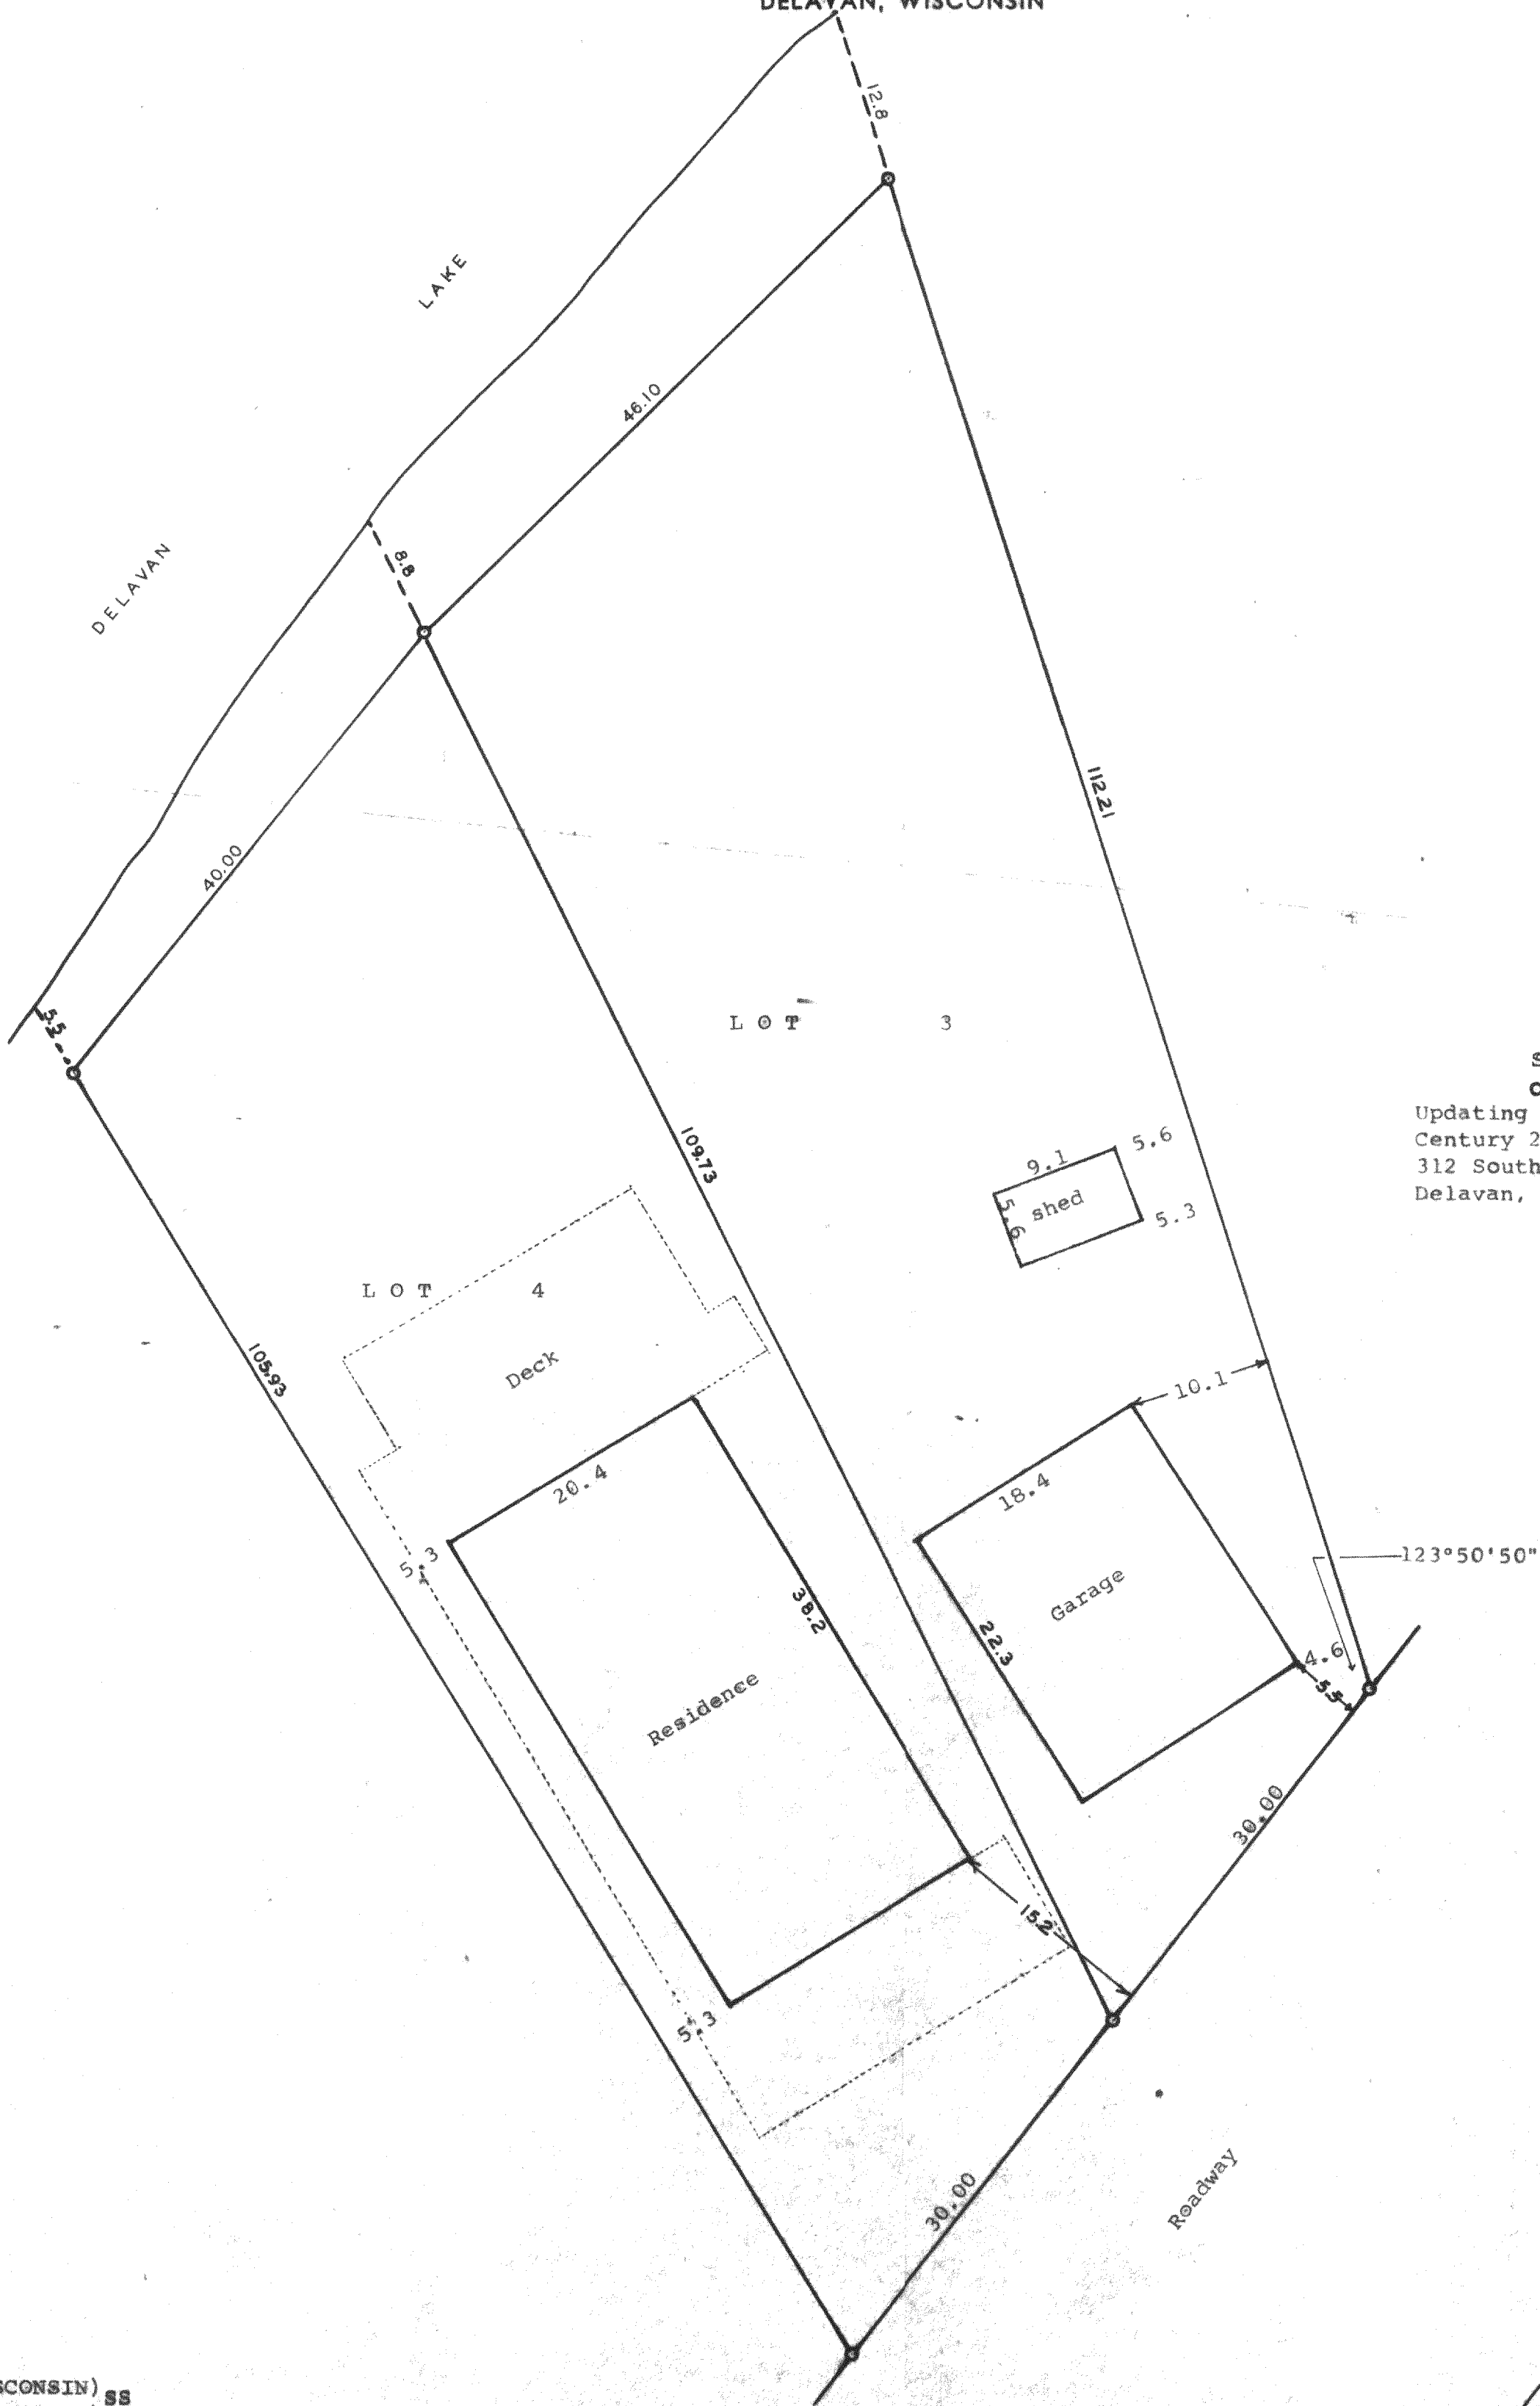

Scale 1" = 10'
 ○ = Iron Pipe
 Updating and recertification ordered by:
 Century 21, Skandia Realty
 312 South 7th Street
 Delavan, WI 53115

STATE OF WISCONSIN) ss
 WALWORTH COUNTY)
 I, George T. Dunham, Surveyor, do certify that I have surveyed the property described as follows,
 Lots 3 and 4, in Block 1, South Shore Manor located in Section 32, T 2 N, R 16 E, Walworth County, Wisconsin. and that the above plat is an accurate survey and a true representation thereof and correctly shows the exterior boundary lines and location of the improvements thereon and the correct measurements thereof.
 May 25, 1965
 Updated and recertified to this 23rd day of May, 1994

George T. Dunham
 George T. Dunham, Surveyor

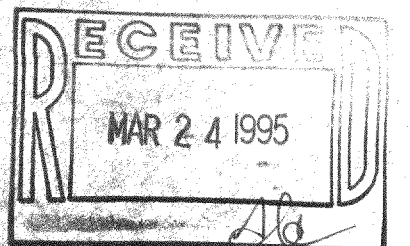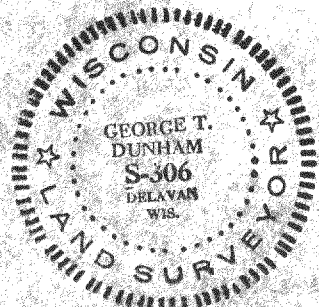

FSS-3

216-2051