


DUNHAM SURVEYING, S.C.
SURVEYING & SUBDIVIDING
DELAVER, WISCONSIN 53115

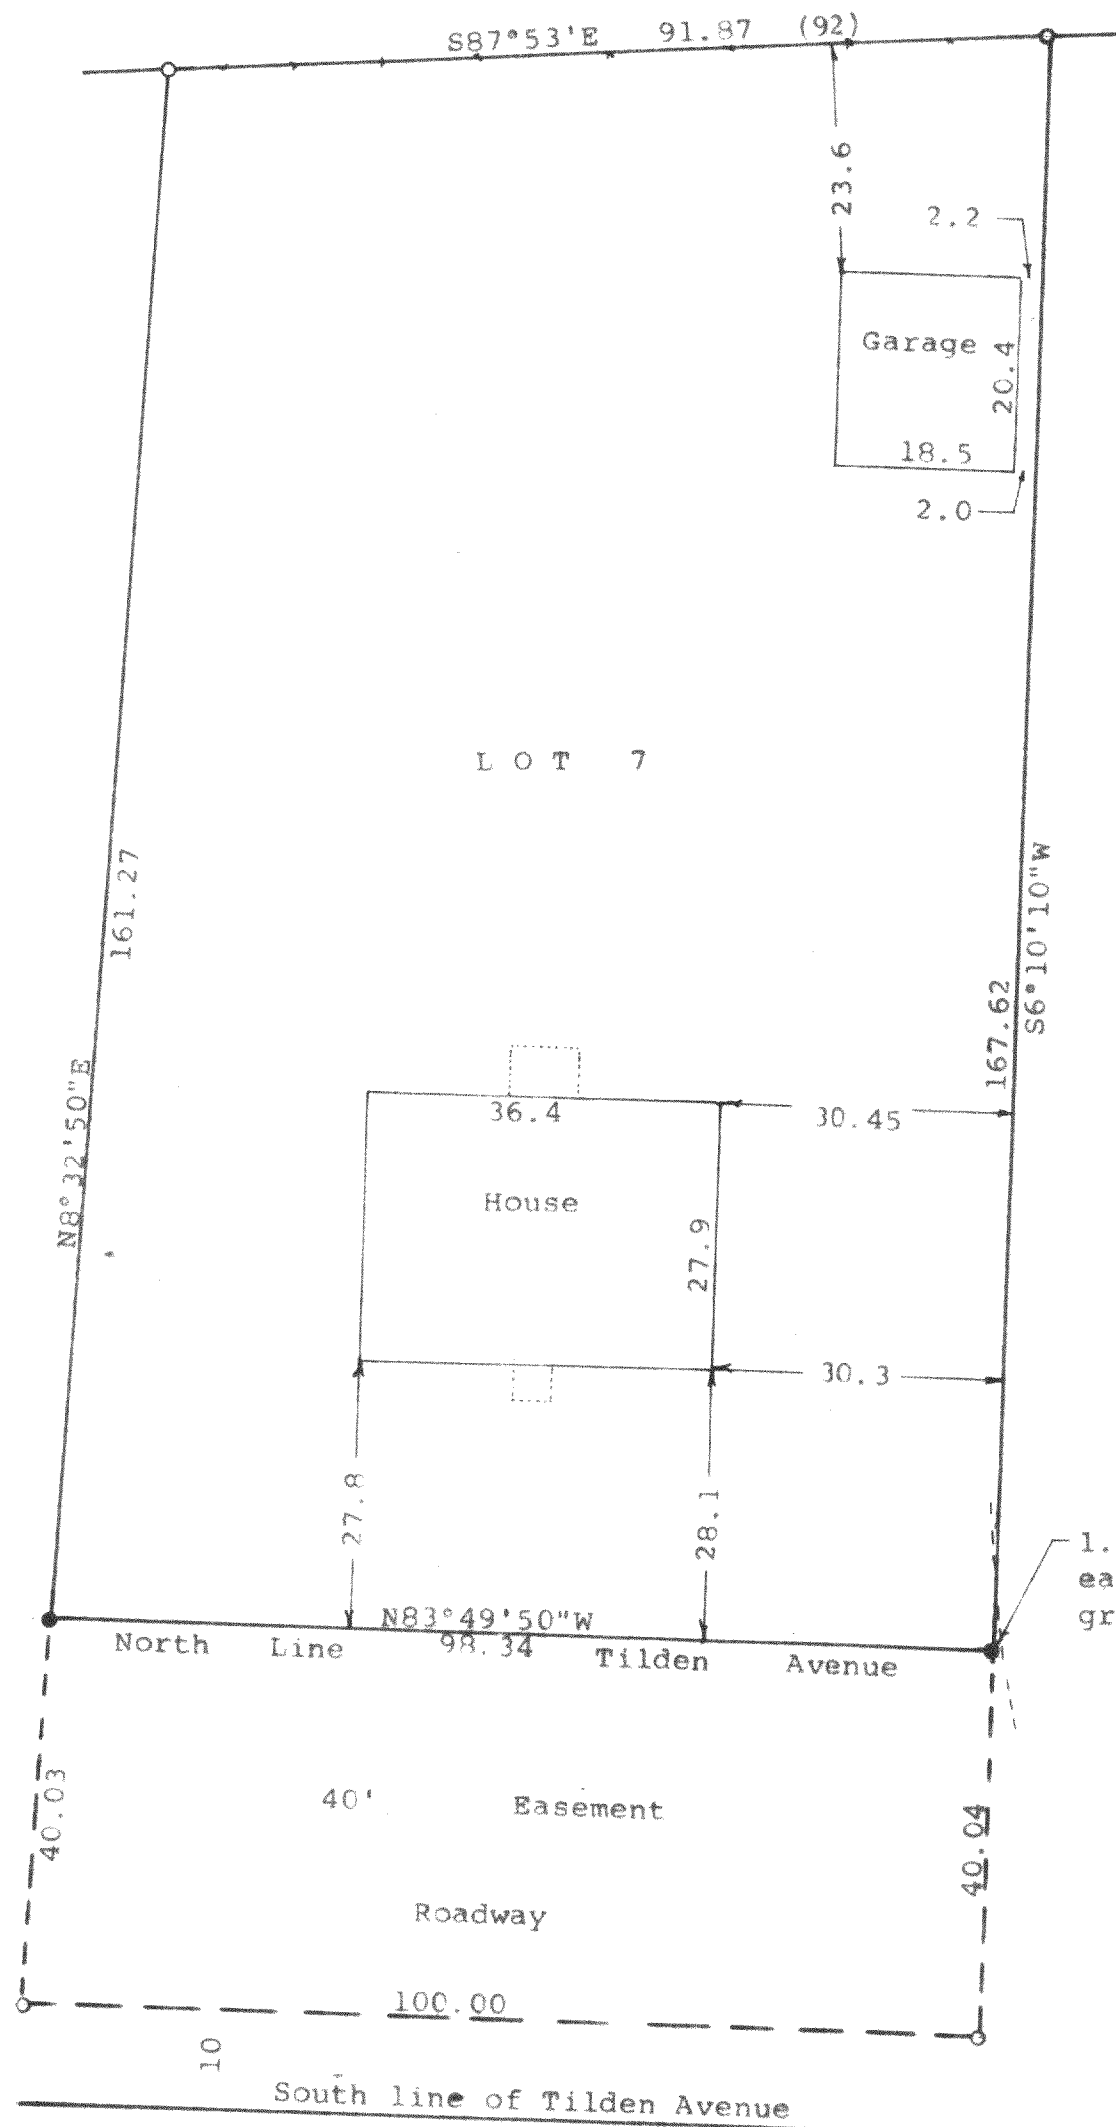

N



Scale - 1" = 20'
 ○ = 1" Iron Pipe Found
 ● = 1/2" Iron Rod Found
 ---x--- = Old Fence Line
 Bearings referenced to the north line of Lot 7
 with the recorded bearing of S87°53'E
 Survey ordered by: Century 21, Skandia Realty
 312 South 7th Street
 Delavan, WI 53115
 (0.00) = recorded distance

STATE OF WISCONSIN) ss
 COUNTY OF WALWORTH)

I, George T. Dunham, Surveyor, certify that I have surveyed the
 property described as follows:

Lot 7 in Delavan Country Club Subdivision located in Fractional
 Section 27, T 2 N, R 16 E, Walworth County, Wisconsin,
 and that the plat shown hereon is a correct representation thereof and shows
 the size and location of the property, its exterior boundaries, the location
 of all visible structures and dimensions of all principal buildings thereon,
 boundary fences, apparent easements, roadways and visible encroachments, if
 any, and that I have surveyed the property hereon described, according to the
 official records, to the best of my knowledge and belief.
 March 28, 1994

George T. Dunham
 George T. Dunham, Surveyor

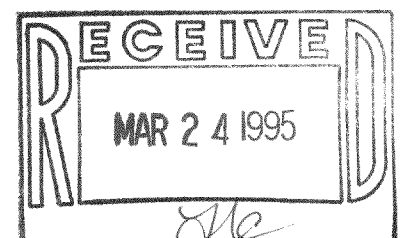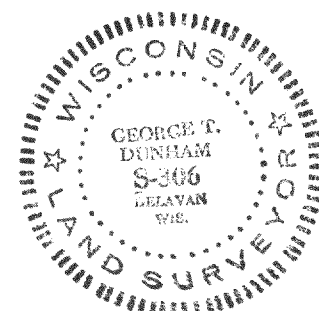

FDCC-4

216-2056