


GEORGE T. DUNHAM
SURVEYING & SUBDIVIDING
DELAVER, WISCONSIN

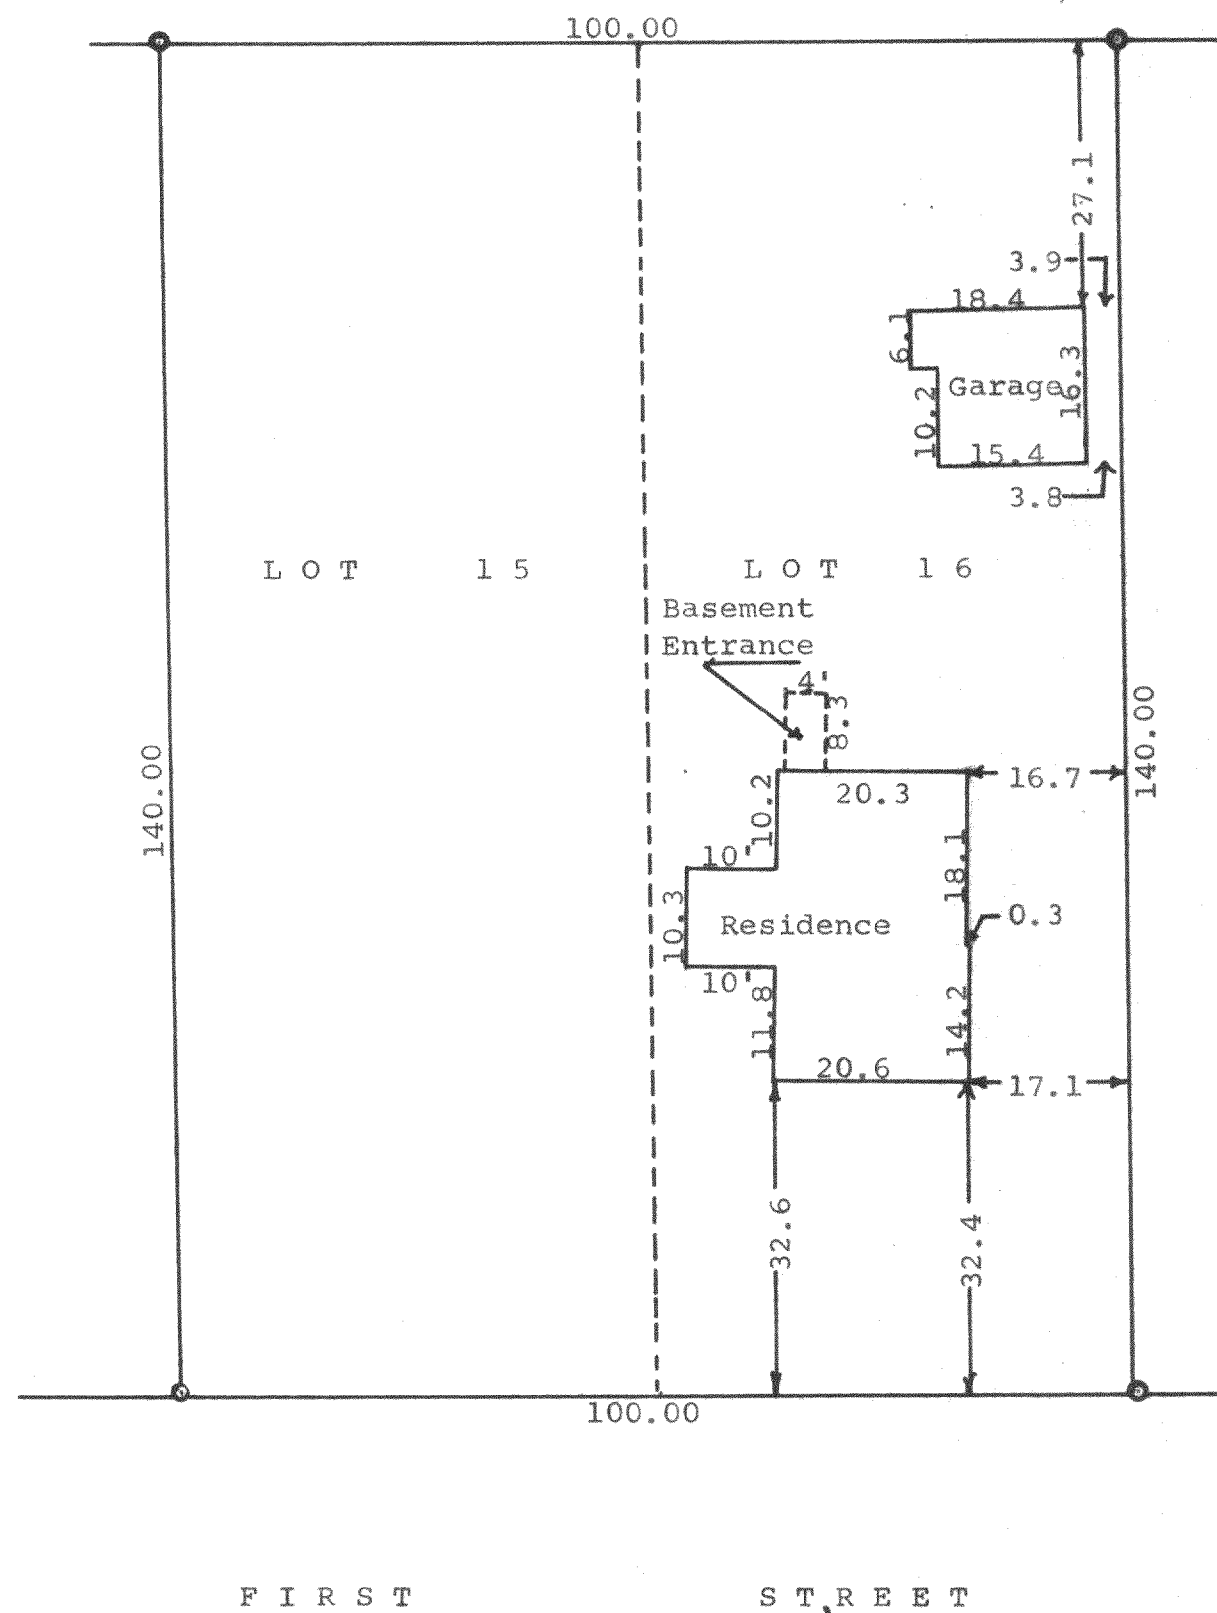

N

Scale - 1" = 20'
○ = Iron Pipe

STATE OF WISCONSIN)
WALWORTH COUNTY) SS

I, George T. Dunham, Surveyor, do certify that I have surveyed the property described as follows,
Lots 15 and 16, Block 2, Inlet Oaks Subdivision No. 3
T 2 N, R 16 E according to the plat thereof recorded in the Office of the Register of Deeds in and for the County of Walworth and State of Wisconsin.
and that the above plat is an accurate survey and a true representation thereof and correctly shows the exterior boundary lines and location of buildings on said property and the correct measurements thereof.
October 22, 1965

George T. Dunham
George T. Dunham, Surveyor