


DUNHAM SURVEYING, S.C.
SURVEYING & SUBDIVIDING
DELAVER, WISCONSIN 53115

COMUS

DRIVE

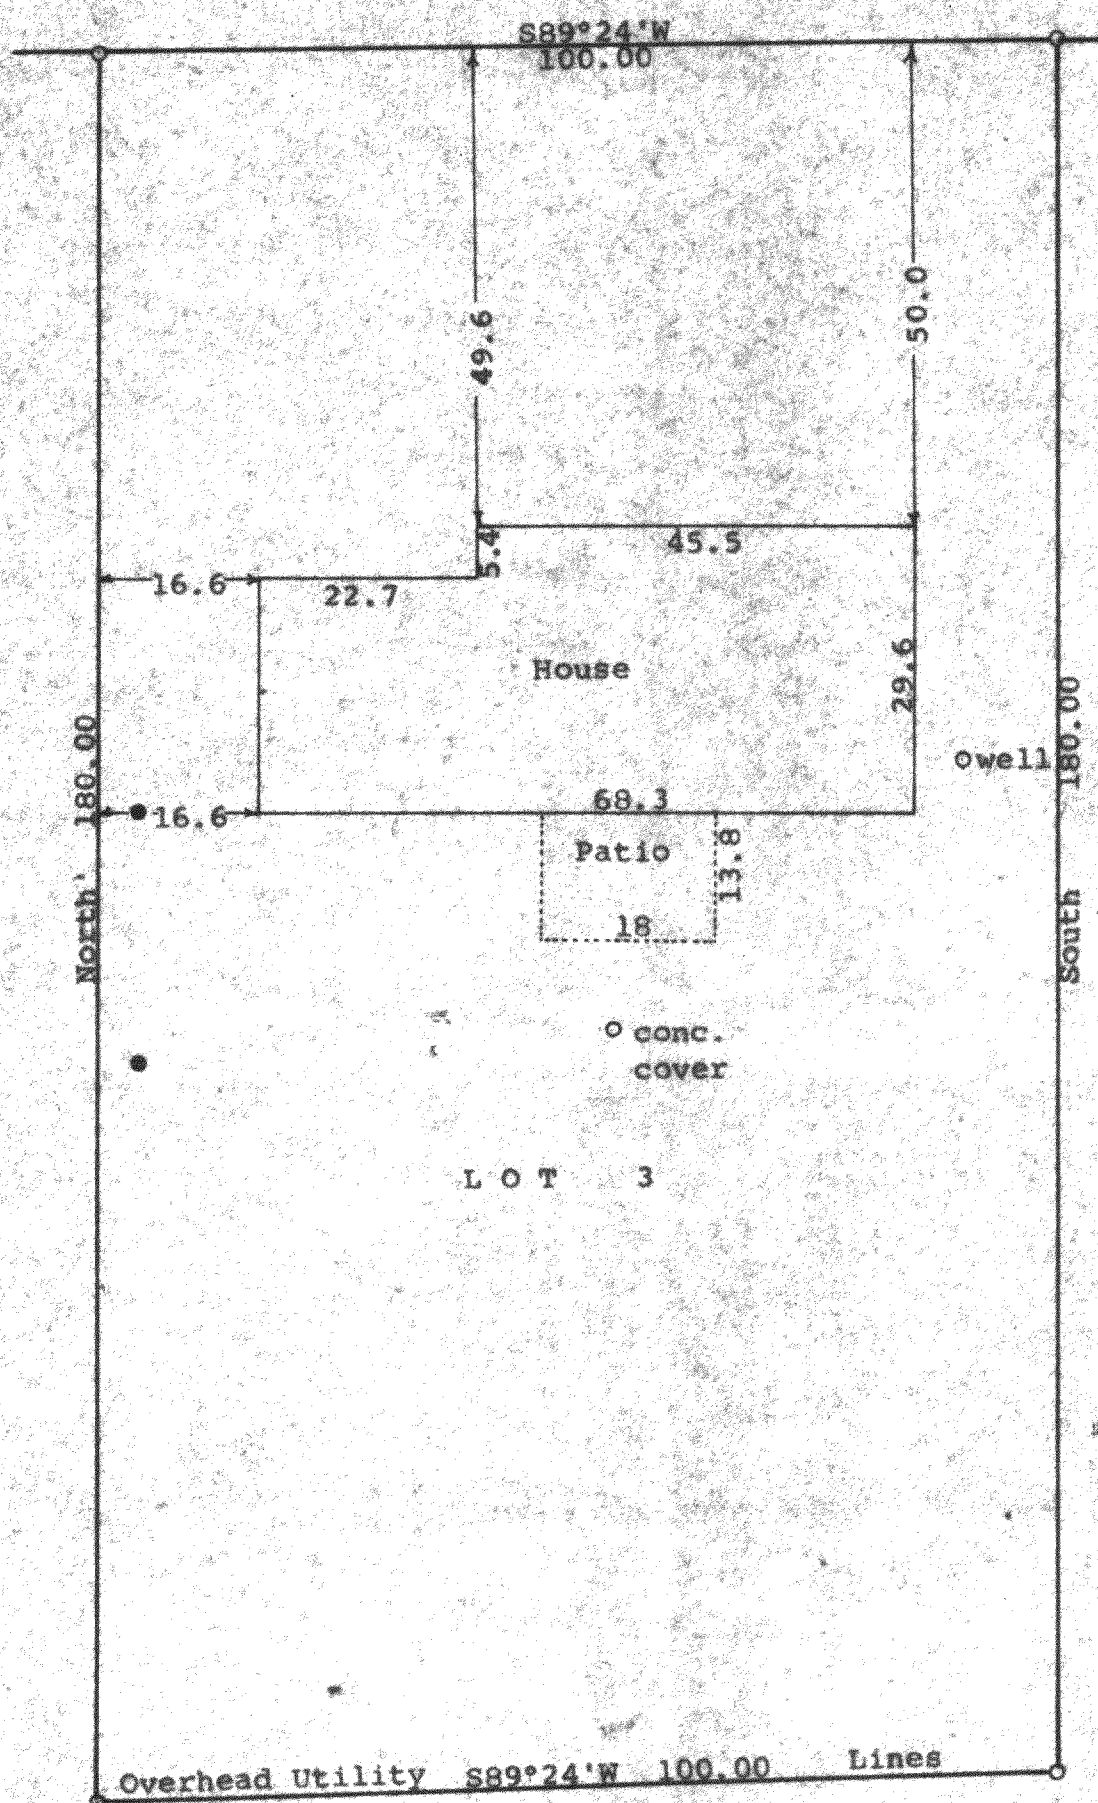

Scale - 1" = 20'

○ = 1" Iron Pipe Found

● = Clothes Line Pole

Bearings are those shown on the recorded plat of Hansen's Subdivision

Survey ordered by: Harold De Weerd
854 Comus Drive
Delavan, WI 53115

STATE OF WISCONSIN) SS
COUNTY OF WALWORTH)

I, George T. Dunham, Surveyor, certify that I have surveyed the property described as follows:



Lot 3 in Block 2 of Hansen's Subdivision located in Section 8.

T 2 N, R 16 E, Walworth County, Wisconsin,

and that the plat shown hereon is a correct representation thereof and shows the size and location of the property, its exterior boundaries, the location of all visible structures and dimensions of all principal buildings thereon, boundary fences, apparent easements, roadways and visible encroachments, if any, and that I have surveyed the property hereon described, according to the official records, to the best of my knowledge and belief.

June 9, 1994

George T. Dunham
George T. Dunham, Surveyor

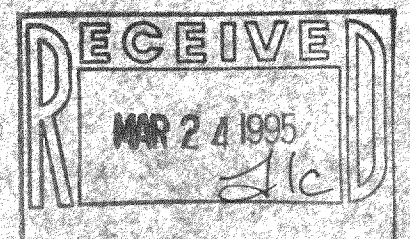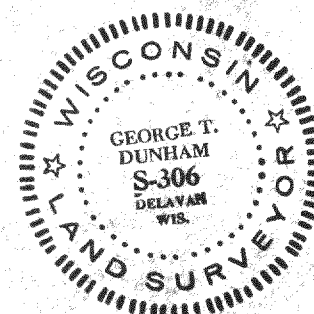

FH-11

216-2086