


DUNHAM SURVEYING, S.C.
SURVEYING & SUBDIVIDING
DELAVAN, WISCONSIN 53115

N

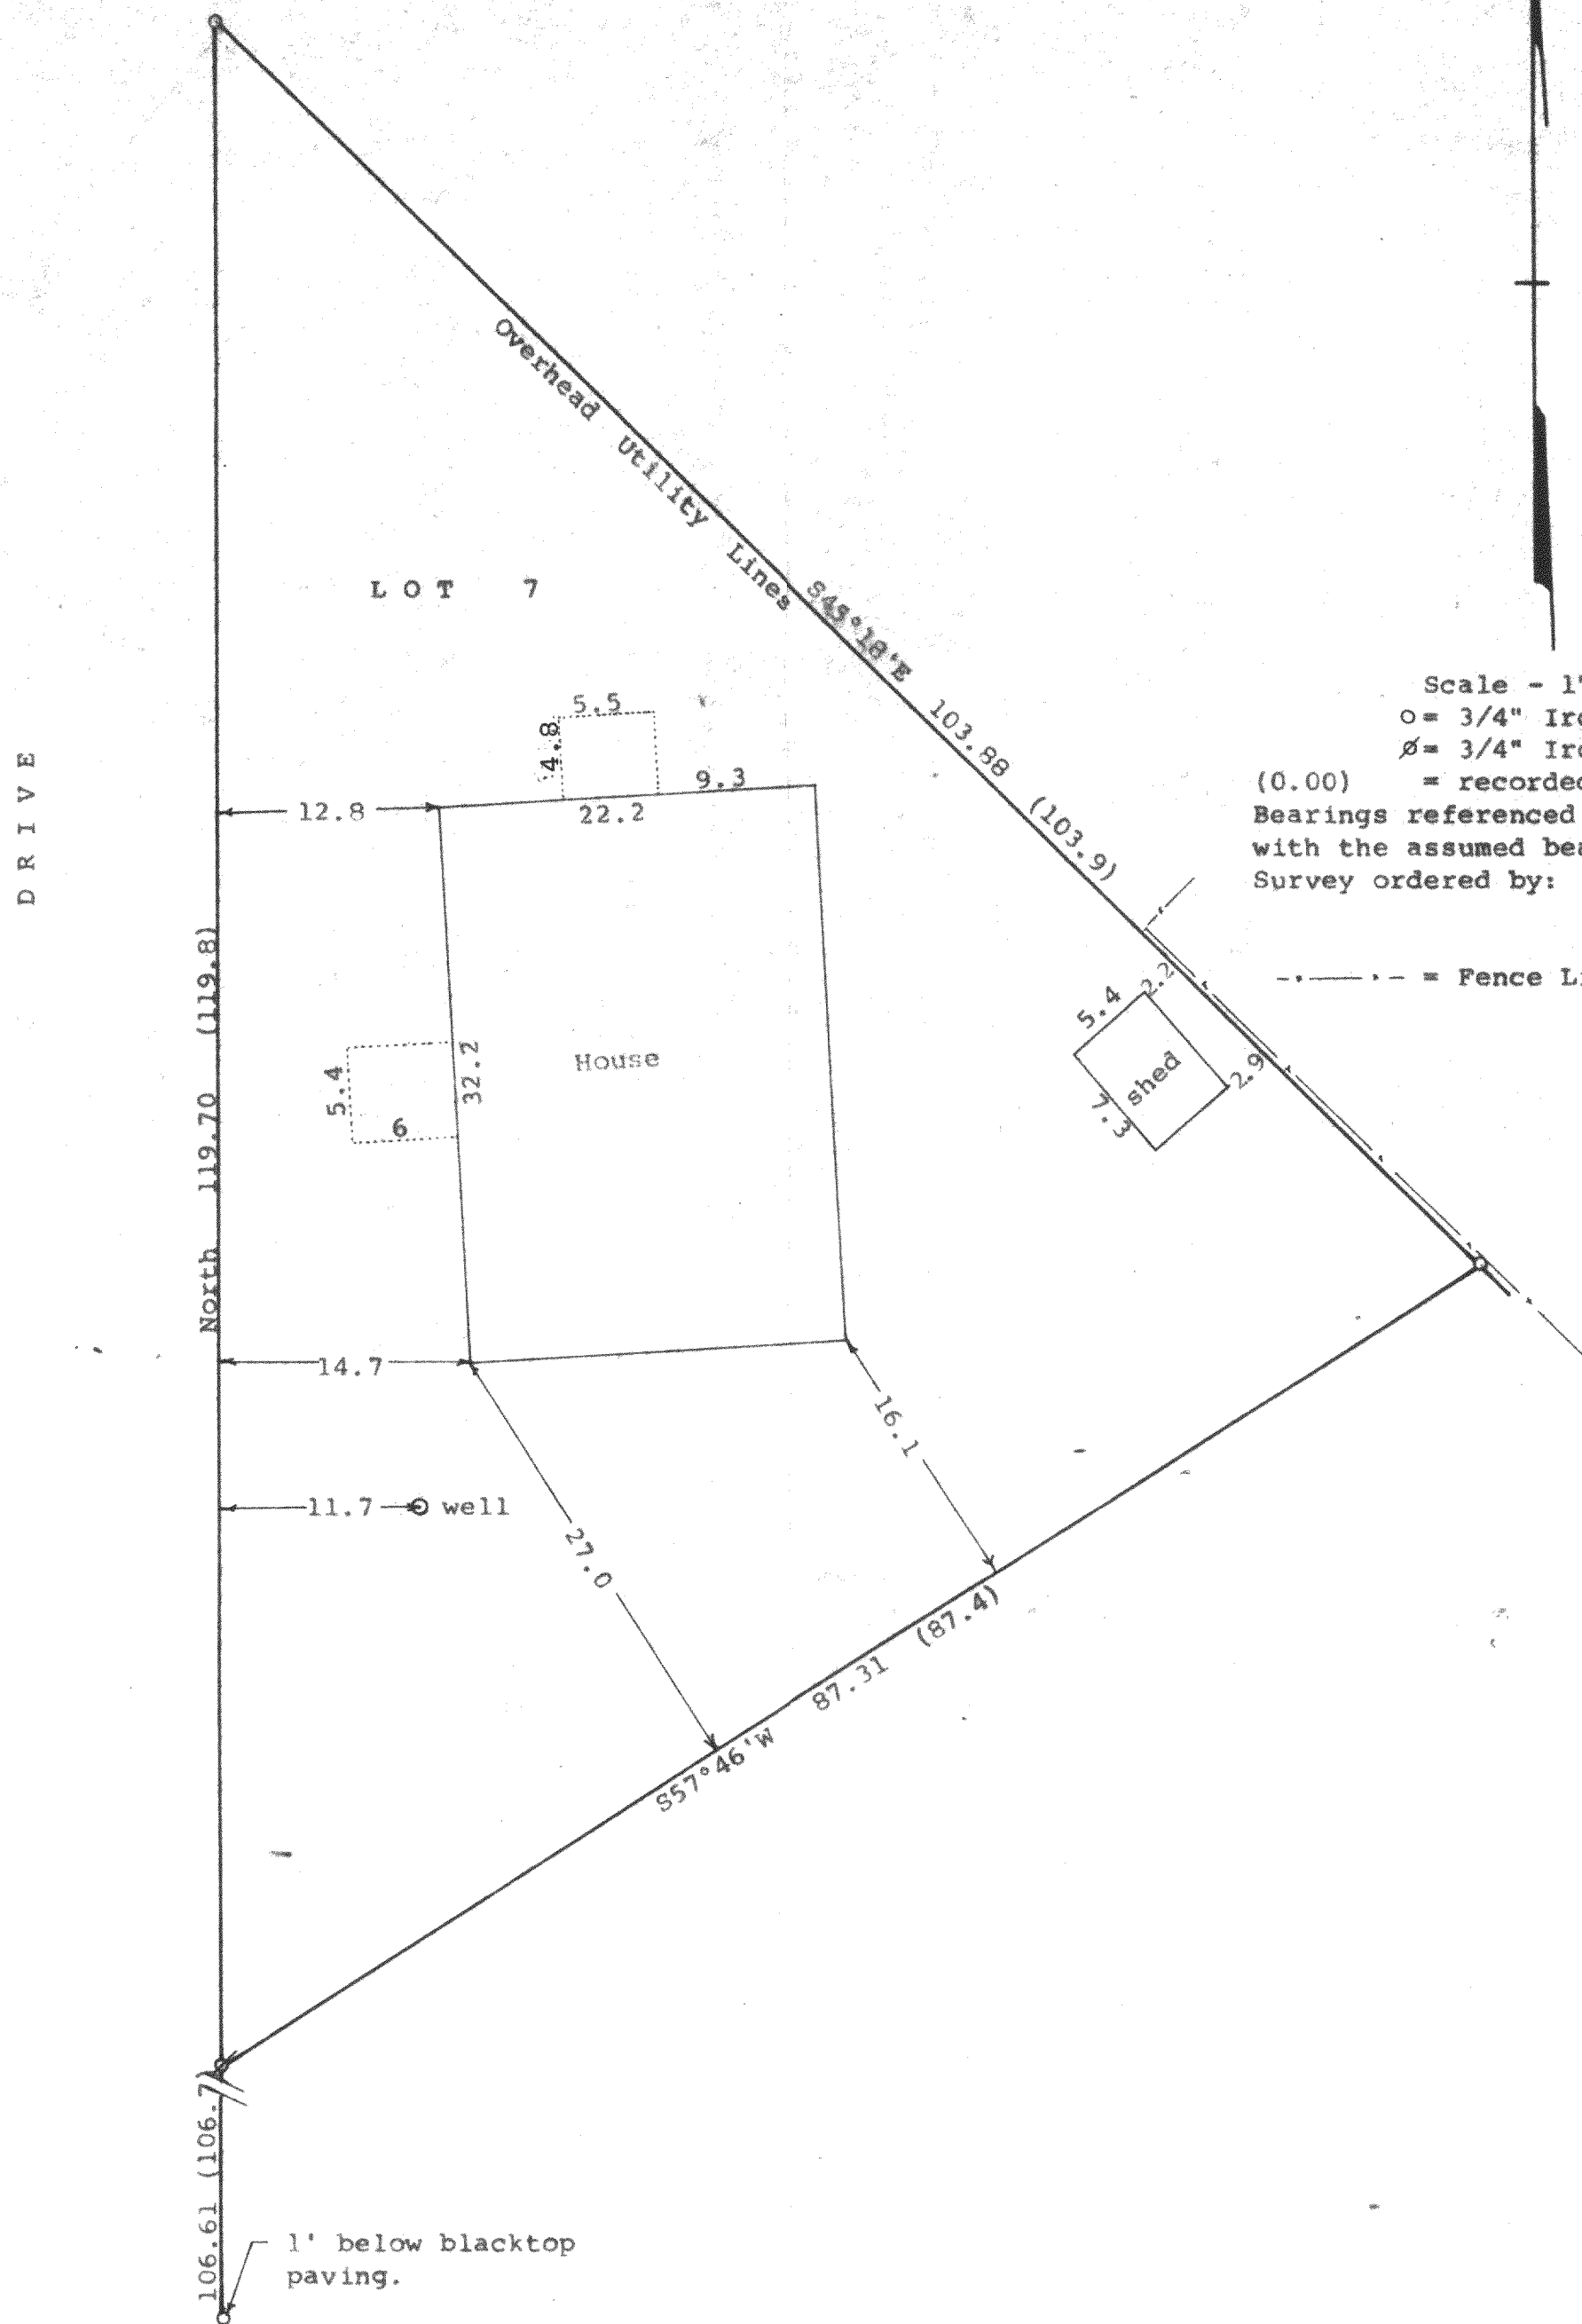

Scale - 1" = 10'
O = 3/4" Iron Pipe Found
Ø = 3/4" Iron Pipe Found crooked & reset
(0.00) = recorded distance
Bearings referenced to the east line of West Drive
with the assumed bearing of North
Survey ordered by: Diane Gange Landers
4308 West Drive
Delavan, WI 53115
--- = Fence Line



STATE OF WISCONSIN)
COUNTY OF WALWORTH) SS

I, George T. Dunham, Surveyor, certify that I have surveyed the property described as follows:

Lot 7 in Block 6 of South Shore Manor, a subdivision located in Section 32, T 2 N, R 16 E, Walworth County, Wisconsin and that the plat shown hereon is a correct representation thereof and shows the size and location of the property, its exterior boundaries, the location of all visible structures and dimensions of all principal buildings thereon, boundary fences, apparent easements, roadways and visible encroachments, if any, and that I have surveyed the property hereon described, according to the official records, to the best of my knowledge and belief.

July 26, 1994

George T. Dunham
George T. Dunham, Surveyor

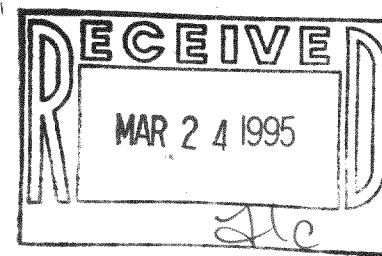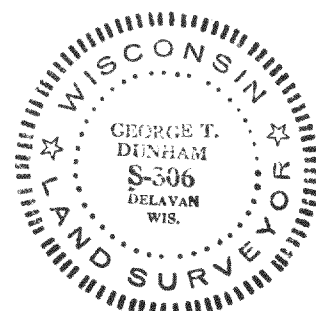

PSS-80

216-2087