
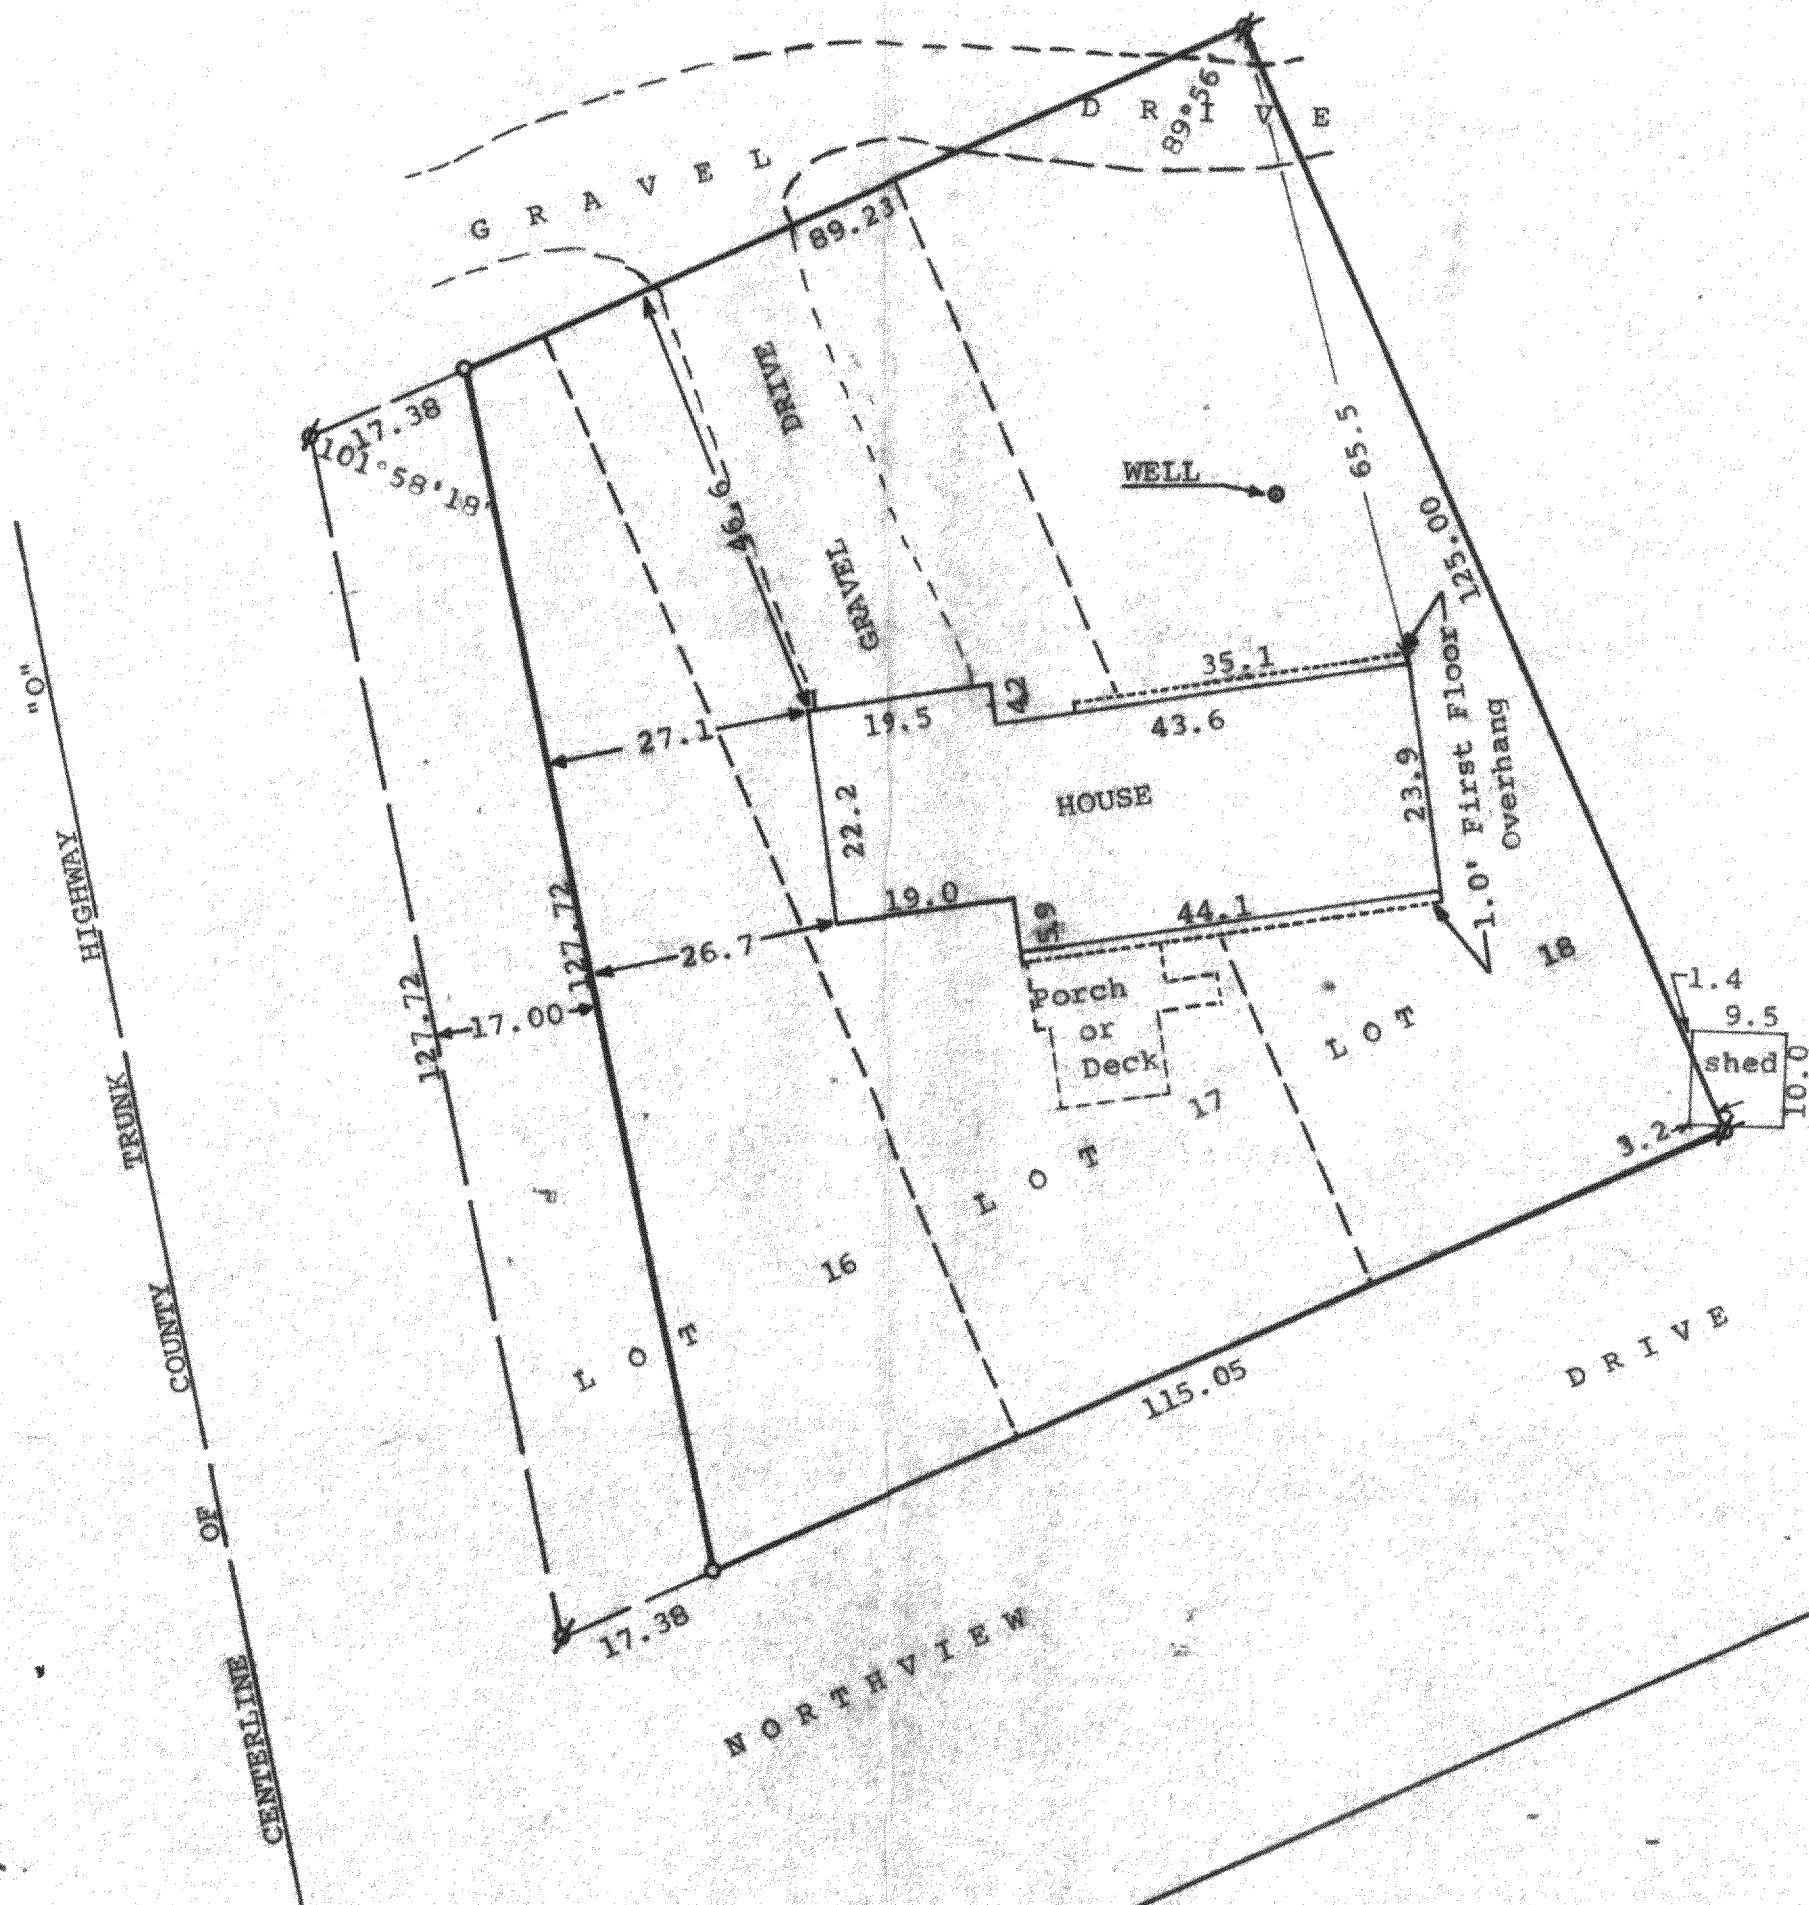


DUNHAM SURVEYING, S.C.
SURVEYING & SUBDIVIDING
DELAVER, WISCONSIN 53115

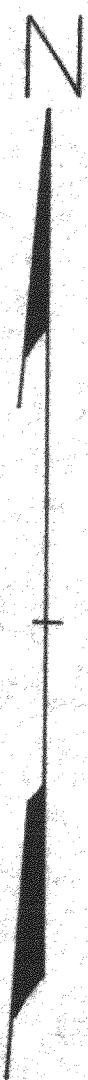

Scale - 1" = 20'
Ø = Iron Pipe Found
o = Iron Pipe Set

Updating and recertification ordered by:
The Rauland Agency
118 Kenosha Street
Walworth, WI 53184

STATE OF WISCONSIN)
COUNTY OF WALWORTH) SS

I, James M. Dunham, Surveyor, certify that I have surveyed the property described as follows:

Lots 16, 17, and 18, EXCEPTING the Westerly 17.00 feet of Lot 16, Block 9, all in the Delavan Lake View Crest Subdivision, Section 31, T2N, R16E, Walworth County, Wisconsin.

and the above map is a true representation thereof and shows the size and location of the property, its exterior boundaries, the location and dimensions of all structures thereon, fences, apparent easements and roadways and visible encroachments, if any.



This survey is made for the exclusive use of the present owners of the property, and also those who purchase, mortgage, or guarantee the title thereto within one (1) year from date hereof; and as to them I warrant the accuracy of said survey and map.

October 9, 1978

Updated and recertified to this
21st day of December, 1993

James M. Dunham
James M. Dunham, Surveyor

George T. Dunham
George T. Dunham, Surveyor

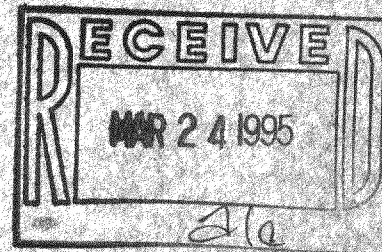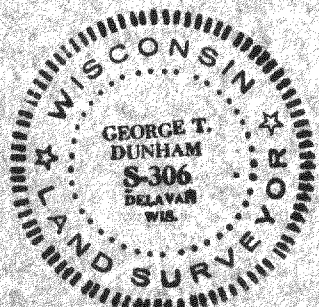

FDLV-200

216-2097

216-576