


GEORGE T. DUNHAM
SURVEYING & SUBDIVIDING
DELAVER, WISCONSIN

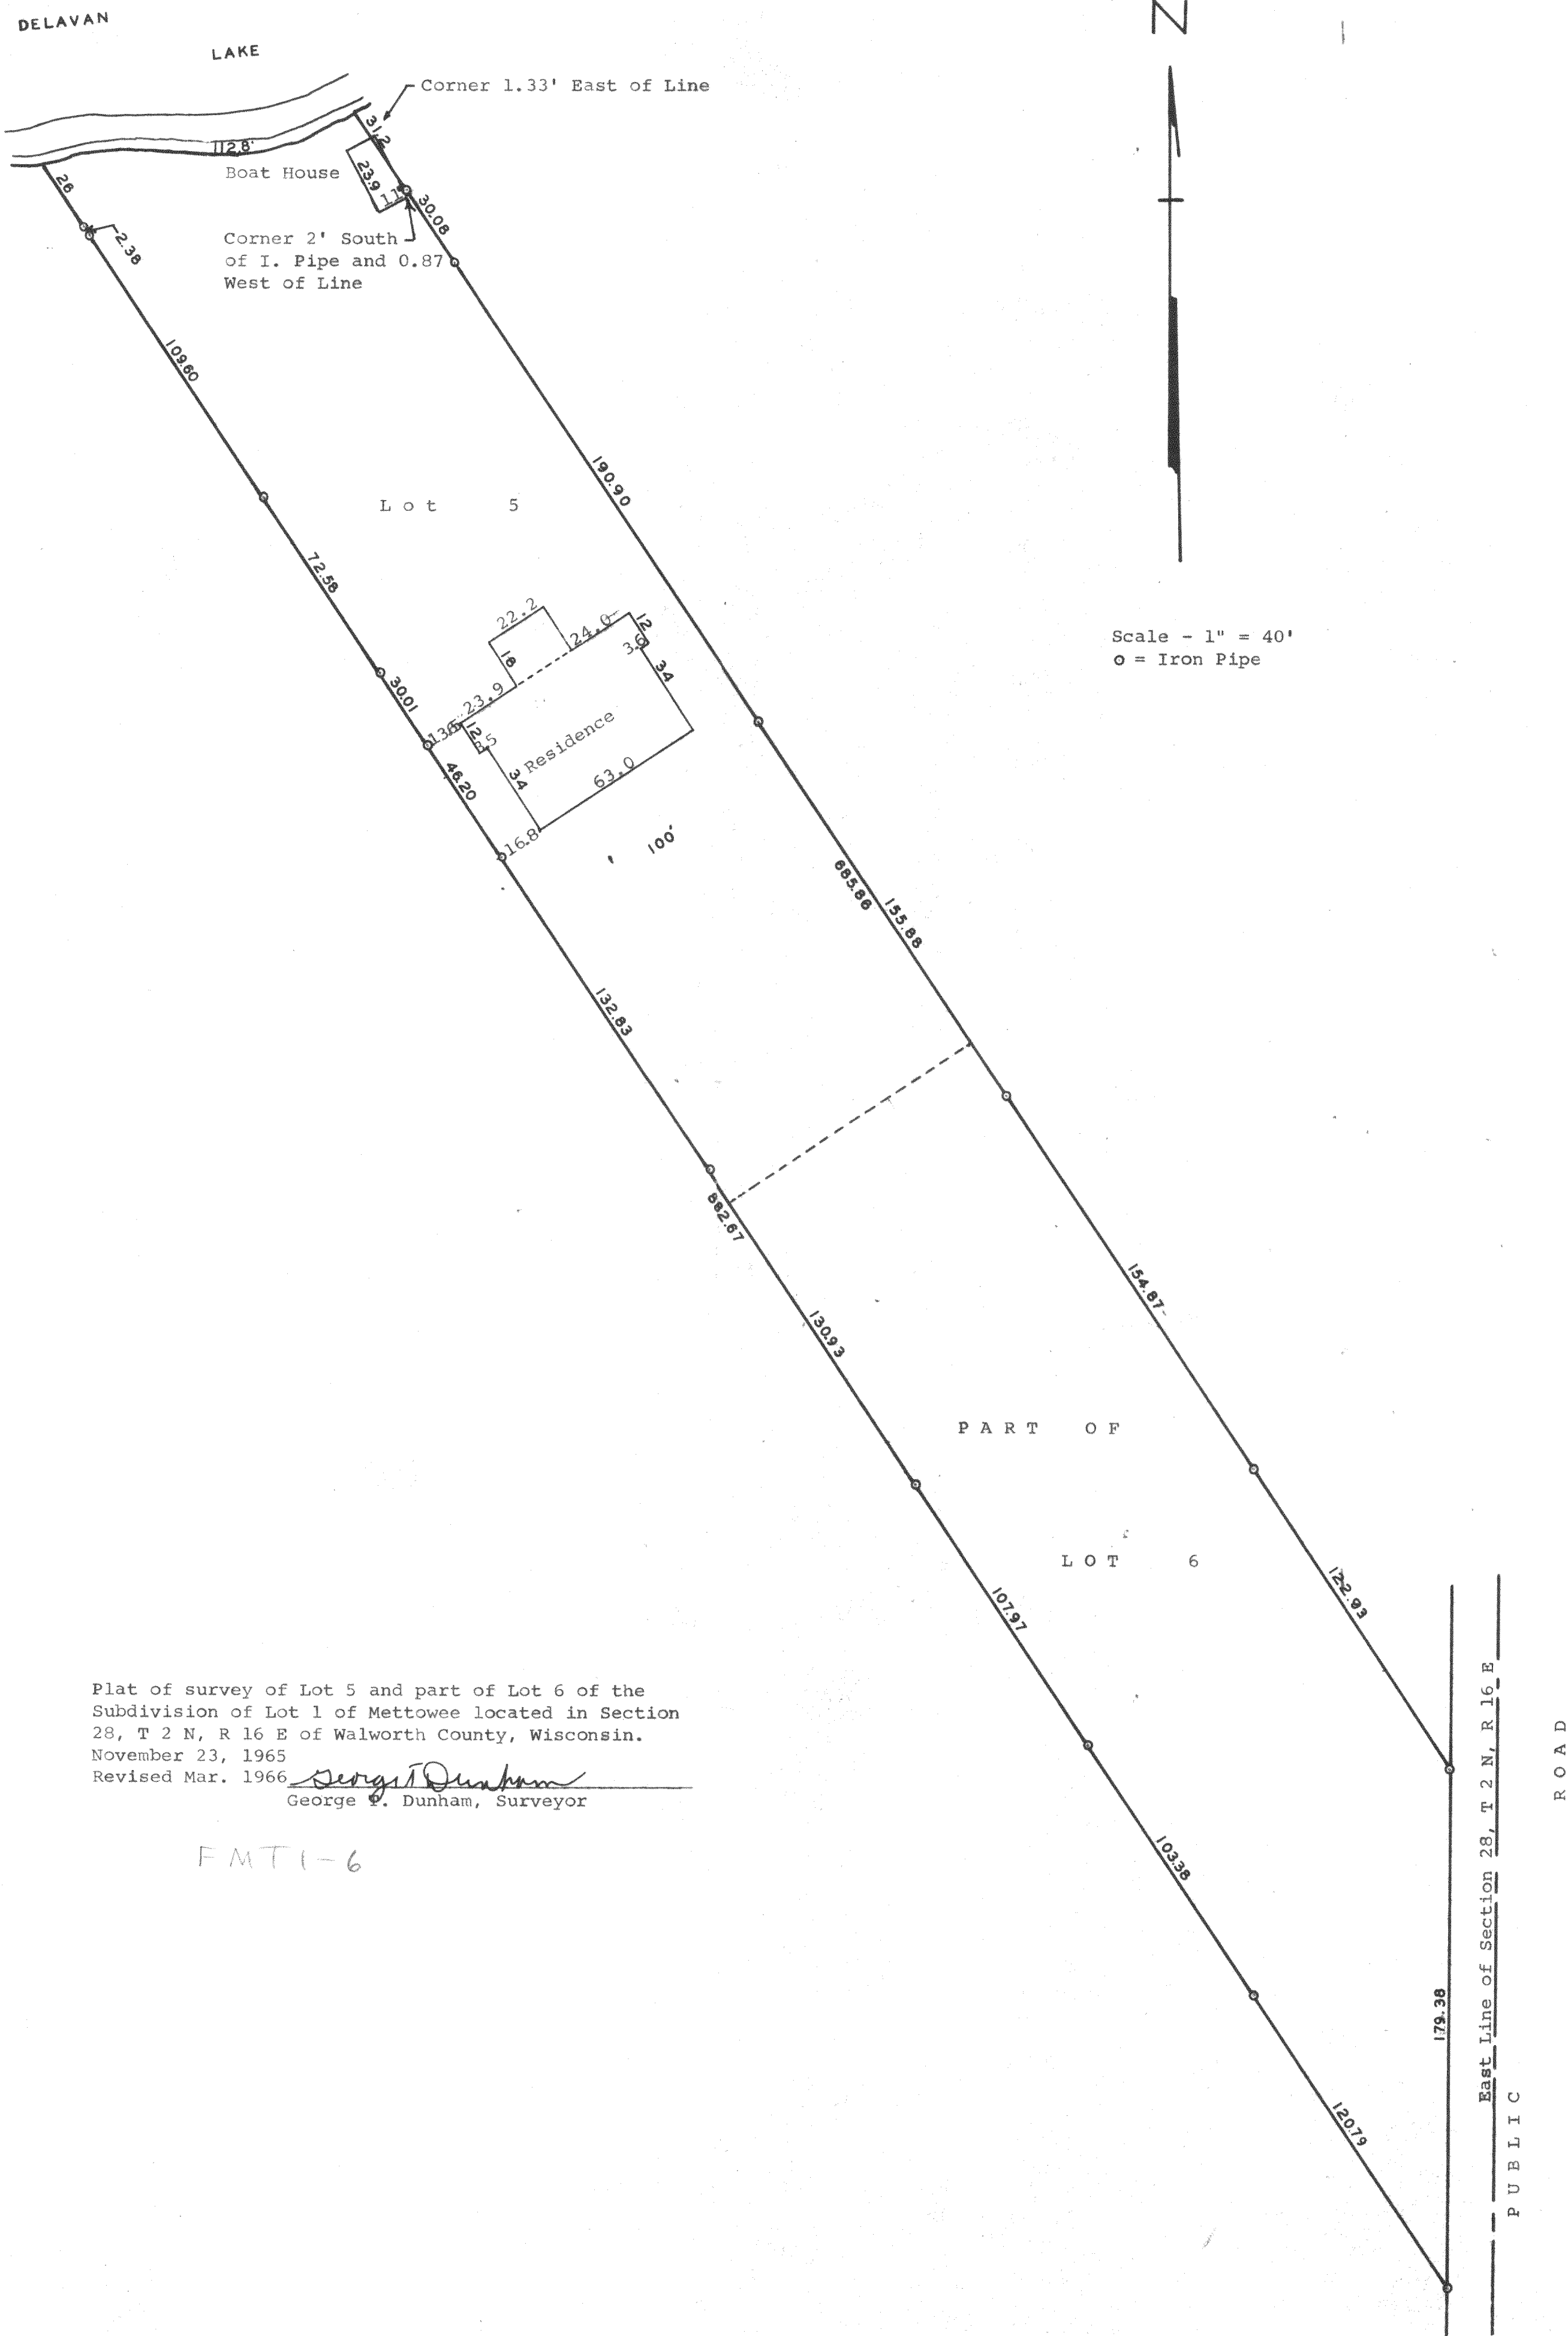

Plat of survey of Lot 5 and part of Lot 6 of the
Subdivision of Lot 1 of Mettowee located in Section
28, T 2 N, R 16 E of Walworth County, Wisconsin.
November 23, 1965
Revised Mar. 1966 *George T. Dunham*
George T. Dunham, Surveyor

FMTI-6

FMTI-6