


PLAT OF SURVEY
-OF-


A PARCEL OF LAND LOCATED IN THE NORTHEAST 1/4 OF FRACTIONAL SECTION 22, TOWNSHIP 2 NORTH, RANGE 16 EAST OF THE FOURTH PRINCIPAL MERIDIAN, IN THE TOWN OF DELAVAN, WALWORTH COUNTY, WISCONSIN, DESCRIBED AS FOLLOWS: COMMENCING AT THE EAST 1/4 SECTION CORNER OF SAID SECTION 22; THENCE WEST ALONG THE 1/4 SECTION LINE 38.14 FEET TO THE PLACE OF BEGINNING; THENCE CONTINUE WEST ON THE 1/4 SECTION LINE 191.71 FEET TO A POINT IN THE CENTERLINE OF STATE TRUNK HIGHWAY NO. 50; THENCE NORTH 29°20' WEST ALONG SAID CENTERLINE 106.29 FEET TO A POINT; THENCE NORTH 38°43' EAST 198.87 FEET TO A POINT; THENCE SOUTH 25°45' EAST 274.91 FEET TO SAID 1/4 SECTION LINE AND THE PLACE OF BEGINNING.

SURVEY FOR: DON SCHULTZ
SURVEY LOCATION: 102 S.T.H. "50"


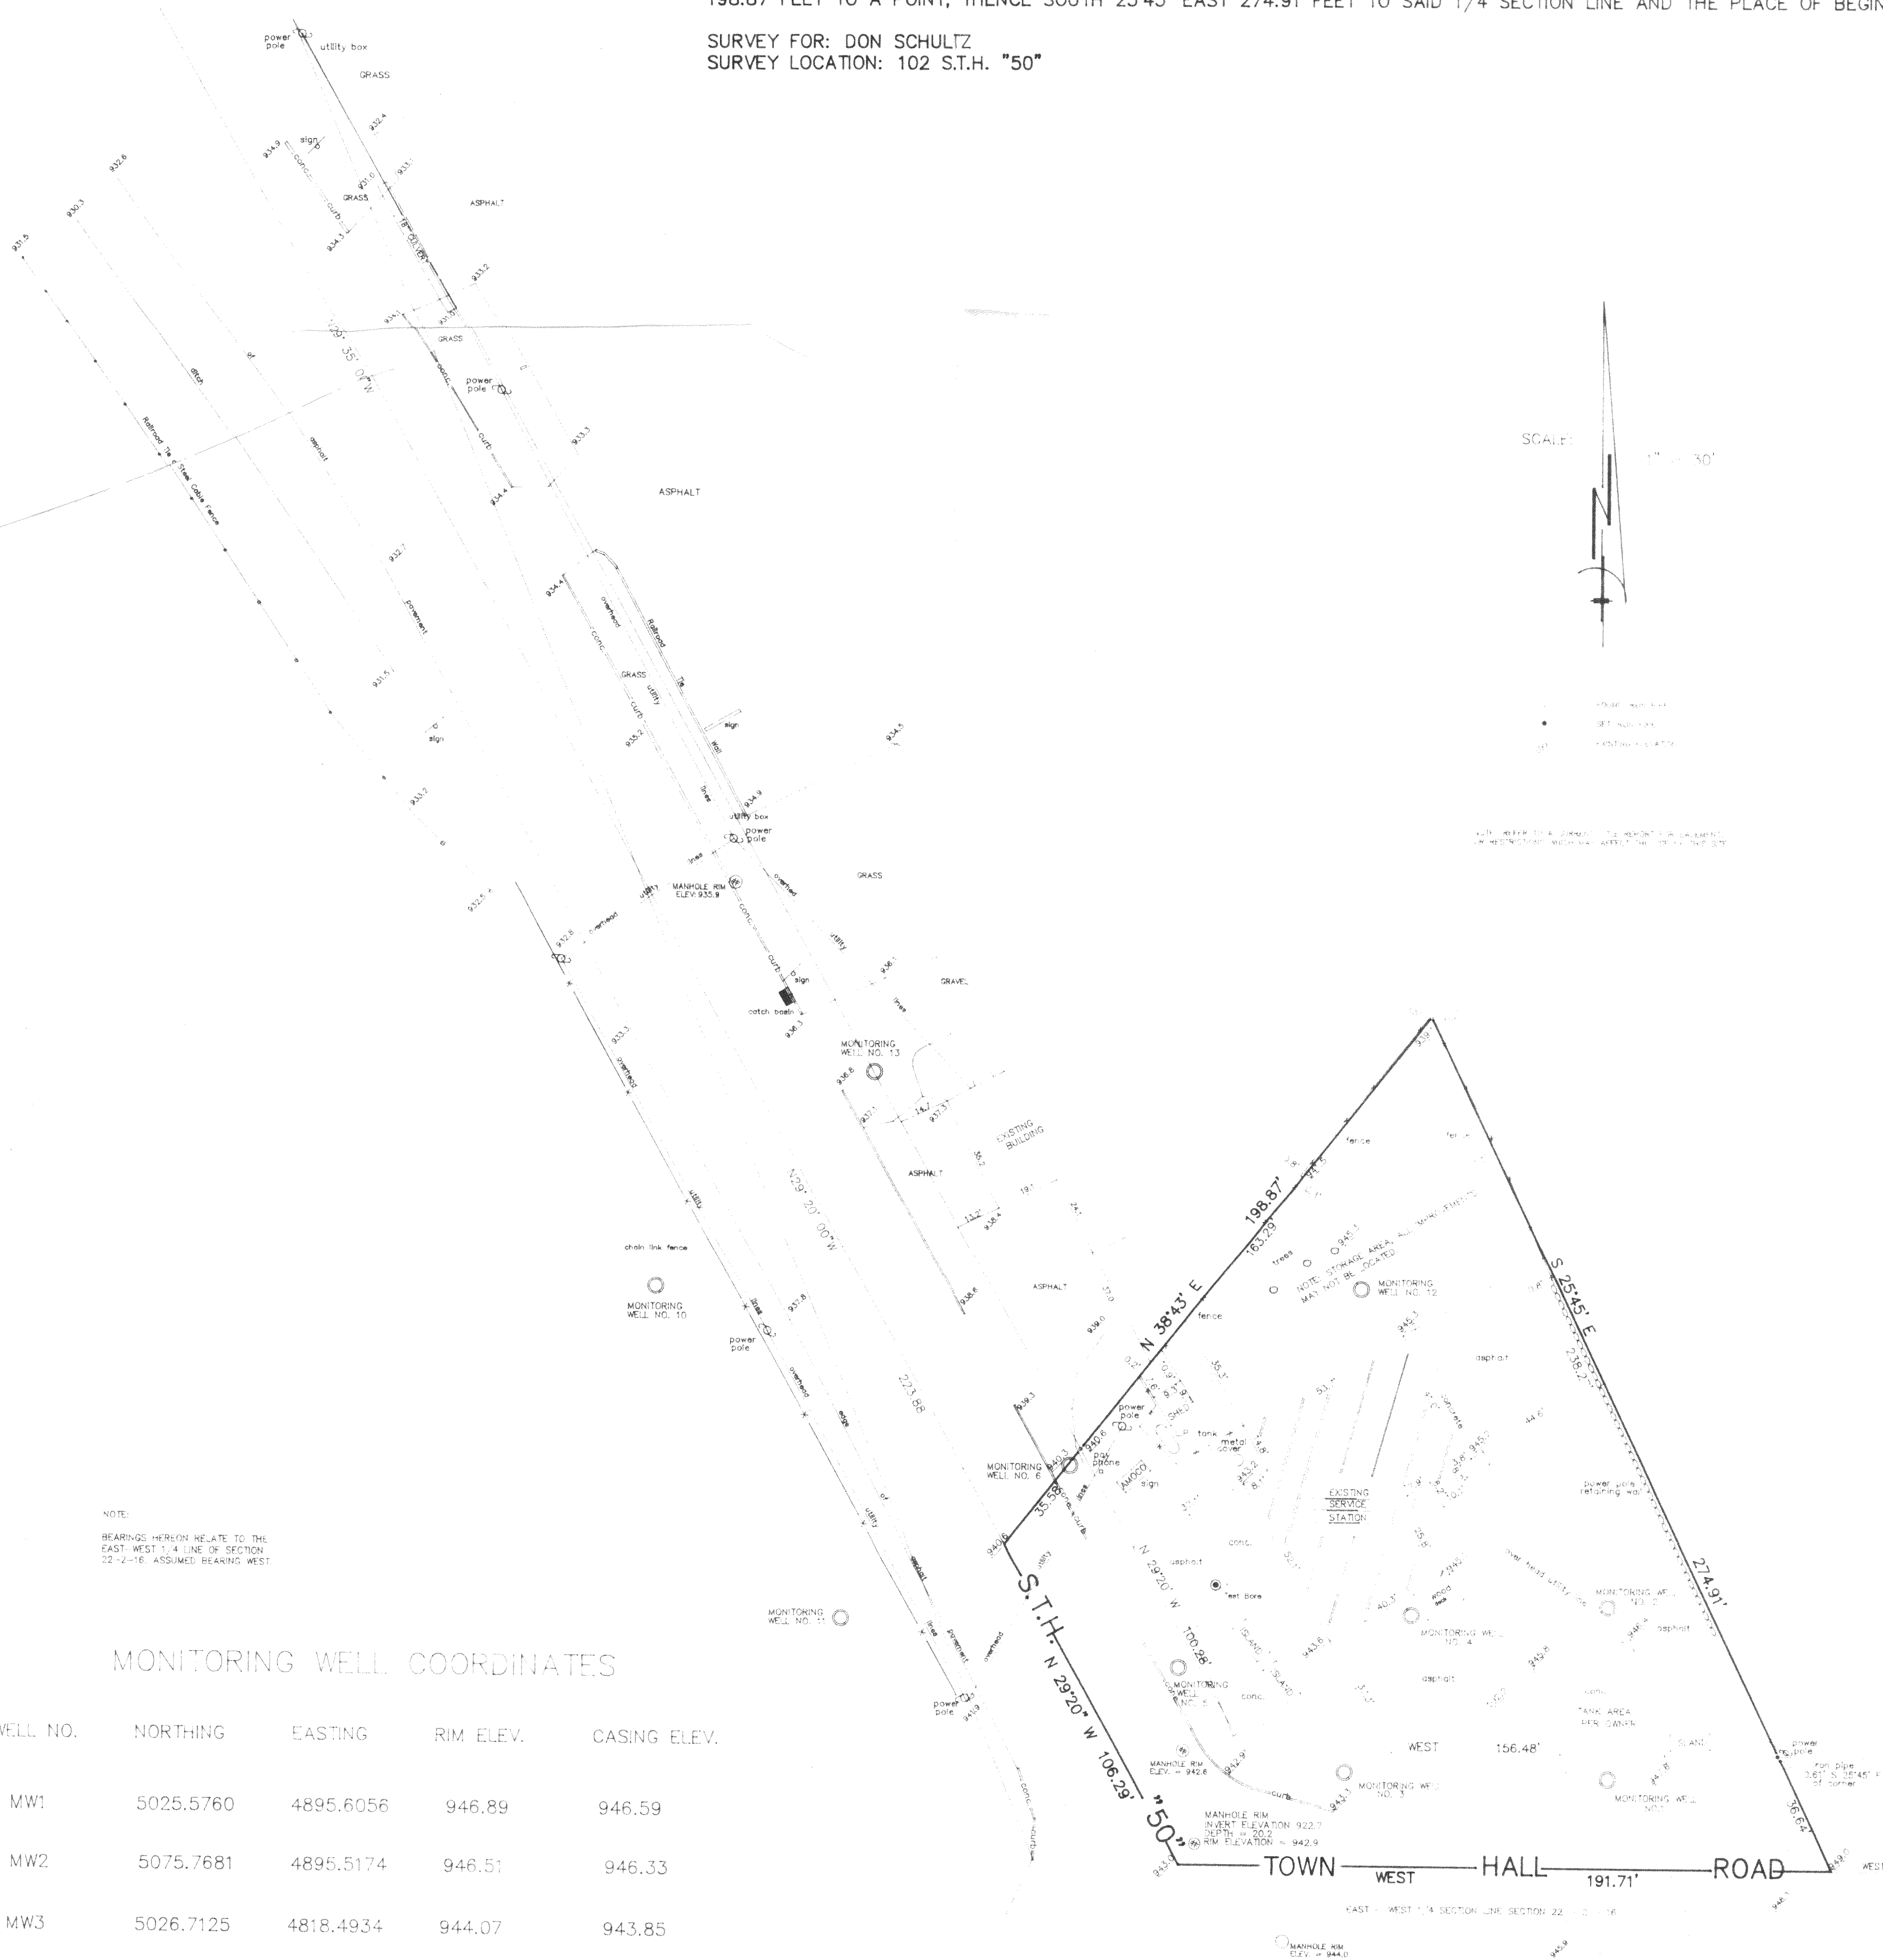


MONITORING WELL COORDINATES

WELL NO.	NORTHING	EASTING	RIM ELEV.	CASING ELEV.
MW1	5025.5760	4895.6056	946.89	946.59
MW2	5075.7681	4895.5174	946.51	946.33
MW3	5026.7125	4818.4934	944.07	943.85
MW4	5072.9004	4837.5955	944.32	943.96
MW5	5057.0587	4769.7239	942.60	942.28
MW6	5115.4781	4737.3380	940.43	939.98
TEST BORE	5081.44	4780.52	942.8	
MW10	5166.4912	4615.2203	935.69	935.39
MW11	5070.6708	4671.0795	938.53	938.02
MW12	5167.4776	4822.4340	943.50	942.93
MW13	5229.9537	4678.6634	936.99	936.27

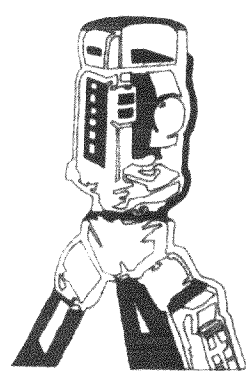

B.W. SURVEYING
35117 ACADEMY ROAD
BURLINGTON, WI 53105
(414)-534-4109

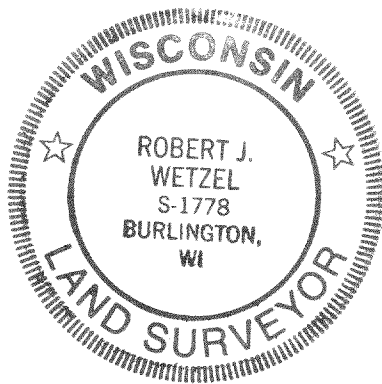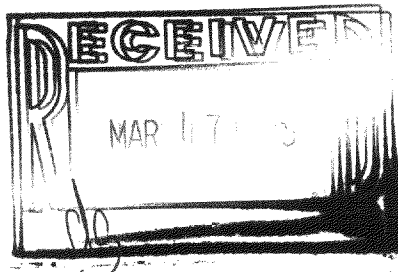

Robert J. Wetzel
ROBERT J. WETZEL S-1778

DRAWN BY:	BW	DATE:	REVISED: 9-27-94 AUGUST 19, 1994
CHECKED BY:	BW	DRAWING NO.:	1768d2
JOB NO.:	1768	SHEET	1 OF 1