


Rt. 3, Box 273
Elkhorn, Wisconsin 53121
Phone: (414) 723-4260 (office)
(414) 723-7209 (FAX)

LOTS 4, 5 AND 6 OF BLOCK 11 OF
DELMAR SUBDIVISION, LOCATED IN
SECTION 27, TOWN 2 NORTH. RANGE
16 EAST, TOWN OF DELAVAN,
WALWORTH COUNTY, WISCONSIN.

OWNERS: ALBERT AND JEAN NEUMANN
2816 MABIE ST.
DELAVAN, WI. 53115

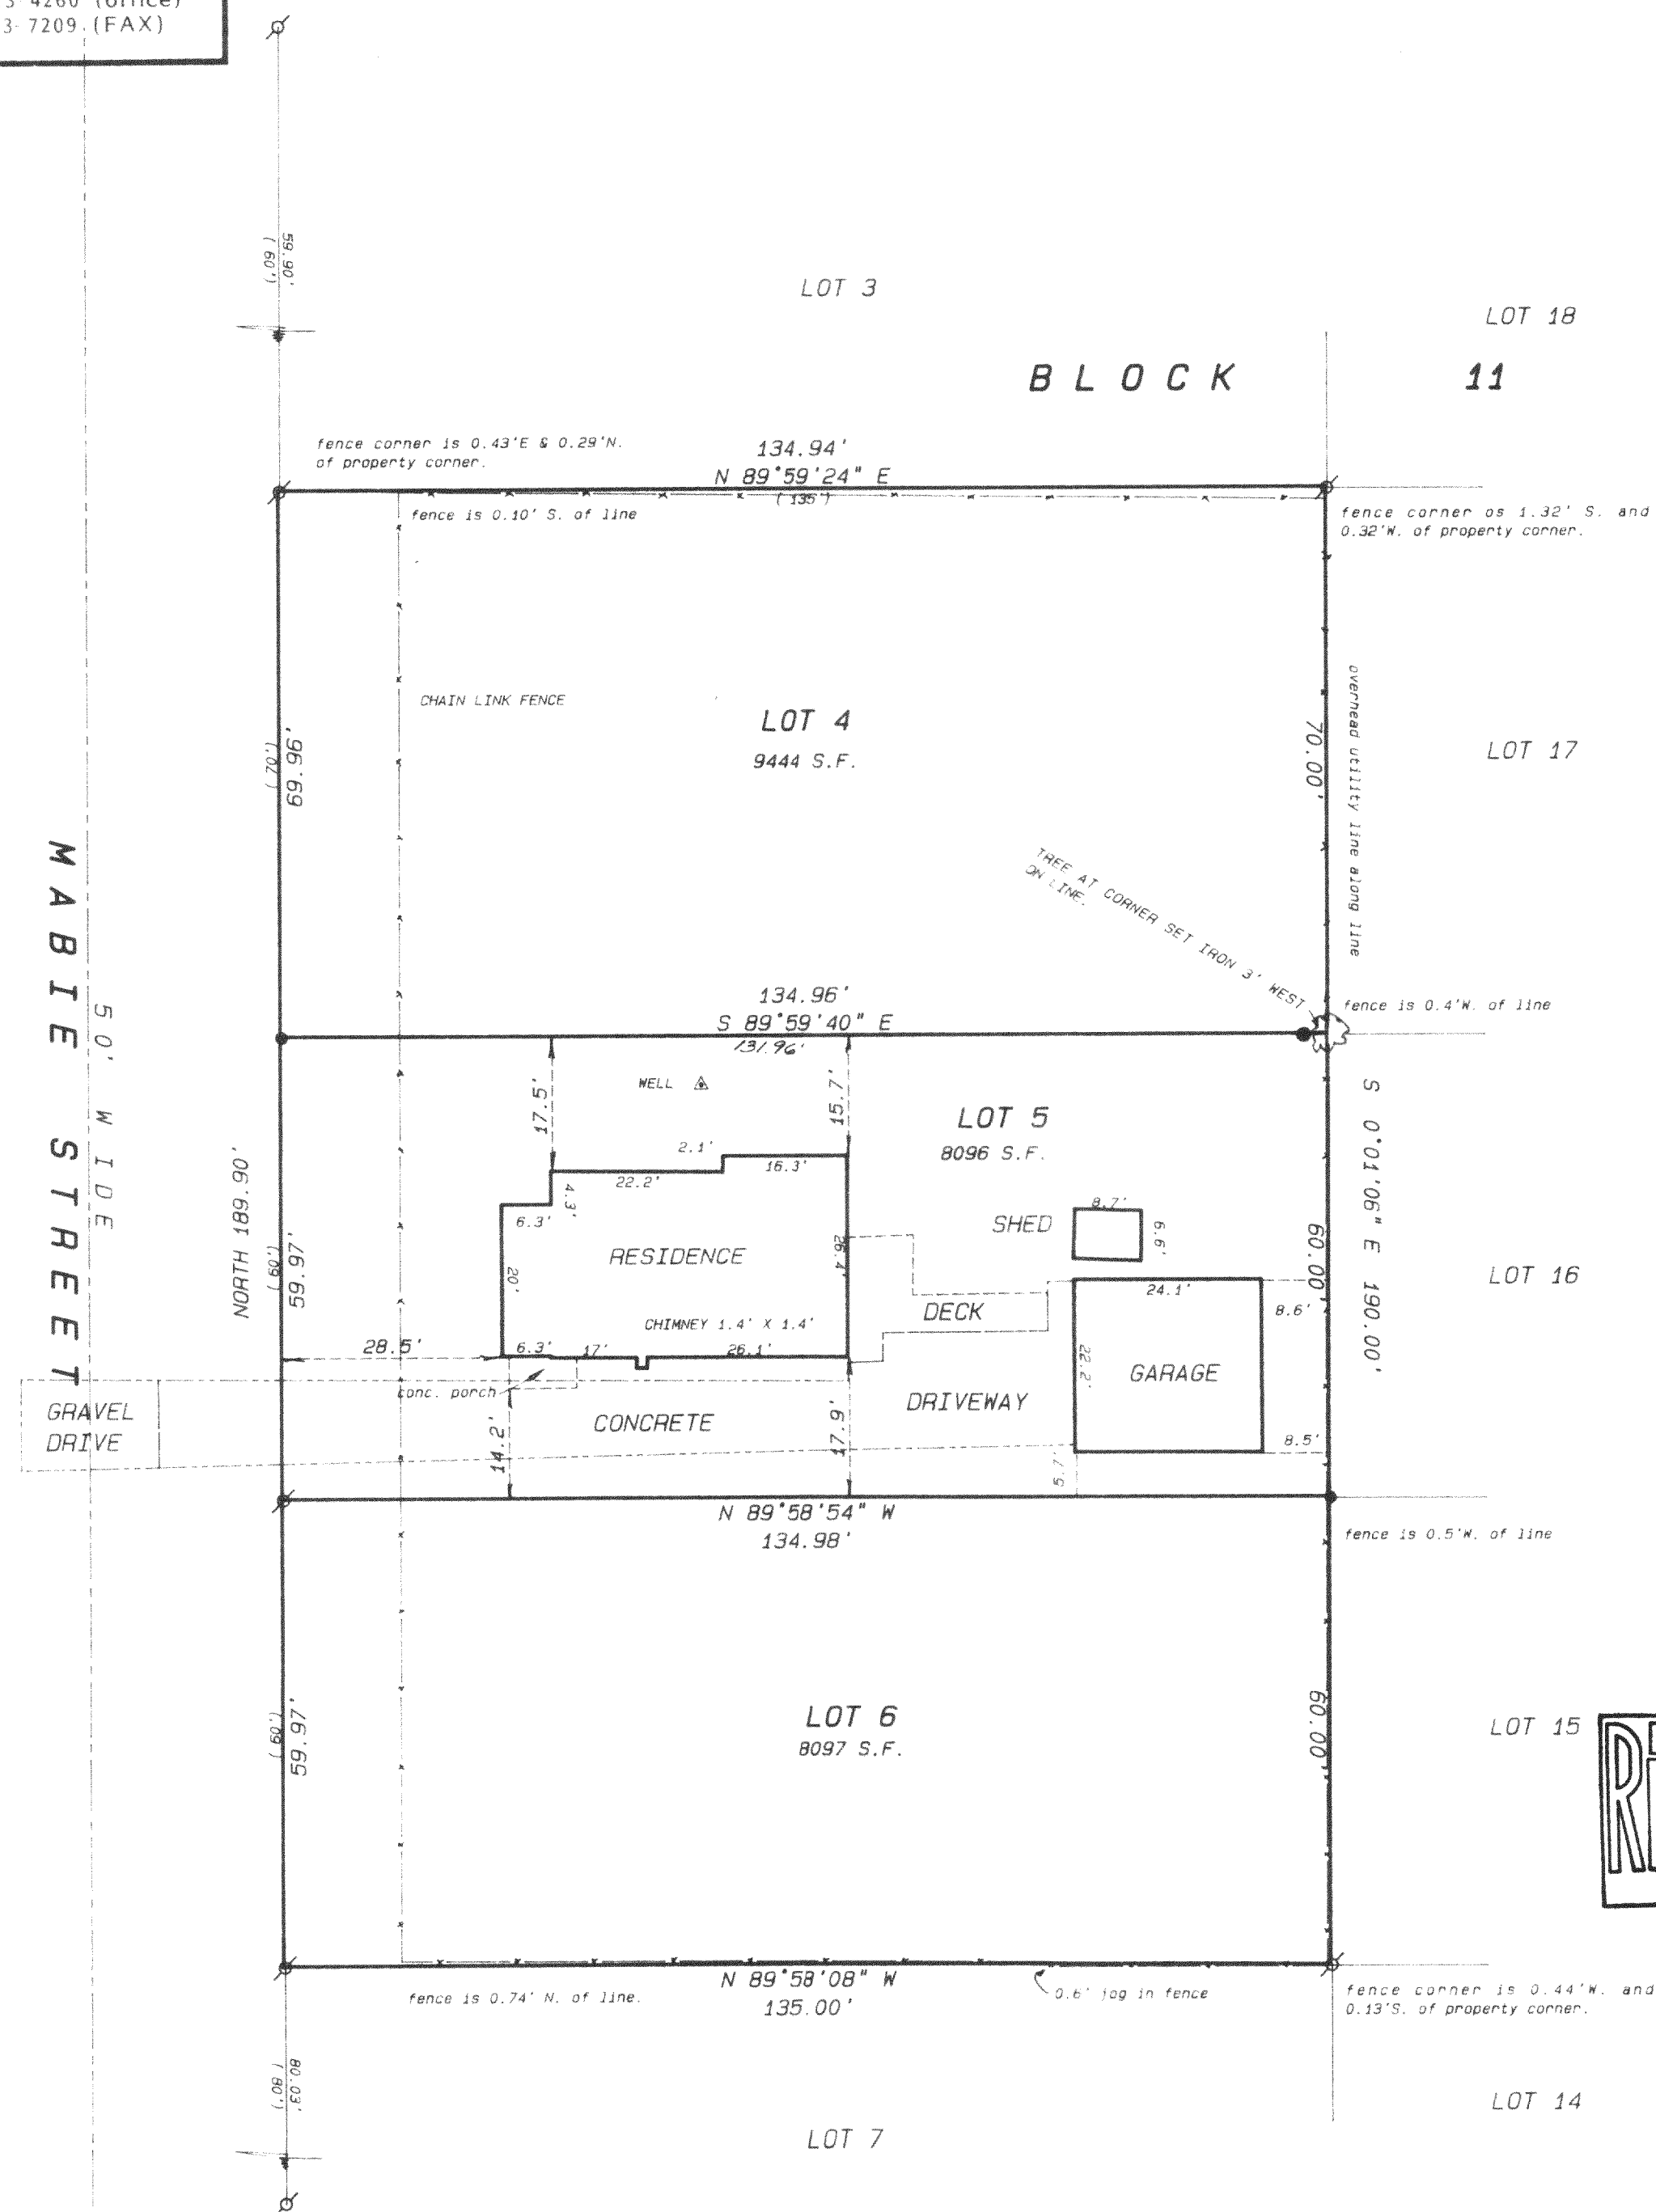

SCALE 1" = 20 FEET
BEARINGS ARE REFERENCED TO
PLATTED NORTH

- Legend

- ^ FOUND IRON PIPE
 ● FOUND IRON ROD
 □ FOUND BRASS CAPPED MONUMENT
 ⊗ FOUND CONCRETE MONUMENT
 + CHISEL CUT IN CONCRETE
 ● SET IRON ROD, 24" LONG, WEIGHING
 1.5 LBS./LINEAL FT. 3/4" DIA.
 ● SET IRON ROD, 30" LONG, WEIGHING
 4.5 LBS./LINEAL FT. 1-1/16" DIA.
 (xx) RECORDED AS DIMENSION
 —X—X— EXISTING FENCE

SCALE: 1" = 20 FEET

I, the undersigned, hereby certify that the above described property has been surveyed by me or under my direction and that the above map is a true and correct representation thereof and shows the size and location of the property, its exterior boundaries, the location of all visible structures and dimensions of all principal buildings thereon, boundary fences, apparent easements, roadways and visible encroachments, if any.

I, the undersigned, further certify that I am one of the present owners of the property, and that I have the authority to execute this instrument, and I am either the owner, or one who purchases, mortgages, or guarantees the title thereto within one year from date hereof.

Kenneth B. Amthor

KENNETH B. ABERNATHY, JR.
WISCONSIN REGISTERED LAND SURVEYOR,
S-1594

Date: APRIL 5, 1995 Job No. 95.316

FDM - 47C
FDM - 48