


LOT 8 OF GENEVA WEST ESTATES
LOCATED IN THE SOUTHEAST 1/4 OF SECTION 25, TOWN 2
NORTH, RANGE 16 EAST, WALWORTH COUNTY, WISCONSIN

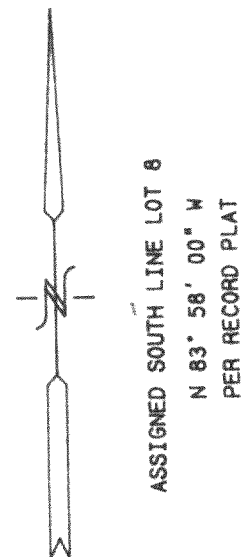


ASSIGNED SOUTH LINE LOT 8
N 83° 58' 00" W
PER RECORD PLAT

RECEIVED
JUL 25 1995


I HEREBY CERTIFY THAT THE ABOVE DESCRIBED PROPERTY HAS BEEN SURVEYED UNDER MY DIRECTION AND THAT THE ABOVE MAP IS A TRUE REPRESENTATION THEREOF AND SHOWS THE SIZE AND LOCATION OF THE PROPERTY AND ITS EXTERIOR BOUNDARIES. THIS SURVEY IS MADE FOR THE USE OF THE PRESENT OWNERS OF THE PROPERTY, AND ALSO THOSE WHO PURCHASE, MORTGAGE, OR GUARANTEE THE TITLE THERETO WITHIN ONE YEAR FROM THE DATE HEREOF.

DATED: 3/27/95
 REVISED 5-30-95 TO SHOW SIZE + LOCAT
 OF RESIDENCE AS BUILT


PETER S. GORDON R.L.S. 2101

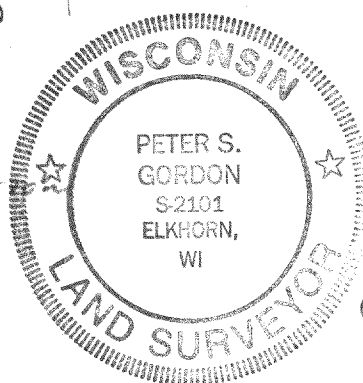

LEGEND
= SET IRON REBAR STAKE
O = FOUND IRON PIPE STAKE
● = FOUND IRON REBAR STAKE
(xxx) = RECORDED AS
xxx = AS BUILT LOCATION

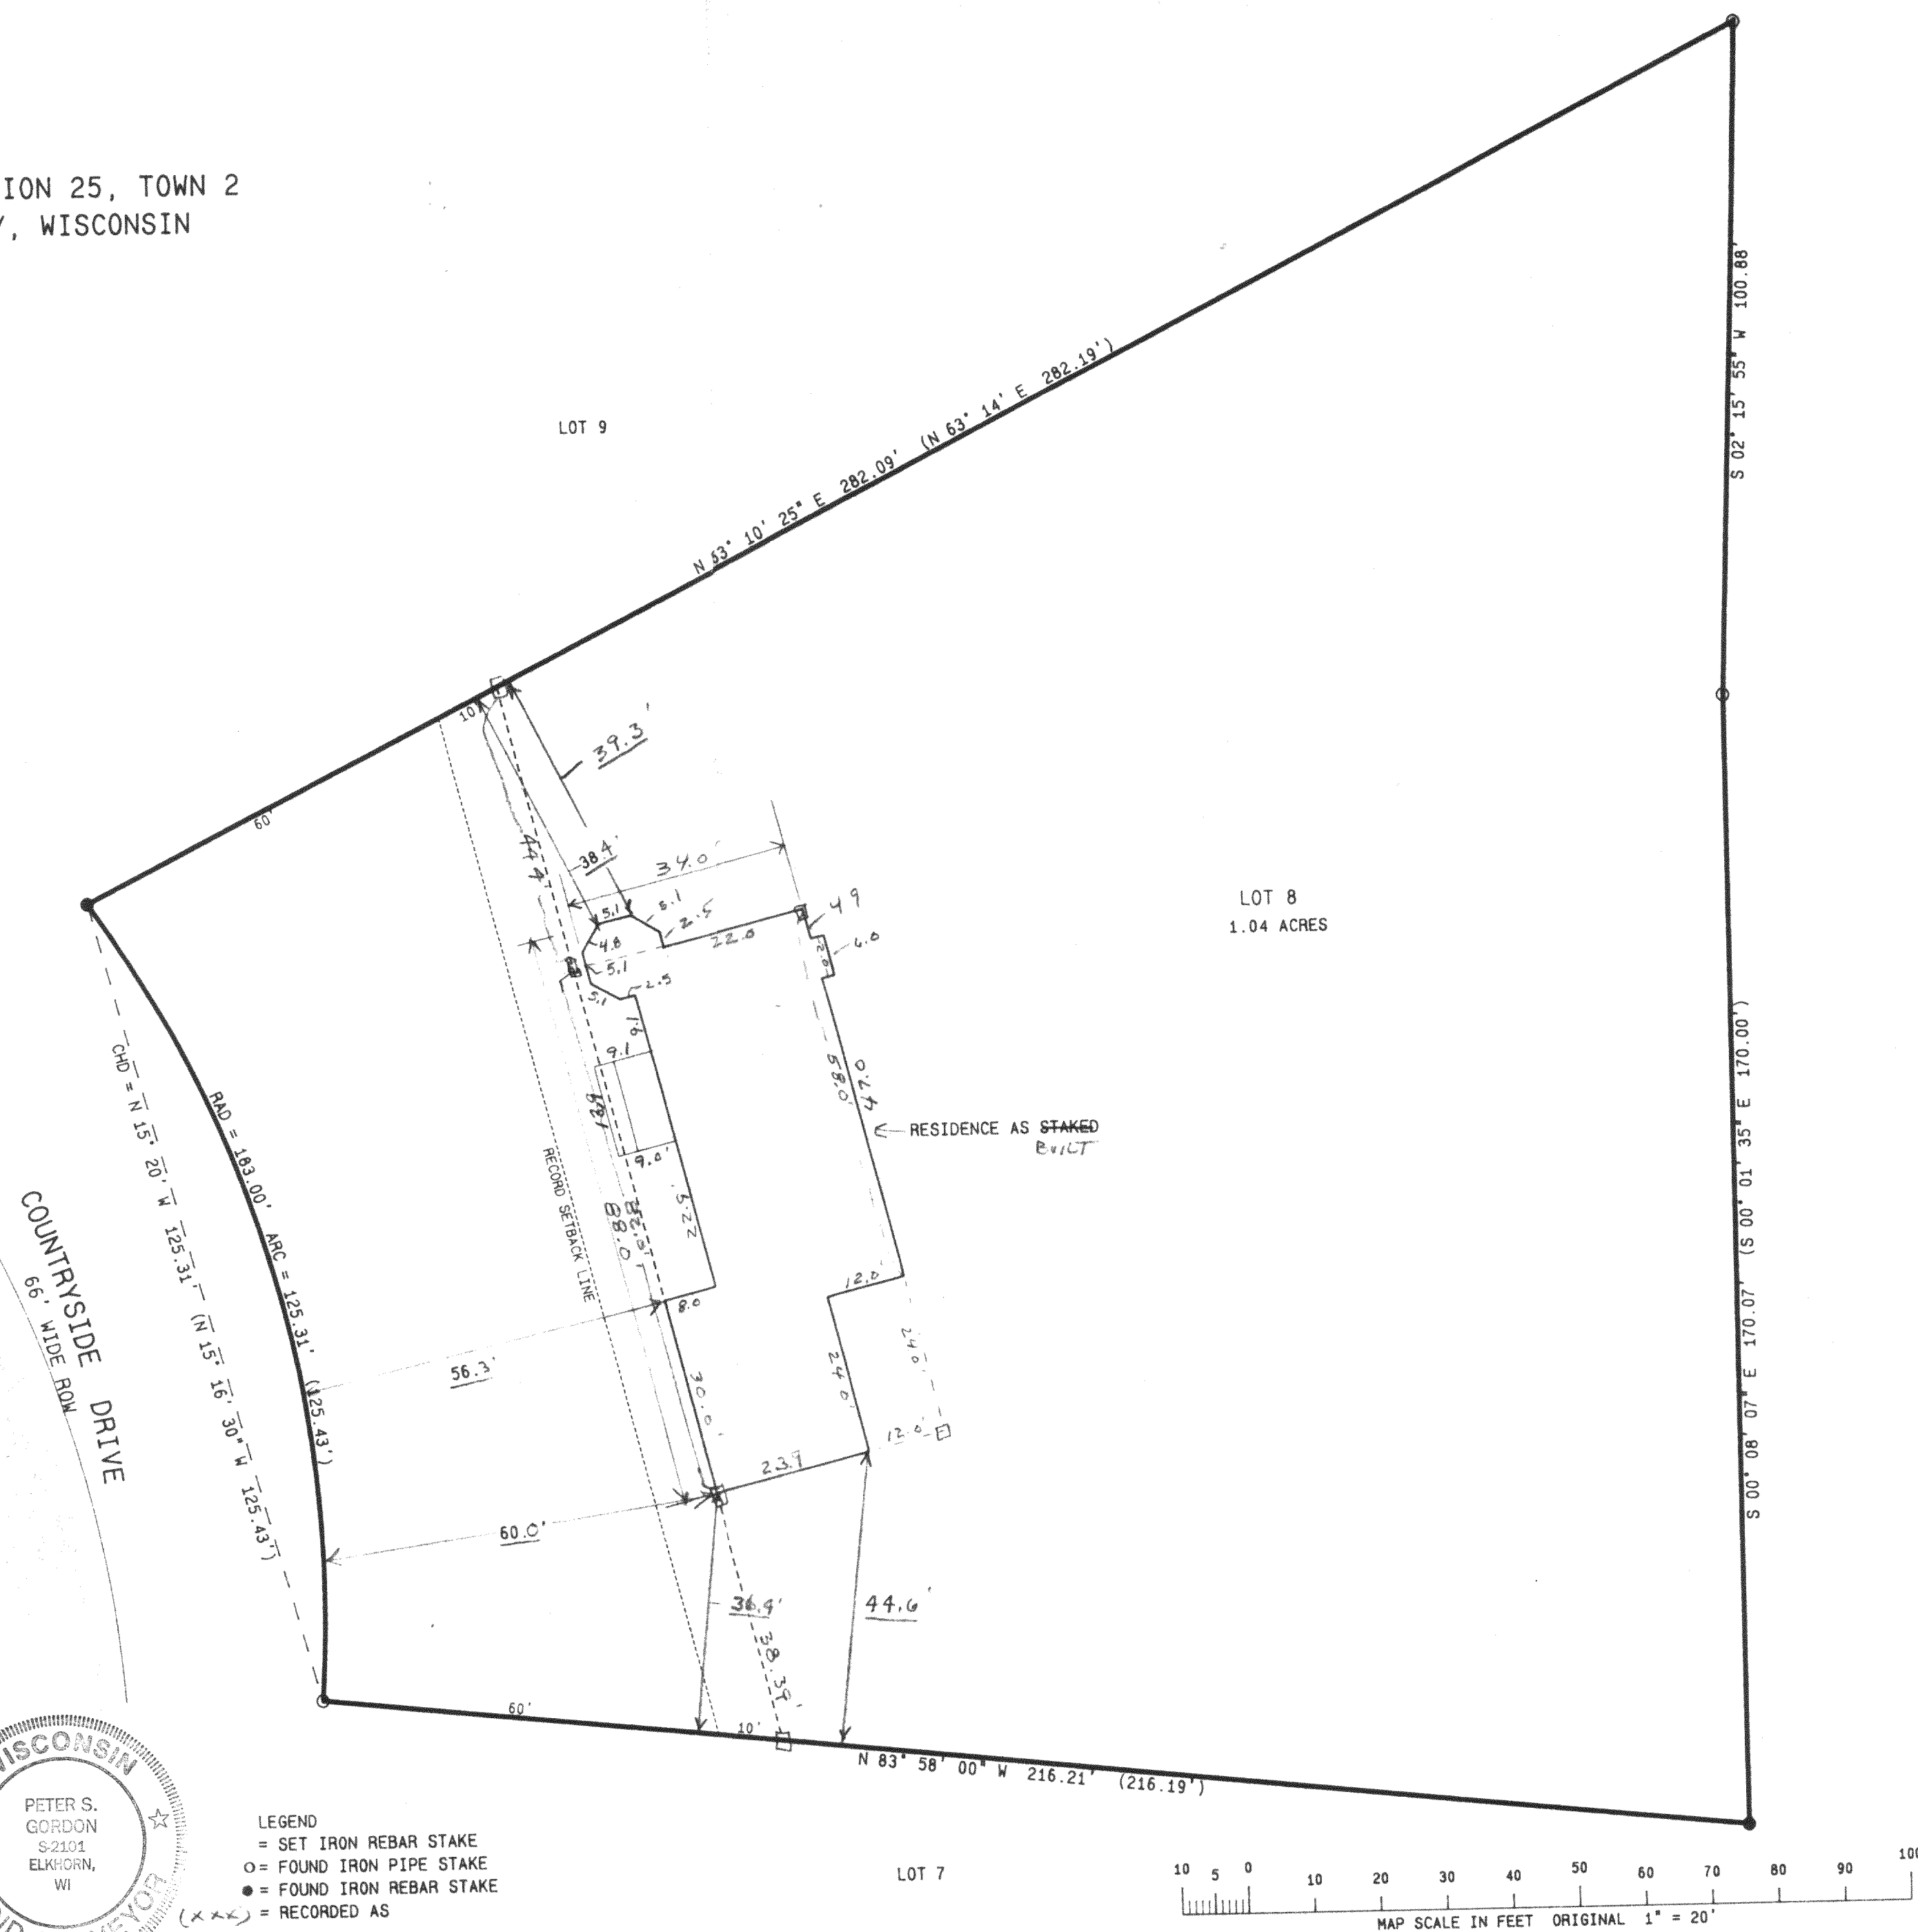

WORK ORDERED BY: HAP ARNOLD
SUPERB BUILDERS
5516 STATE ROAD 11
ELKHORN, WIS. 53121

FARRIS, HANSEN & ASSOCIATES, INC.
Engineering, Architecture, Surveying
7 Ridgway Court P.O. Box 437
ELKHORN, WISCONSIN 53121
Office: (414) 723-2098
Fax: (414) 723-5886

REVISIONS

PROJECT NO.	4273
DATE	03/27/9
SHEET NO.	1 OF 1

FGEW-8
216-2135