


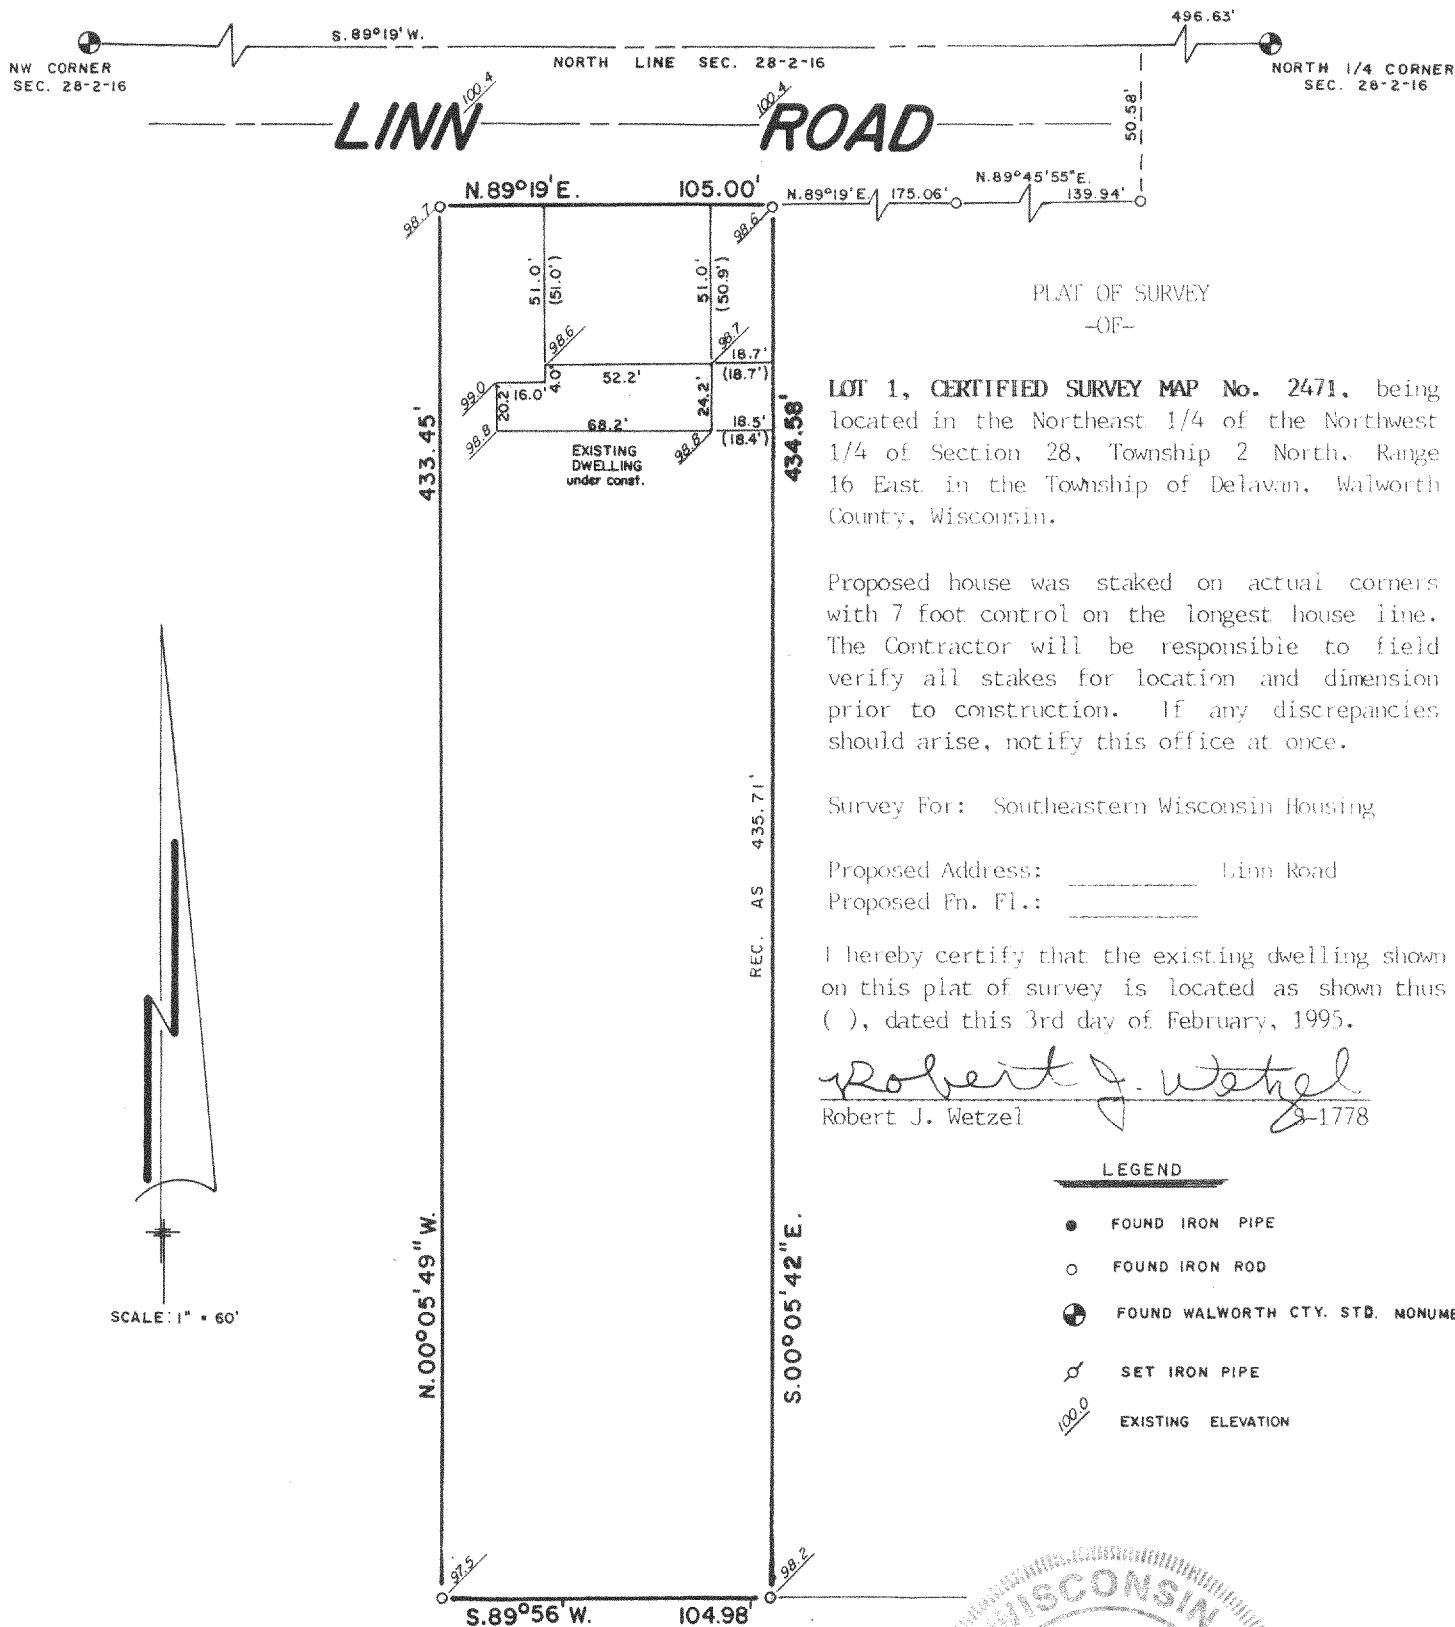

PLAT OF SURVEY
-OF-

LOT 1, CERTIFIED SURVEY MAP No. 2471, being located in the Northeast 1/4 of the Northwest 1/4 of Section 28, Township 2 North, Range 16 East in the Township of Delavan, Walworth County, Wisconsin.

Proposed house was staked on actual corners with 7 foot control on the longest house line. The Contractor will be responsible to field verify all stakes for location and dimension prior to construction. If any discrepancies should arise, notify this office at once.

Survey For: Southeastern Wisconsin Housing


Proposed Address: _____ Linn Road
Proposed Pn. Fl.: _____

I hereby certify that the existing dwelling shown on this plat of survey is located as shown thus (), dated this 3rd day of February, 1995.

Robert J. Wetzel
Robert J. Wetzel S-1778



LEGEND

- FOUND IRON PIPE
- FOUND IRON ROD
- ⊕ FOUND WALWORTH CTY. STD. MONUMENT
- ⚡ SET IRON PIPE
- 100.0 EXISTING ELEVATION

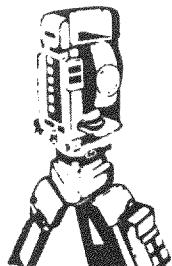

B.W. SURVEYING

Land Surveys
Mapping And Planning
35117 Academy Road
Burlington, Wisconsin 53105
(414) 534-4109

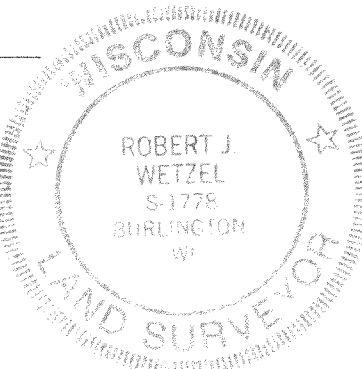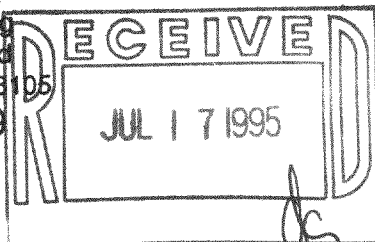

THIS IS NOT AN ORIGINAL PRINT
UNLESS THIS SEAL IS RED

Robert J. Wetzel
ROBERT J. WETZEL
REGISTERED LAND SURVEYOR - 1778

Rev. 9/29/94
8-3-94
DATE
REVISED: 02/02/95

1795
JOB NUMBER

FA-2471-1

216-2146