


PLAT OF SURVEY

LOT 8 OF GENEVA WEST ESTATES
 LOCATED IN THE SOUTHEAST 1/4 OF SECTION 25, TOWN 2
 NORTH, RANGE 16 EAST, WALWORTH COUNTY, WISCONSIN

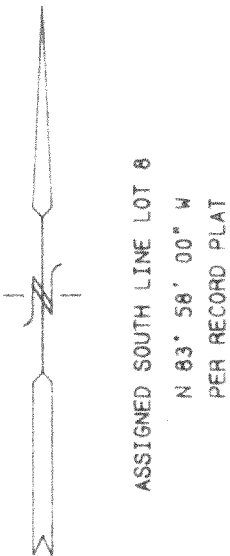

COUNTRYSIDE DRIVE
 60' WIDE ROAD

NOTE: COPIES OF THIS MAP TO WHICH THE FOLLOWING
 CERTIFICATE WILL APPLY ARE BLUE LINE PRINTS SHOWING
 SURVEYOR'S ORIGINAL SEAL AND SIGNATURE IN BLACK INK.
 COPIES BY ANY OTHER MEANS MAY HAVE ALTERATIONS WHICH
 DO NOT REPRESENT THE SURVEYOR'S WORK PRODUCT.


I HEREBY CERTIFY THAT THE ABOVE DESCRIBED PROPERTY HAS
 BEEN SURVEYED UNDER MY DIRECTION AND THAT THE ABOVE
 MAP IS A TRUE REPRESENTATION THEREOF AND SHOWS THE
 SIZE AND LOCATION OF THE PROPERTY AND ITS EXTERIOR
 BOUNDARIES. THIS SURVEY IS MADE FOR THE USE OF THE
 PRESENT OWNERS OF THE PROPERTY, AND ALSO THOSE WHO
 PURCHASE, MORTGAGE, OR GUARANTEE THE TITLE THERETO
 WITHIN ONE YEAR FROM THE DATE HEREOF.

DATED: 3/27/95




REVISED 5-30-95 TO SHOW SIZE + LOCATION
 OF RESIDENCE AS BUILT

Peter S. Gordon
 PETER S. GORDON R.L.S. 2101

REVISED 11/7/95 TO UPDATE PHYSICAL IMPROVEMENTS

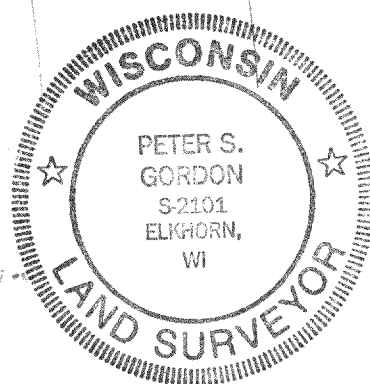

- LEGEND
 = SET IRON REBAR STAKE
 ○ = FOUND IRON PIPE STAKE
 ● = FOUND IRON REBAR STAKE
 (XXX) = RECORDED AS
 *** = AS BUILT LOCATION

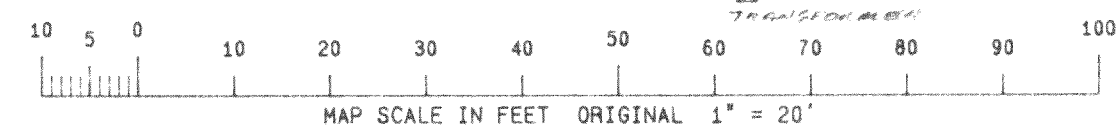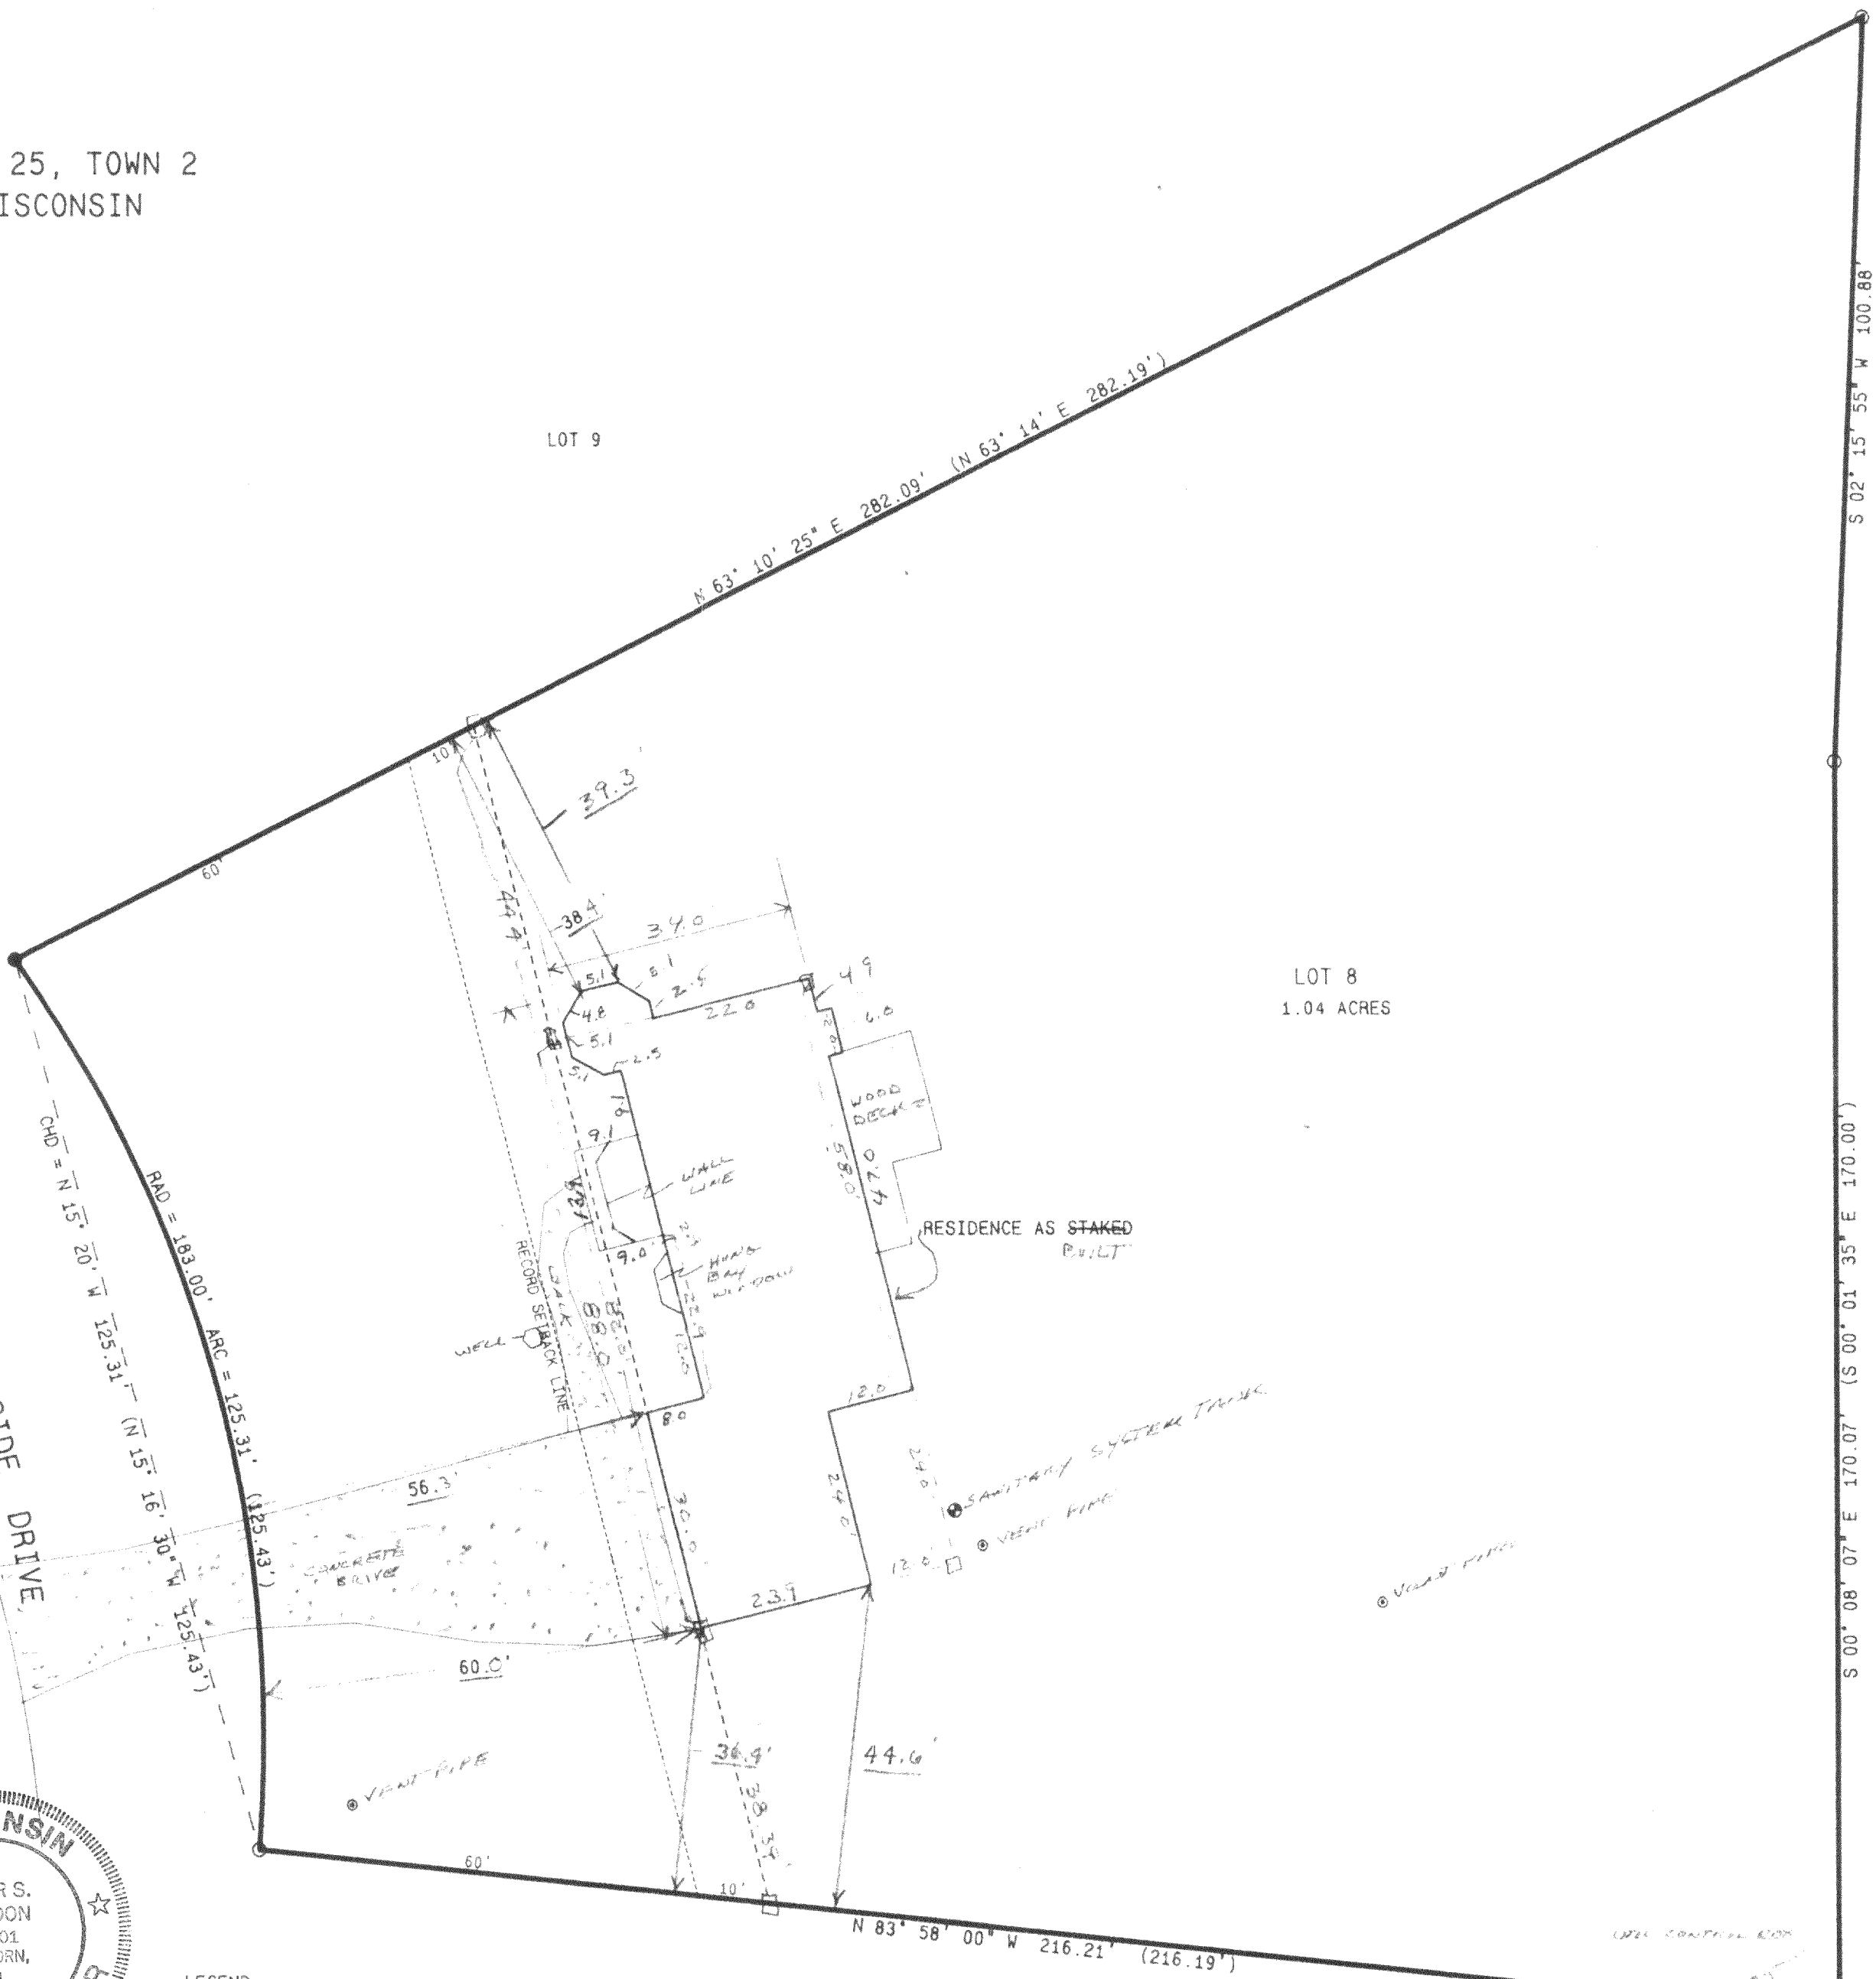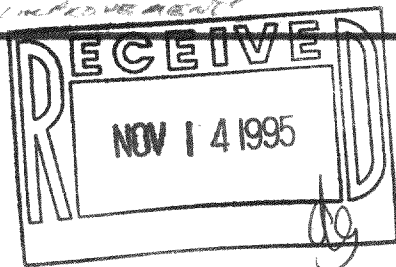

WORK ORDERED BY: HAP ARNOLD SUPERB BUILDERS 5316 STATE ROAD 11 ELKHORN, WIS. 53121	
FARRIS, HANSEN & ASSOCIATES, INC. Engineering, Architecture, Surveying 7 Ridgway Court P.O. Box 437 ELKHORN, WISCONSIN 53121 Office: (414) 723-2098 Fax: (414) 723-5886	
REVISIONS	
PROJECT NO. 4273	DATE 03/27/95
SHEET NO. 1 OF 1	

FGEW-8
 216-2153