



ABELL  
SURVEYING & MAPPING  
DELAVAL, WISCONSIN 53115  
414-728-6737

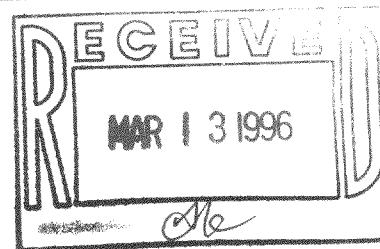

## VALÈNCIA DRIVE

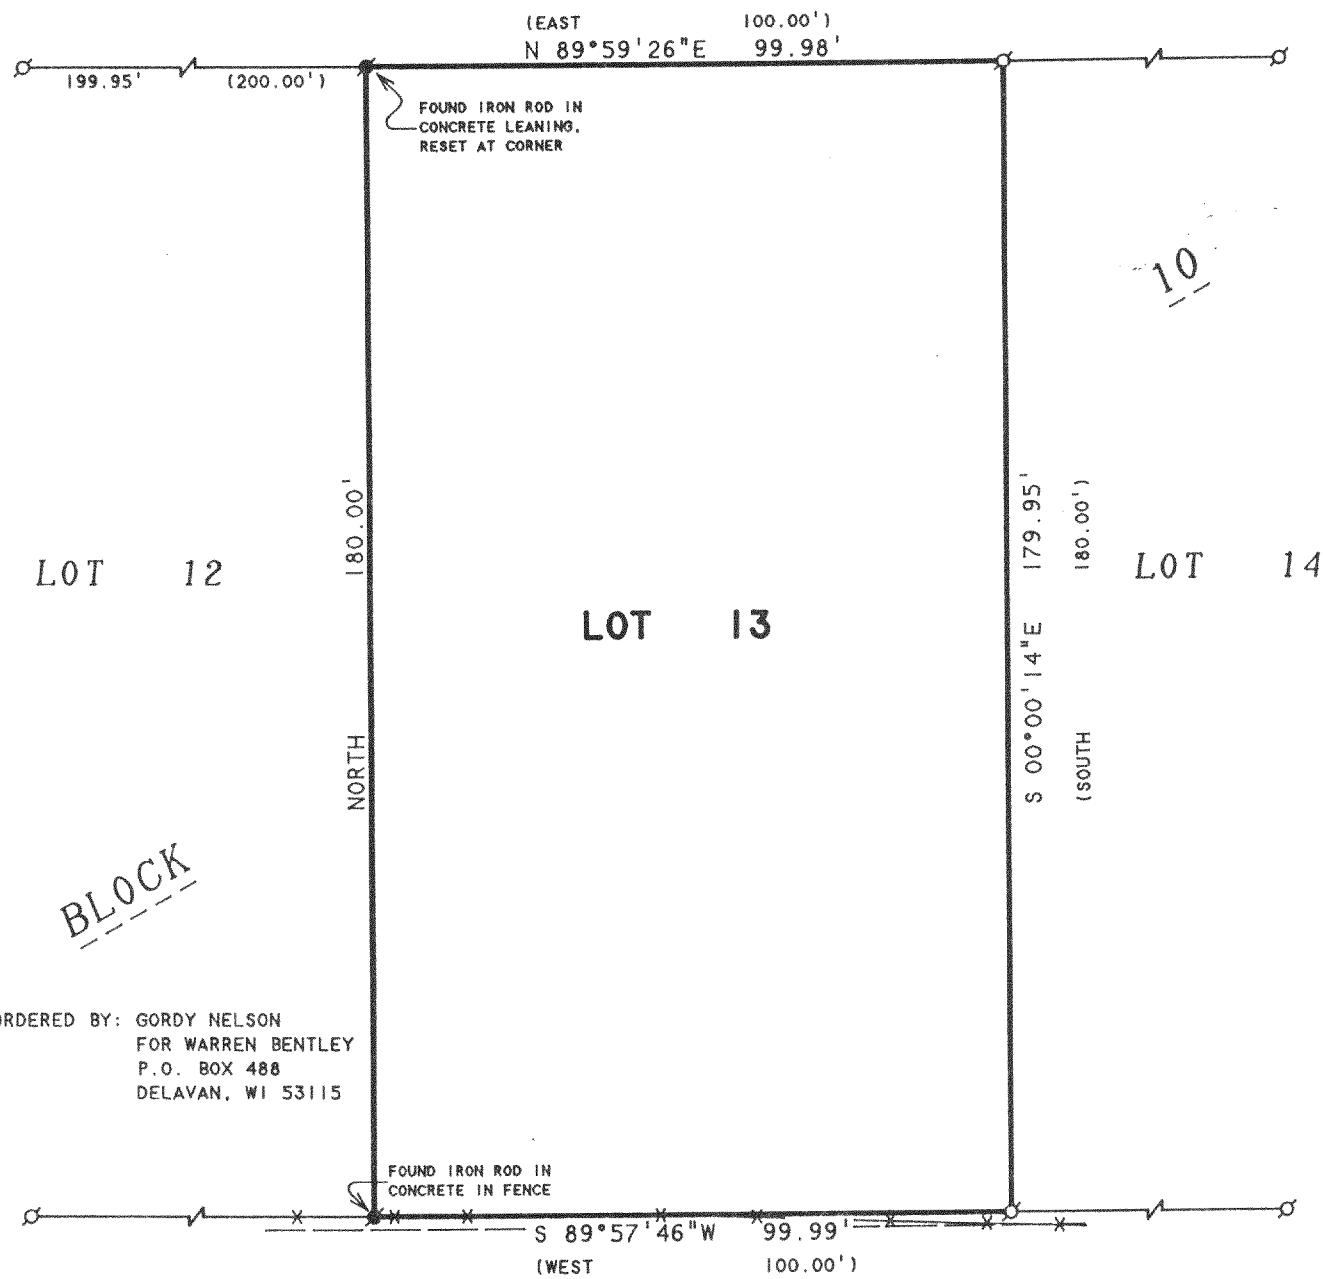

ORDERED BY: GORDY NELSON  
FOR WARREN BENTLEY  
P.O. BOX 488  
DELAVAL, WI 53115

NOTE: BEARINGS ARE REFERENCED TO THE  
RECORDED SUBDIVISION PLAT.

LOT 13, BLOCK 10, INLET OAKS SUBDIVISION NO. 5,  
LOCATED IN T2N, R16E, WALWORTH COUNTY, WISCONSIN.

I HEREBY CERTIFY THAT I HAVE SURVEYED THE ABOVE DESCRIBED PROPERTY AND THAT THE ABOVE MAP IS A TRUE REPRESENTATION THEREOF AND SHOWS THE SIZE AND LOCATION OF THE PROPERTY, ITS EXTERIOR BOUNDARIES, THE LOCATION OF ALL VISIBLE STRUCTURES AND DIMENSIONS OF ALL PRINCIPAL BUILDINGS THEREON, BOUNDARY FENCES, APPARENT EASEMENTS, ROADWAYS AND VISIBLE ENCROACHMENTS, IF ANY. TO THE BEST OF MY KNOWLEDGE AND BELIEF.

THIS SURVEY IS MADE FOR THE USE OF THE PRESENT OWNERS OF THE PROPERTY, AND ALSO THOSE WHO PURCHASE, MORTGAGE, OR GUARANTEE THE TITLE THERETO WITHIN ONE (1) YEAR FROM DATE HEREON.

David F. Bell

DAVID F. ABELL  
WISCONSIN REGISTERED LAND SURVEYOR, S-1596

- ∅ - IRON PIPE FOUND
- ∅ - IRON ROD IN CONCRETE FOUND
- ✗ - WIRE FENCE
- — — — — OVERHEAD UTILITY LINES
- ( ) - RECORDED AS

October 6, 1995      DATE      JOB NUMBER - 95145A  
NOTE: THIS IS NOT A CERTIFIED COPY UNLESS SEALED.

FIN5-13

216-2205