




PLAT OF SURVEY

LOT 23 OF BLOCK 2 OF DELMAR
SUBDIVISION LOCATED IN SECTION
27, TOWN 2 NORTH, RANGE 16 EAST,
WALWORTH COUNTY, WISCONSIN.

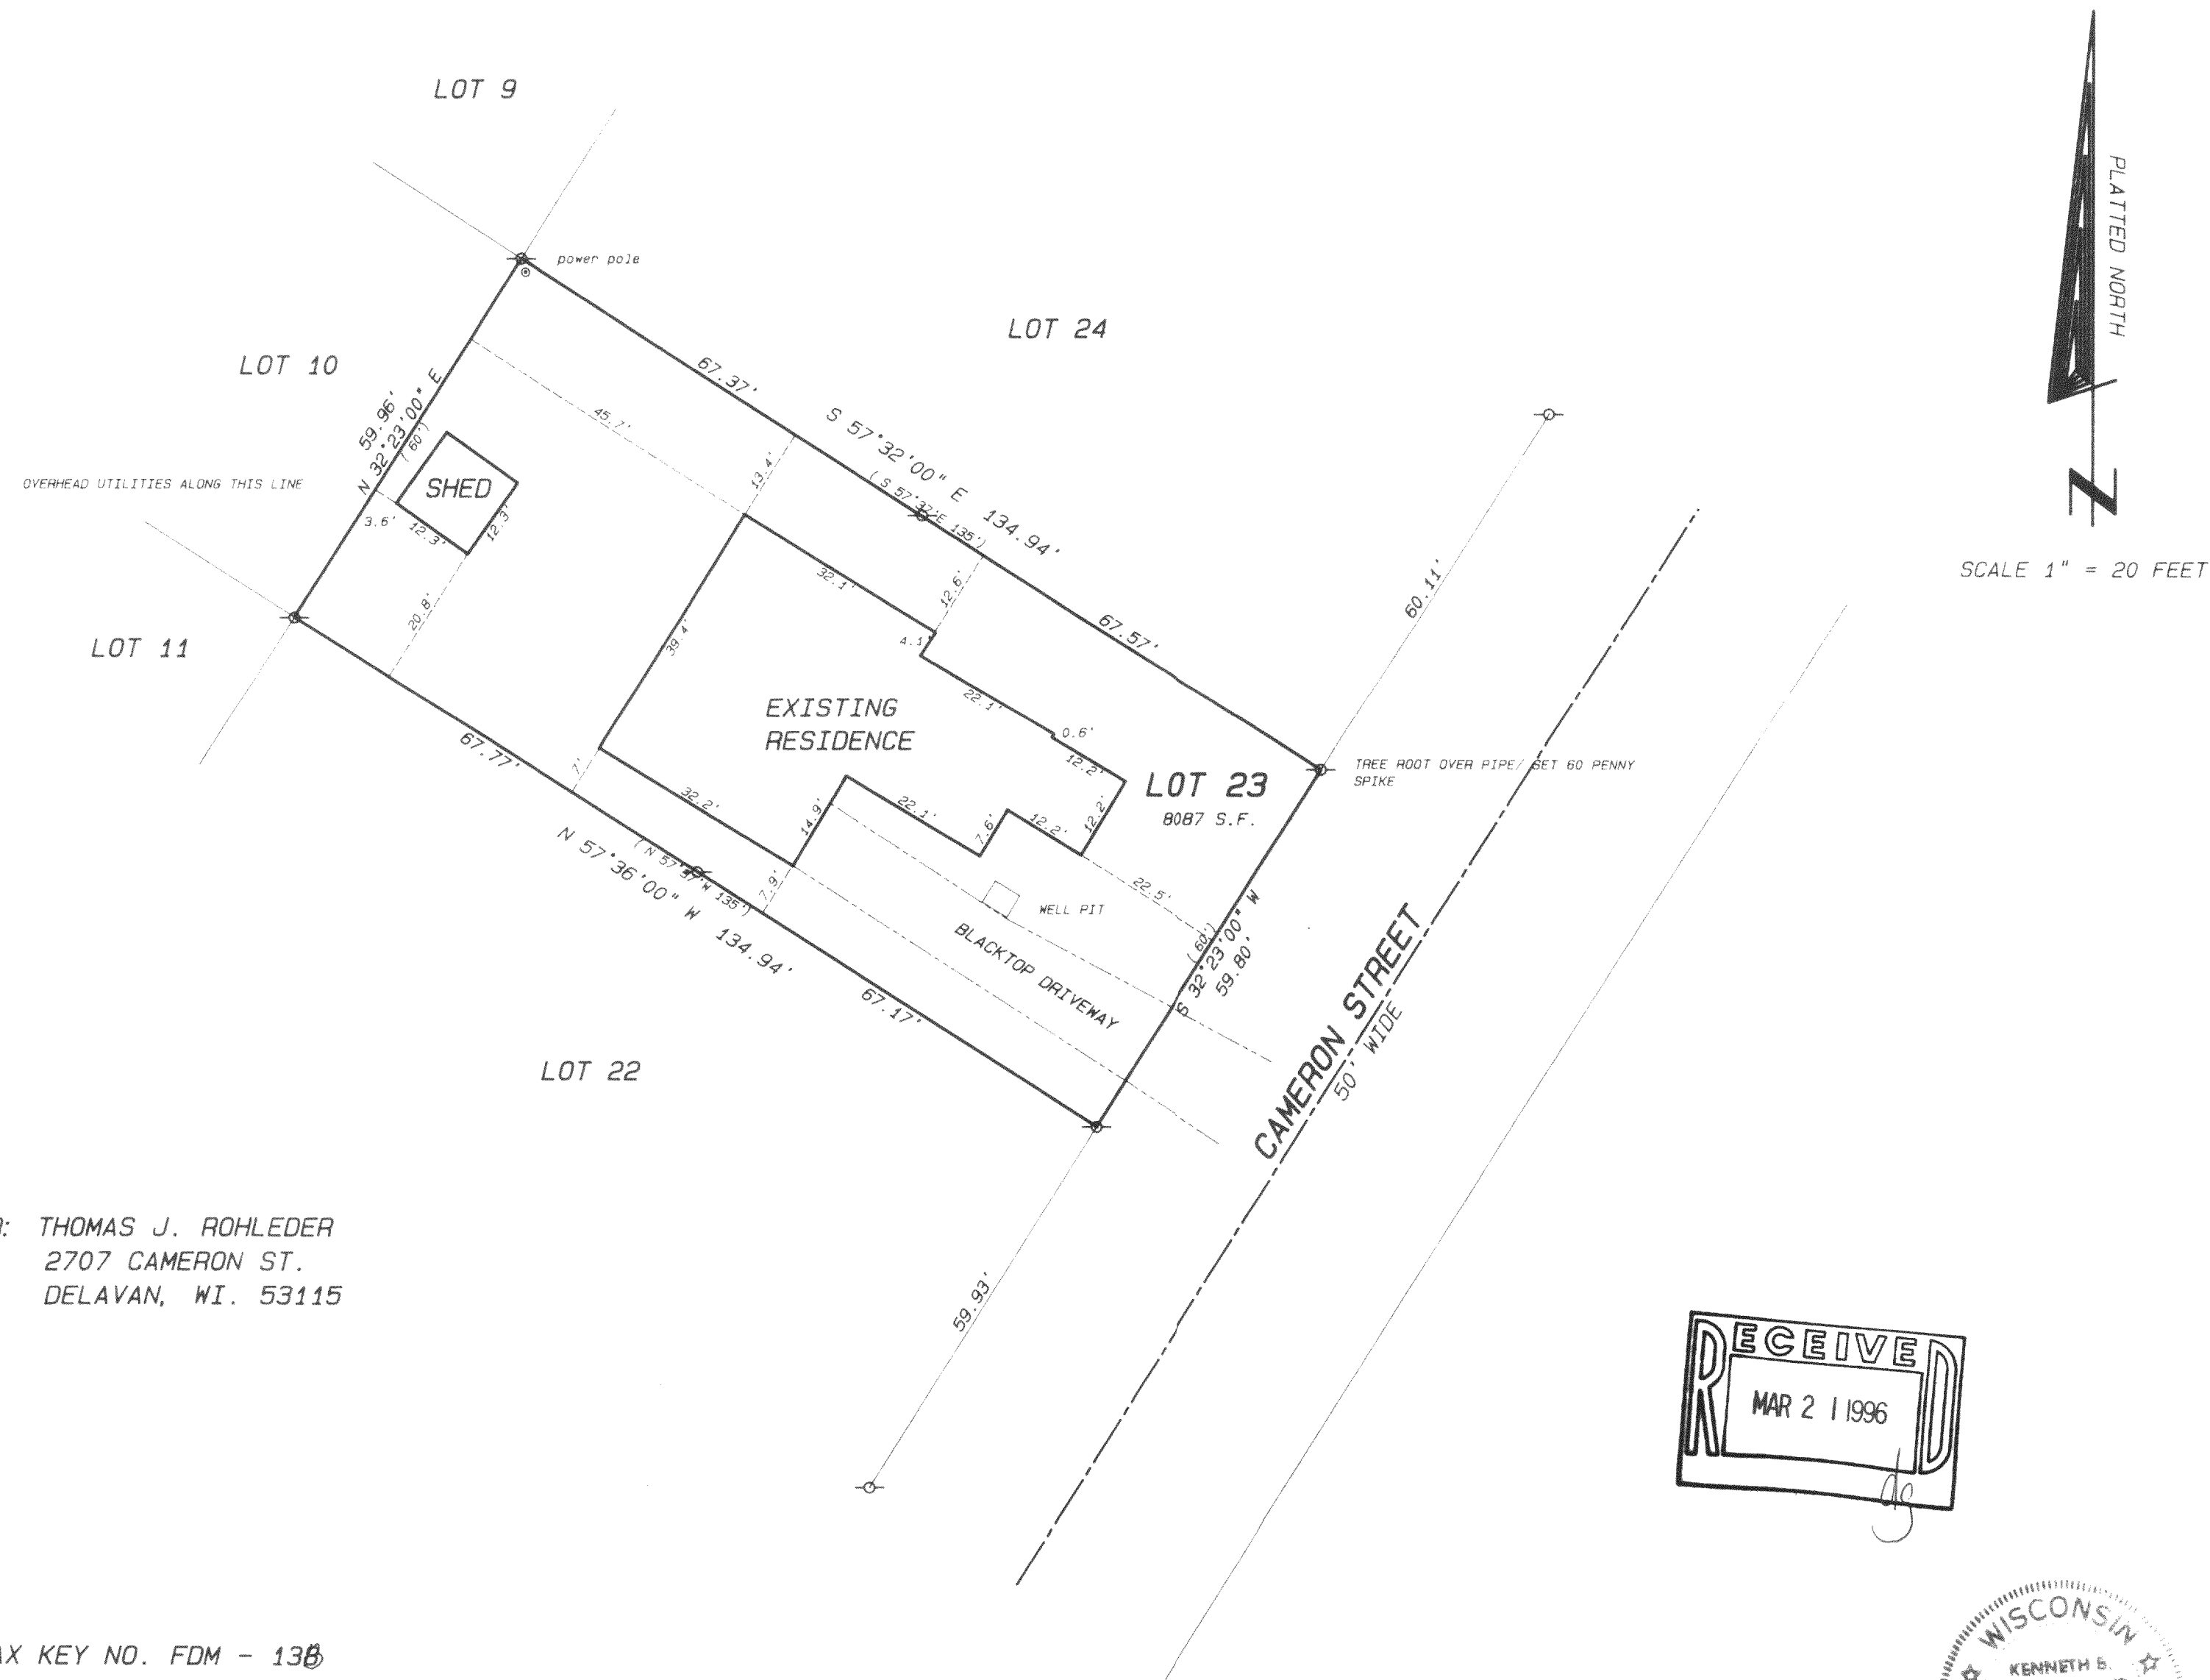

OWNER: THOMAS J. ROHLEDER
2707 CAMERON ST.
DELAVAN, WI. 53115

TAX KEY NO. FDM - 13B

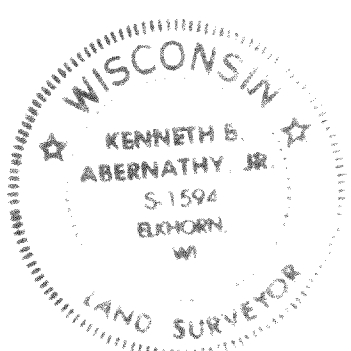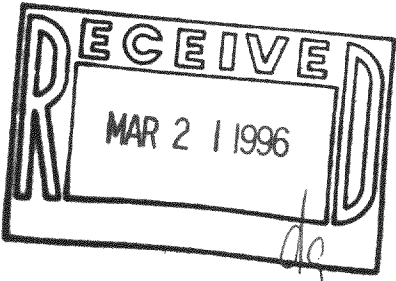

I hereby certify that the above described property has been surveyed by me or under my direction and that the above map is a true representation thereof and shows the size and location of the property, its exterior boundaries, the location of all visible structures and dimensions of all principal buildings thereon, boundary fences, apparent easements, roadways and visible encroachments, if any.

This survey is made for the use of the present owners of the property and also those who purchase, mortgage, or guarantee the title thereto within one year from date hereof.

Kenneth B. Abernathy Jr.
KENNETH B. ABERNATHY, JR.
WISCONSIN REGISTERED LAND SURVEYOR,
S-1594
Date: FEB 2, 1996 Job No. 95.913