

Wisconsin Registered Land Surveyor S-1594


Rt. 3, Box 273
Elkhorn, Wisconsin 53121
Phone: (414) 723 4260 (office)
(414) 723 7209 (FAX)

PLAT OF SURVEY

LOTS 4, 5 AND 6 OF BLOCK 11 OF
DELMAR SUBDIVISION, LOCATED IN
SECTION 27, TOWN 2 NORTH. RANGE
16 EAST, TOWN OF DELAVAN,
WALWORTH COUNTY, WISCONSIN.

OWNED BY: WM. SPEARE
669 JACKSON PARKWAY
WILLIAMS BAY, WI. 53191

50' WIDE
MABIE STREET

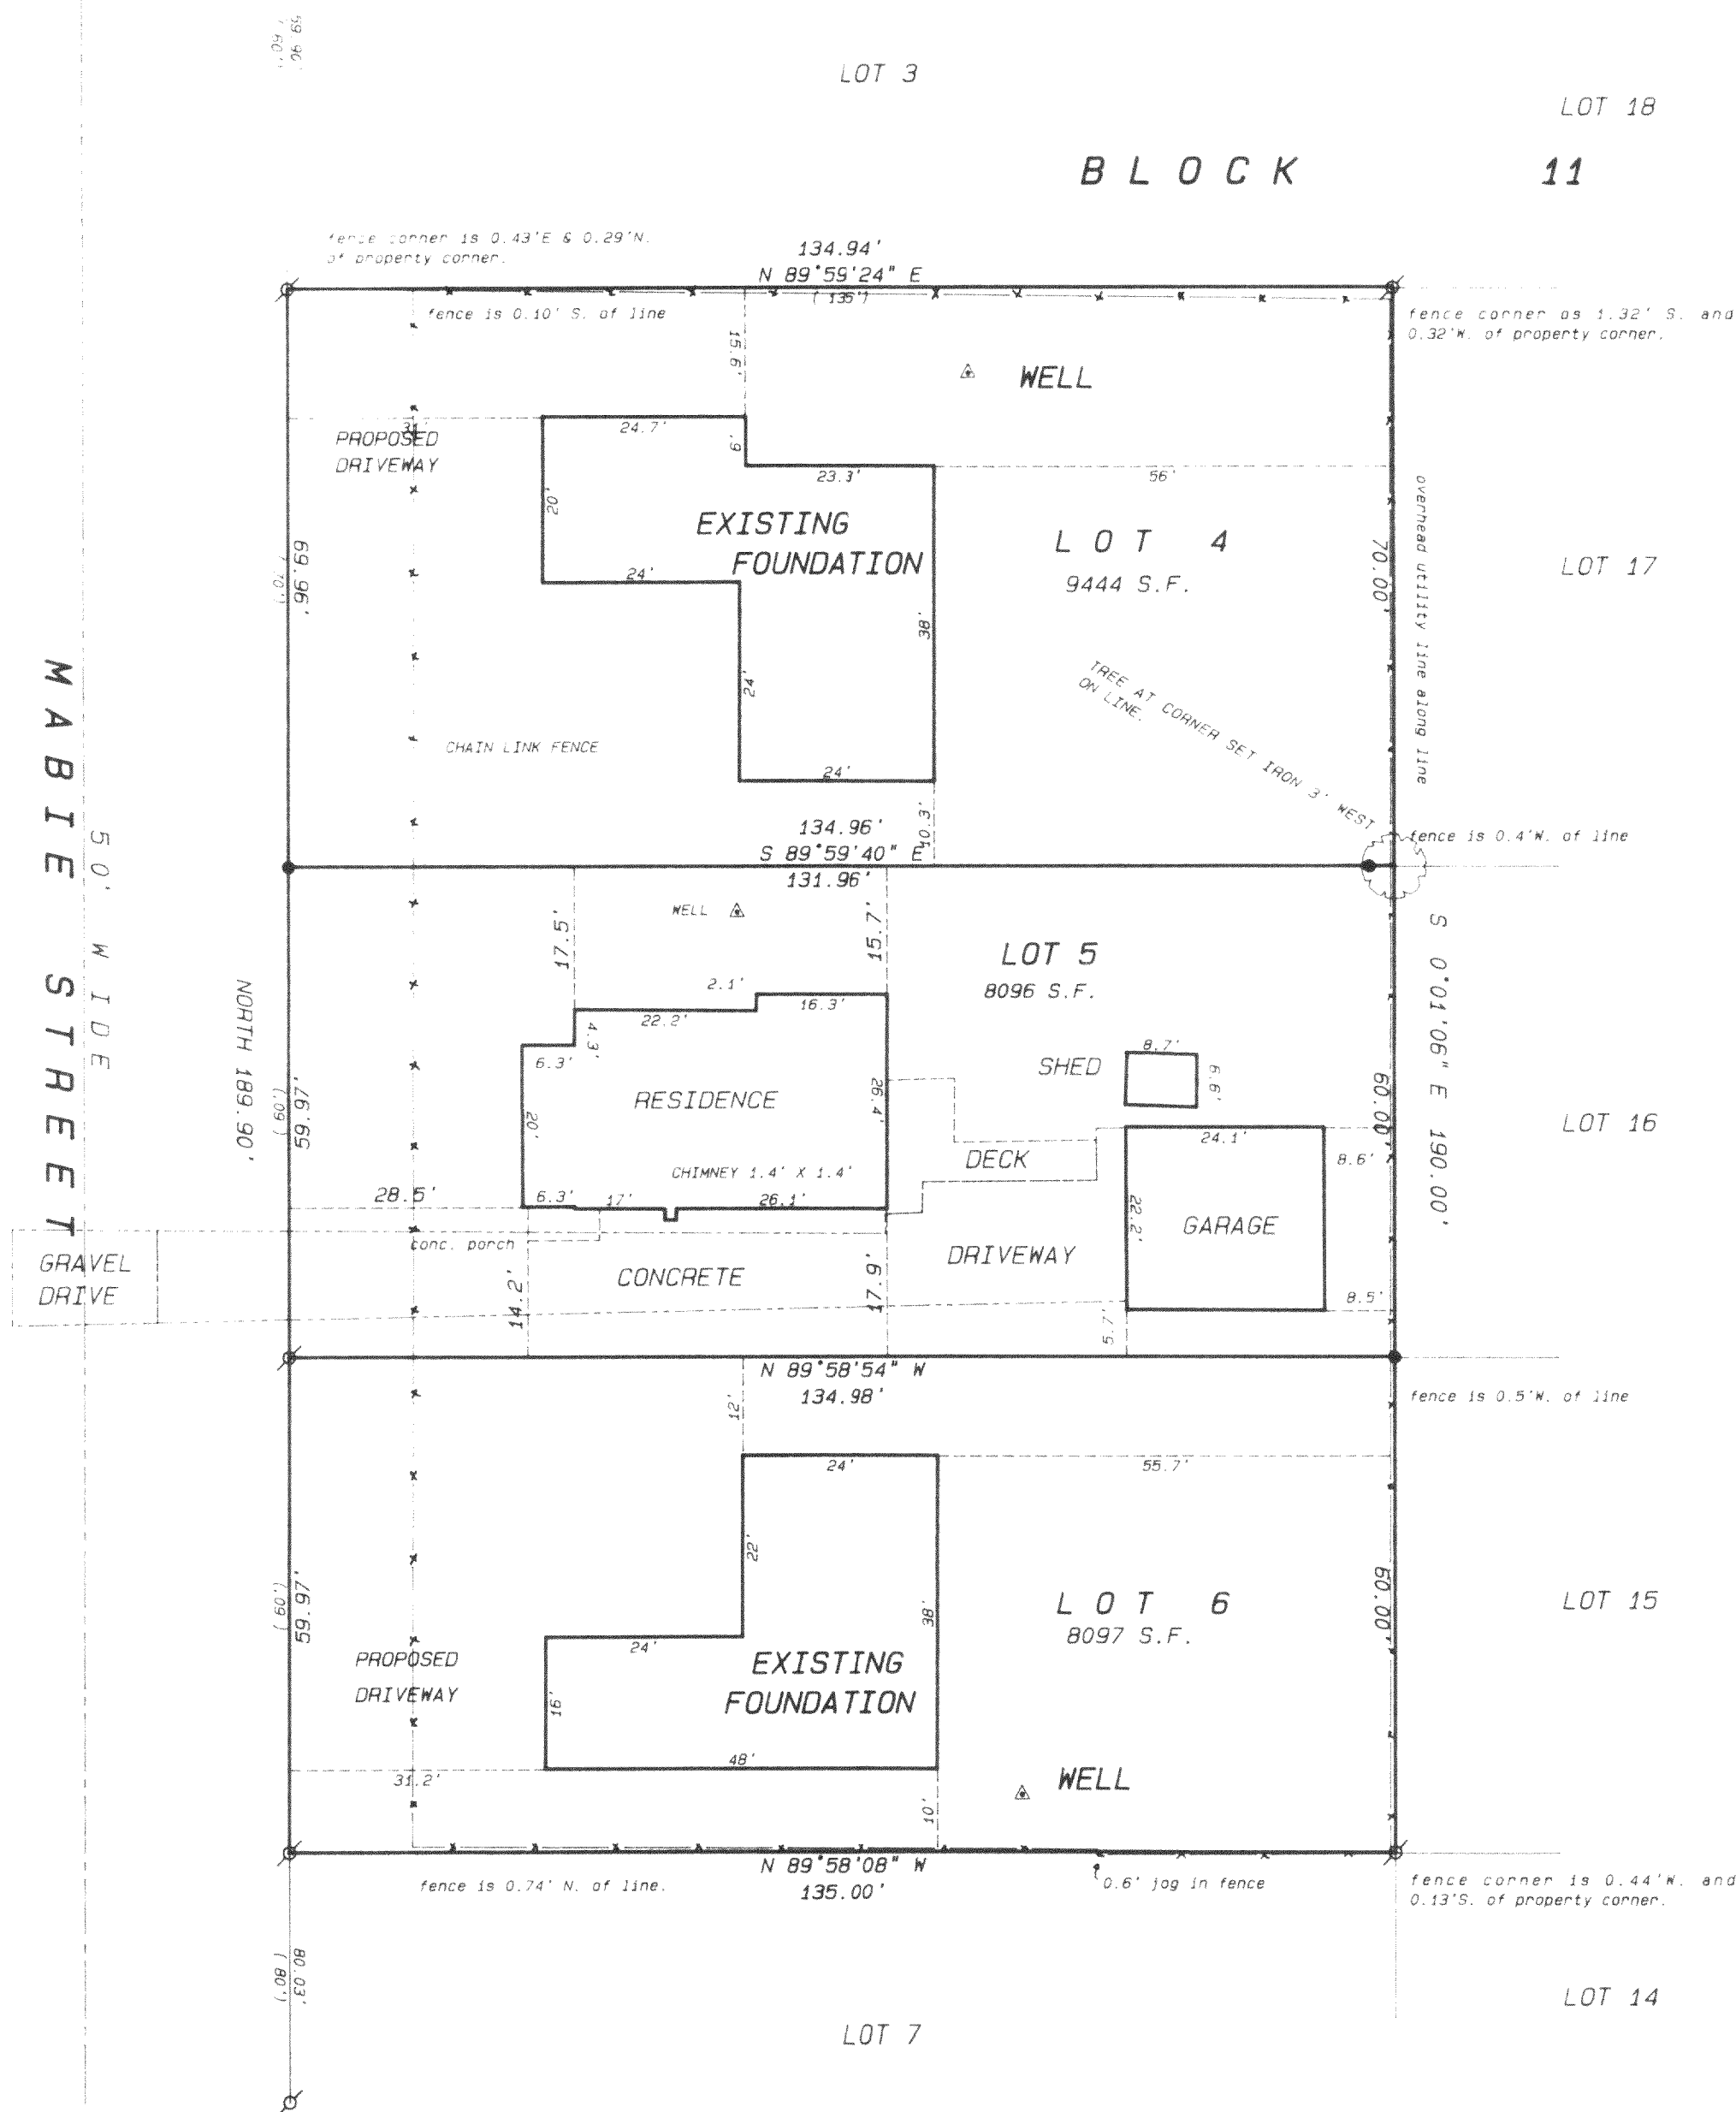


SCALE 1" = 20 FEET

BEARINGS ARE REFERENCED TO
PLATTED NORTH

Legend

- FOUND IRON PIPE
 - FOUND IRON ROD
 - FOUND BRASS CAPPED MONUMENT
 - * FOUND CONCRETE MONUMENT
 - + CHISEL CUT IN CONCRETE
 - SET IRON ROD, 24" LONG, WEIGHING 1.5 LBS. LINEAL FT. 3/4" DIA.
 - SET IRON ROD, 30" LONG, WEIGHING 4.5 LBS. LINEAL FT. 1 1/16" DIA.
- (xx) RECORDED AS DIMENSION
- + - x - x - EXISTING FENCE

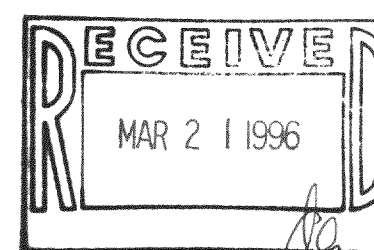

SCALE: 1" = 20 FEET

I hereby certify that the above described property has been surveyed by me in my profession and that the above map is a true representation thereof and shows the size and location of the property, its exterior boundaries, the location of all visible structures and dimensions of all principal buildings, their boundary lines, apparent easements, roadways and visible encroachments, if any.

This survey is made for the use of the present owners of the property and also those who purchase mortgage to guarantee the title thereto within the year from date hereof."


KENNETH B. ABERNATHY, JR.
WISCONSIN REGISTERED LAND SURVEYOR.

Date: APRIL 5, 1995 Job No. 95.316

FDM-47C
FDM-47C1
FDM-48

REVISÉD 1/5/96

LOCATED EXISTING FOUNDATION ON
LOTS 4 AND 6.

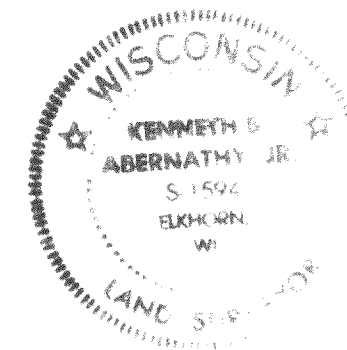

216-2247