
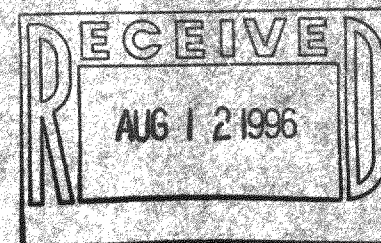


DUNHAM SURVEYING, S.C.
SURVEYING & SUBDIVIDING
DELAVER, WISCONSIN 53115

Scale - 1" = 20'
O = Iron Pipe
Survey ordered by:
Phil Benoliel, Architect
150 Elmhurst Court
Williams Bay, Wisconsin
and R. G. Betzer
2718 Willow Point Drive
Delavan, WI 53115

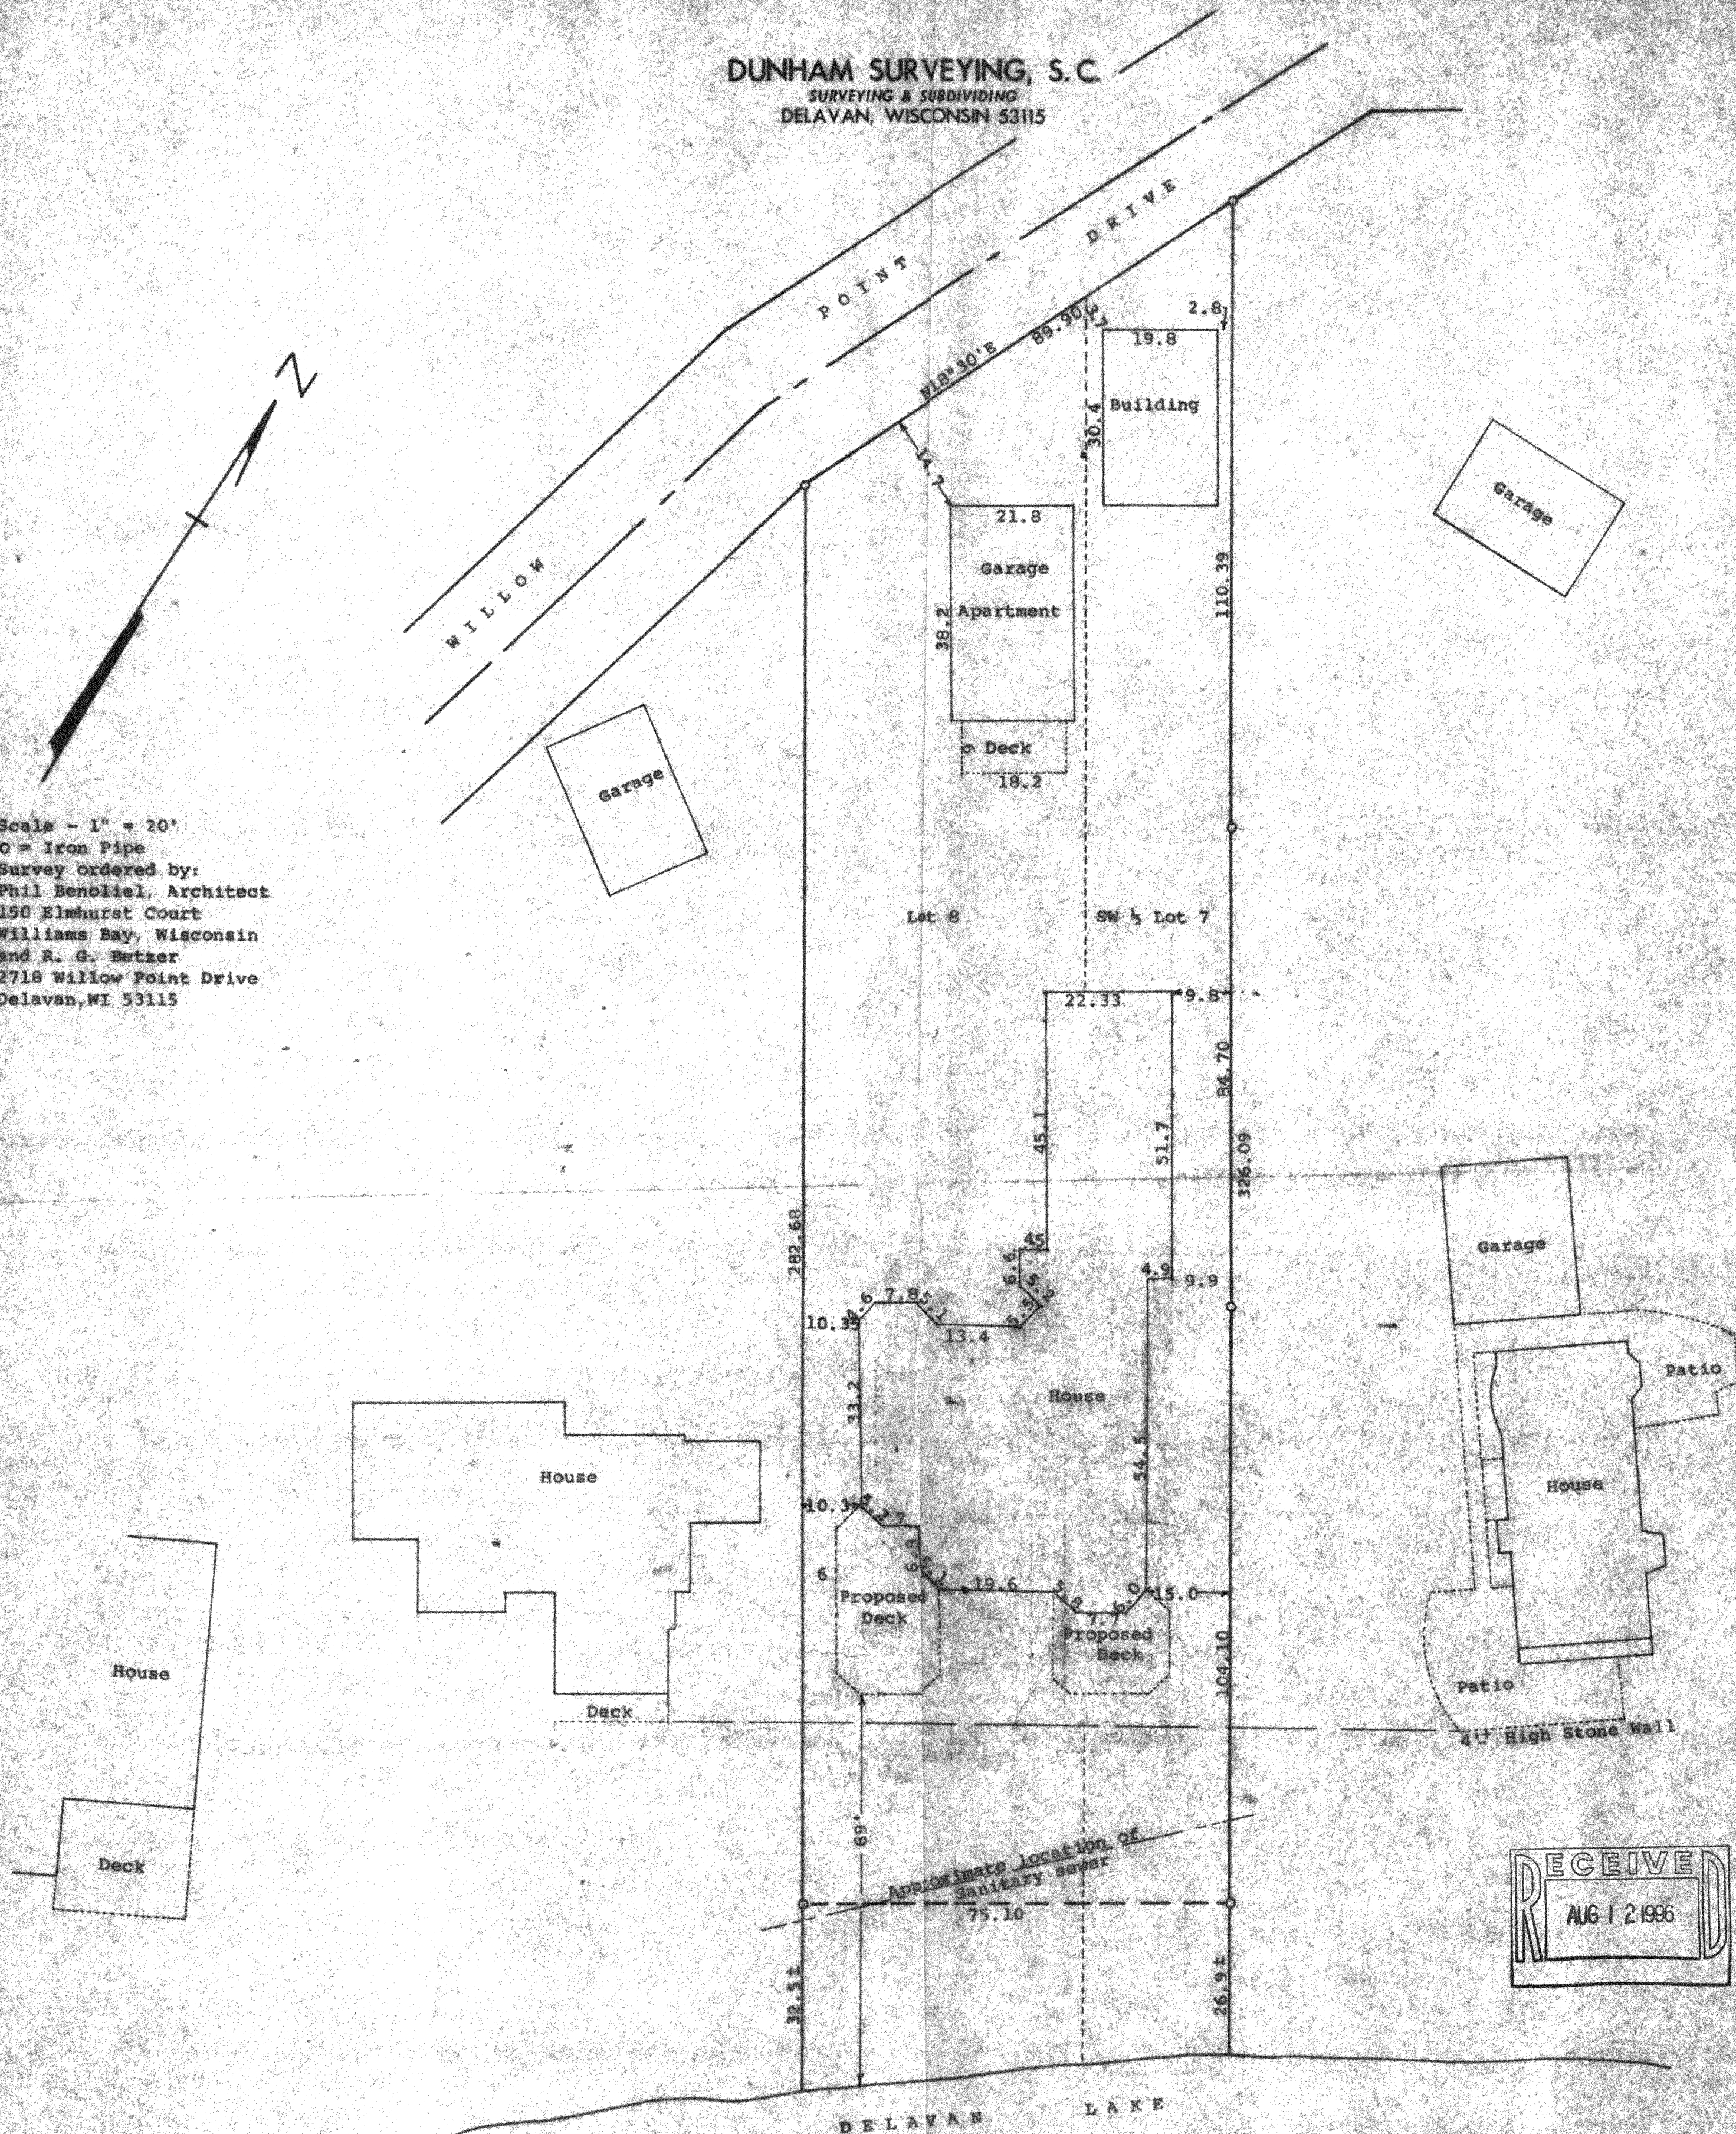

STATE OF WISCONSIN)
COUNTY OF WALWORTH)

I, George T. Dunham, Surveyor, certify that I have surveyed the property described as follows:


Lot 8 and the southwesterly 1/2 of Lot 7 of Willow Point Park, a subdivision located in the Town of Delavan, Walworth County, Wisconsin, and that the plat shown hereon is a correct representation thereof and shows the size and location of the property, its exterior boundaries, the location of all visible structures and the dimensions of all principal buildings thereon.

December 11, 1993

Revised May 19, 1995 to show proposed house location

Revised Sept. 27, 1995 to show new house location

George T. Dunham
George T. Dunham, Surveyor

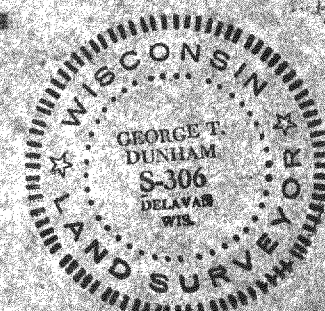

FWE-6
216-2279