


DUNHAM SURVEYING, S.C.
SURVEYING & SUBDIVIDING
DELAVAL, WISCONSIN 53115

N

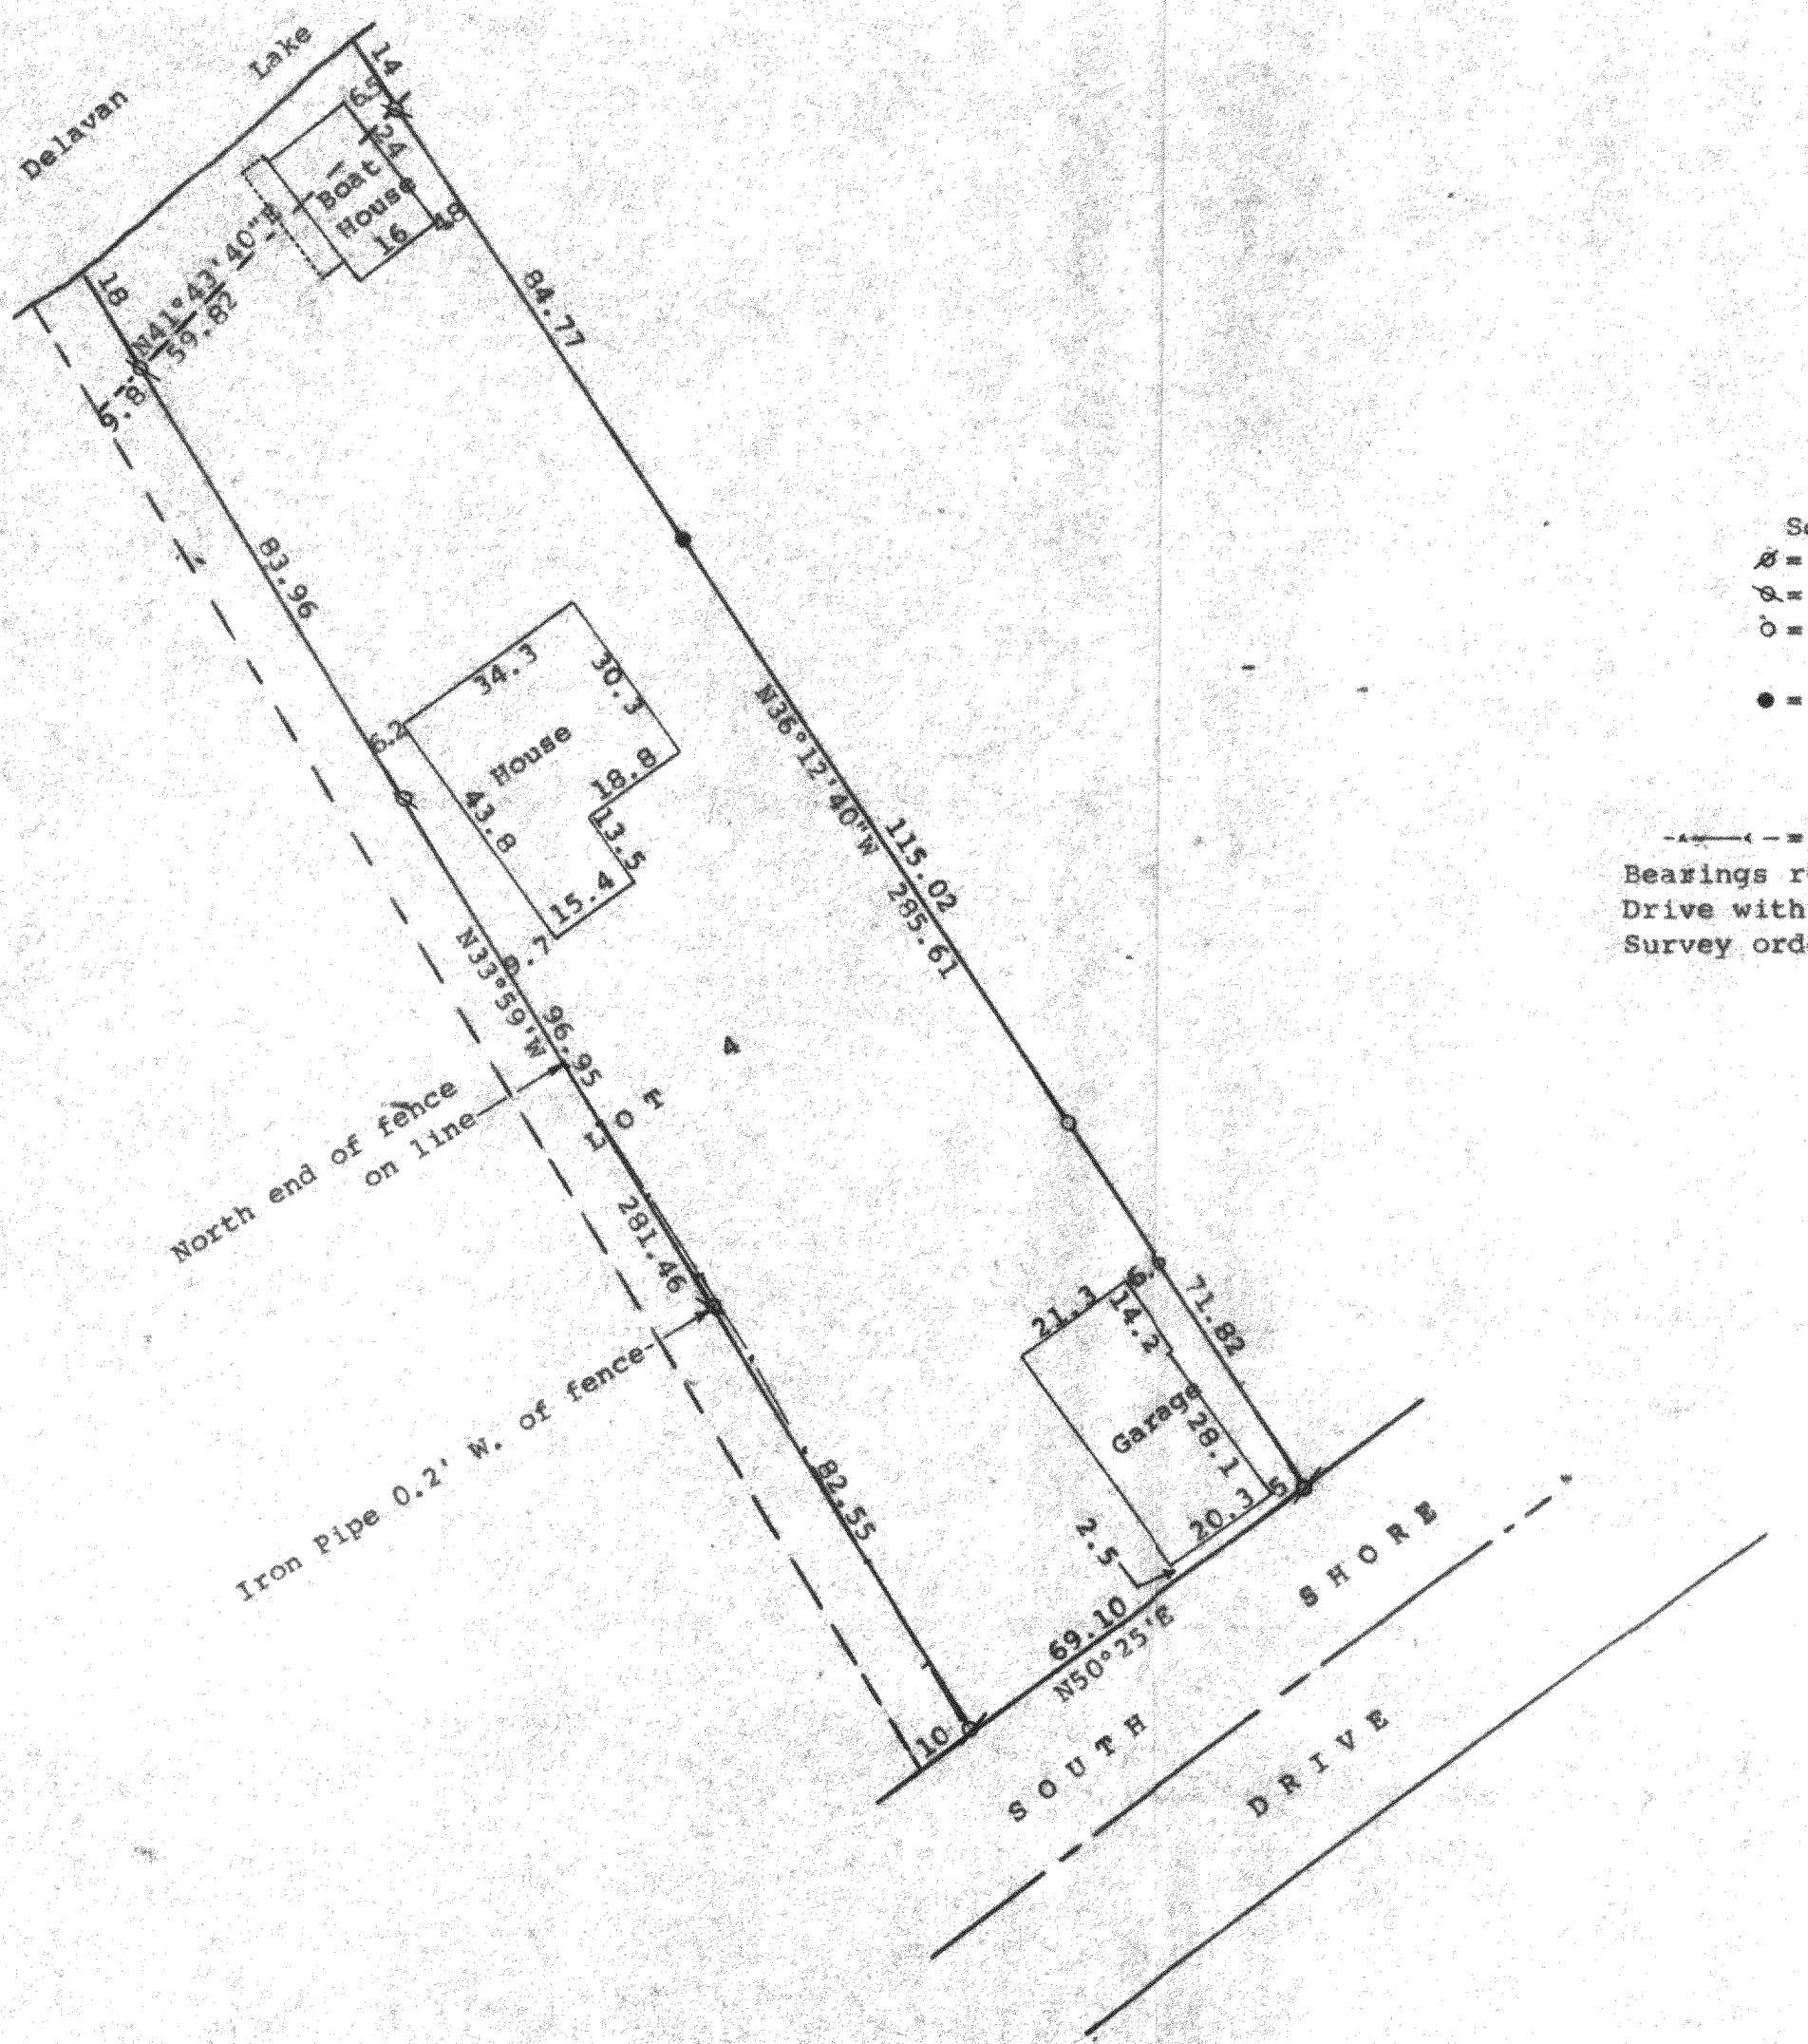

Scale - 1" = 30'
 Ø = $\frac{1}{4}$ " Iron Pipe Found
 ♦ = 3/4" Iron Pipe Found
 □ = 3/4" Iron Pipe Found and corrected 0.12' to the northeast
 • = 1" Iron Pipe Found 1.3' below ground and 0.21' northeast of line. Left in ground.
 Set 3/4" Iron pipe on line and at ground level
 - - - - = Fence Line
 Bearings referenced to the north line of South Shore Drive with the assumed bearing of N50°25'W
 Survey ordered by: David B. Williams
 Attorney
 512 East Walworth Avenue
 Delavan, WI 53115

STATE OF WISCONSIN) SS
COUNTY OF WALWORTH)

I, George T. Dunham, Surveyor, certify that I have surveyed the property described as follows:

Lot 4 of The Golf Addition, a subdivision located in Section 27, T 2 N, R 16 E, Walworth County, Wisconsin, EXCEPTING therefrom a strip of land 10 feet in width on the highway and 9.8 feet in width on the base line off from the southwesterly side of said

Lot 4.

and that the plat shown hereon is a correct representation thereof and shows the size and location of the property, its exterior boundaries, the location of all visible structures and dimensions of all principal buildings thereon, boundary fences, apparent easements, roadways and visible encroachments, if any, and that I have surveyed the property hereon described, according to the official records, to the best of my knowledge and belief.

October 5, 1995

George T. Dunham
George T. Dunham, Surveyor

