


DUNHAM SURVEYING, S.C.
SURVEYING & SUBDIVIDING
DELAVER, WISCONSIN 53115

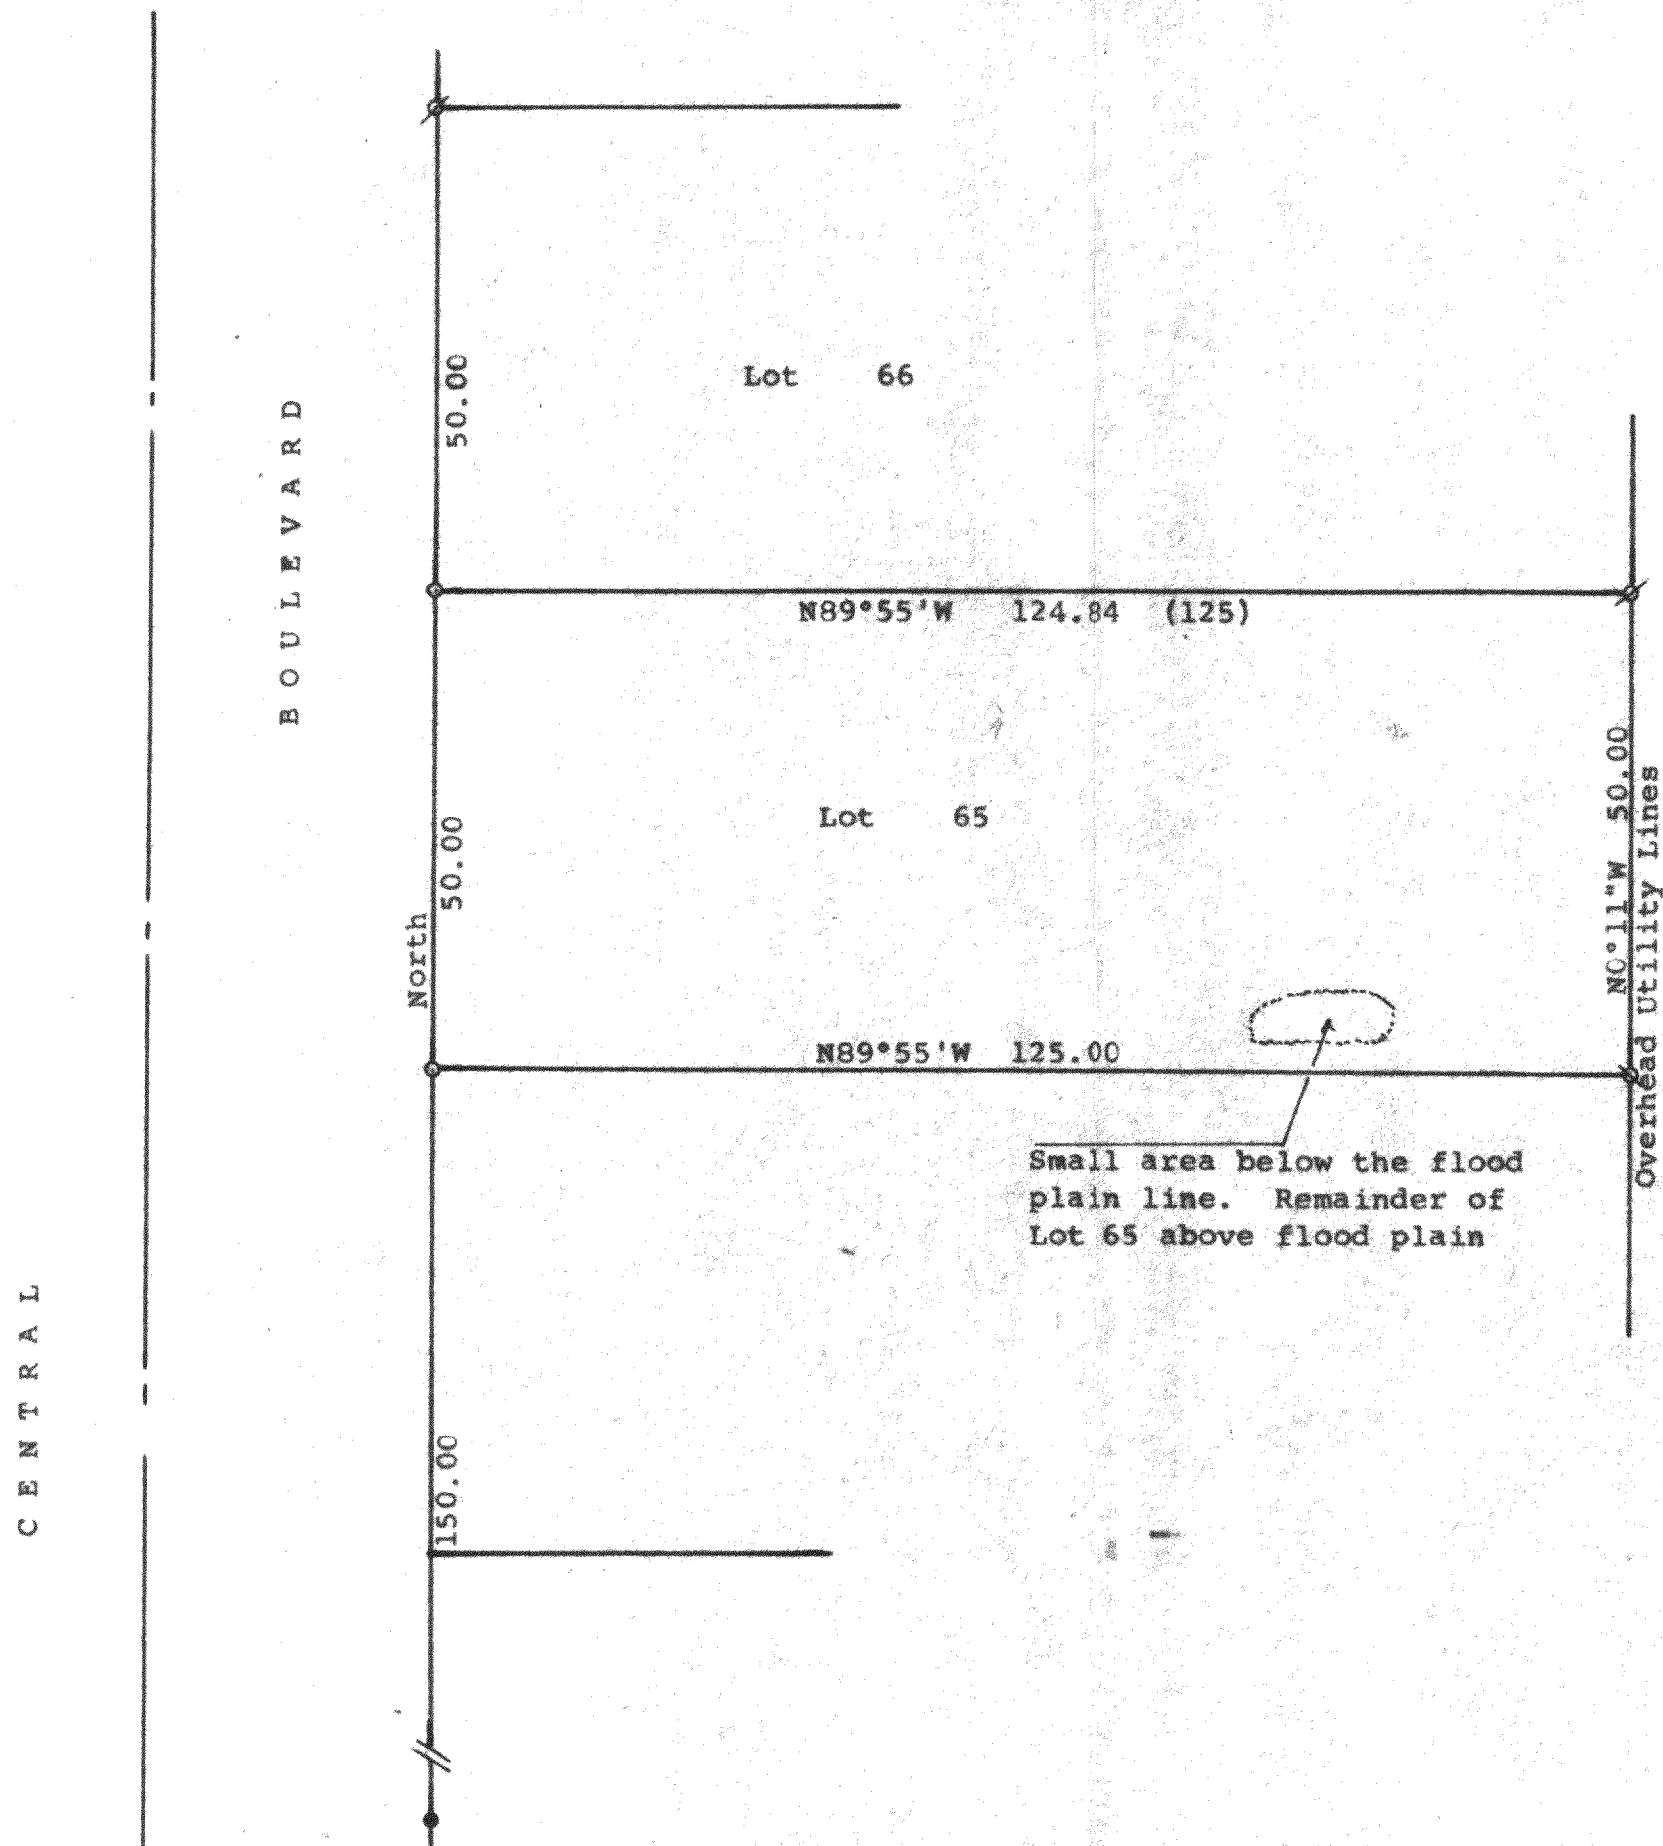

N

Scale - 1" = 20'

φ = 3/4" Iron Pipe Found

● = Iron Rod Found

⊗ = Crooked 1" Iron Pipe Found. Pulled and reset

○ = 3/4" Iron Pipe Set

(0.00) = recorded distance

Bearings are referenced to the east line of Central Boulevard with the assumed bearing of North

Survey ordered by:

James Conley

ON710 Knollwood Drive

Wheaton, IL 60187

STATE OF WISCONSIN)
COUNTY OF WALWORTH) SS

I, George T. Dunham, Surveyor, certify that I have surveyed the property described as follows:

Lot 65 in Lake Delavan Highlands, a subdivision located in the South 1/4 of the Southeast Fractional 1/4 of Section 31, T 2 N, R 16 E, Walworth County, Wisconsin

and that the plat shown above is a true representation thereof and shows the size and location of the property, its exterior boundaries, the location of boundary fences, apparent easements, roadways and visible encroachments, if any, and that I have surveyed the property hereon described, according to the official records, to the best of my knowledge and belief.

April 17, 1996

George T. Dunham
George T. Dunham, Surveyor

