


**ABELL
SURVEYING & MAPPING
DELAVAN, WISCONSIN 53115
414-728-6737**

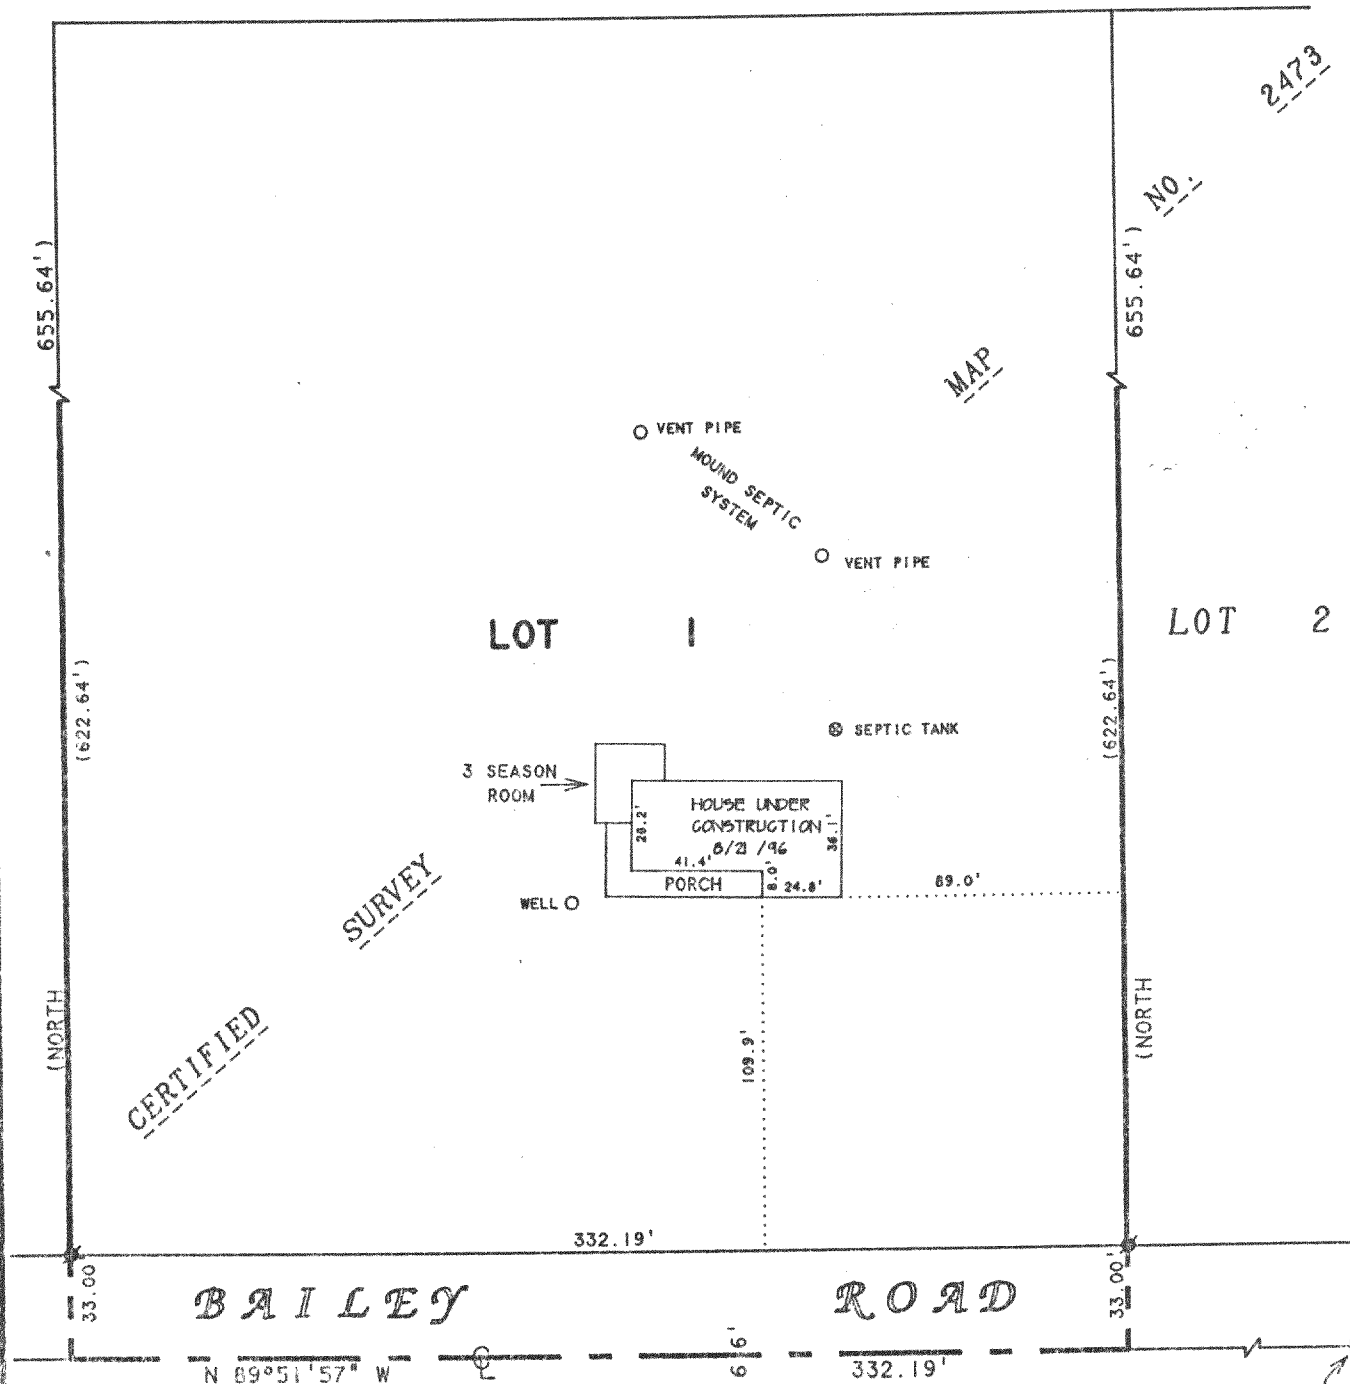

ORDERED BY: ROBERT HIRCH
5160 BAILEY ROAD
DELAVAN, WI 53115

SOUTH 1/4 CORNER
SECTION 25-2-16

PLAT OF SURVEY OF

NOTE: BEARINGS ARE REFERENCED TO
CERTIFIED SURVEY MAP NO. 2473.

PART OF LOT 1, CERTIFIED SURVEY MAP NO. 2473,
LOCATED IN SOUTHWEST 1/4 OF SECTION 25, T2N,
R16E, WALWORTH COUNTY, WISCONSIN.




SCALE 1"=60'
LEGEND

- -CONCRETE MONUMENT FOUND
- -IRON ROD FOUND
- () -RECORDED AS

I, DAVID F. ABELL, DO HEREBY CERTIFY THAT I HAVE SURVEYED THE PROPERTY HEREON
DESCRIBED ACCORDING TO THE OFFICAL RECORDS AND THAT THE PLAT HEREON IS A
CORRECT REPRESENTATION OF THE PROPERTY LINES TO THE BEST OF MY KNOWLEDGE AND
BELIEF.

David F. Abell
DAVID F. ABELL
WISCONSIN REGISTERED LAND SURVEYOR, S-1596

August 28, 1996

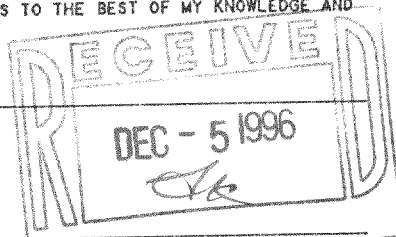

DATE: August 28, 1996
NOTE: THIS IS NOT A CERTIFIED COPY UNLESS SEALED.

JOB NUMBER - 93216

FA-2473-1 216-2326