


ABELL
SURVEYING & MAPPING
DELAVAL, WISCONSIN 53115
414-728-6737

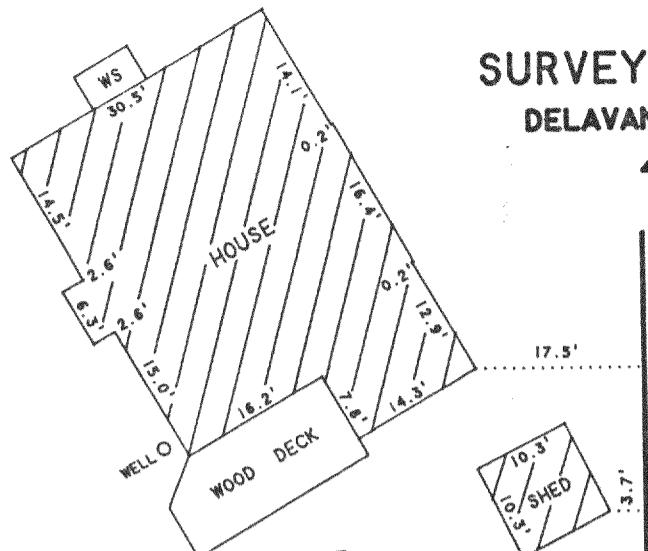

DETAIL SCALE 1"=20'

ORDERED BY: CENTURY 21-SKANDIA REALTY
312 S. 7th STREET
DELAVAL, WI. 53115

PLAT OF SURVEY OF

A parcel of land located in the W $\frac{1}{2}$ of Lot 5 and 6 of the subdivision of the SE fr'l $\frac{1}{4}$ of Sec. 28 and the NE fr'l $\frac{1}{4}$ of Sec. 33 T 2 N R 16 E of Walworth County, Wisconsin described as follows, to-wit: Commencing at the point of intersection of the W line of said Lot 6 and the SE line of the public highway; thence N 56° E along the highway 168.35 ft. to the place of beginning, thence S 28° 05' E 114.02 ft. thence S 4° 07' W 386.17 ft. thence S 89° 44' E 146.50 ft. to the E line of the W $\frac{1}{2}$ of said lot 5; thence N'ly along said E line 604.75 ft. to the S'ly line of the highway; thence S 56° W along the highway 211.49 ft. to the place of beginning, containing 1.71 acres of land more or less.

REVISED: SEPTEMBER 16, 1996
ORDERED BY: MIKE O'SHEA
3204 S. SHORE DRIVE
DELAVAL, WI 53115


SCALE 1"=60'

LEGEND

- - IRON PIPE FOUND
- WS - WOOD STOOP
- SH - SHED
- X— - WIRE FENCE
- () - RECORDED AS

NOTE: BEARINGS ARE REFERENCED TO EXISTING SURVEY RECORDS.

FOP-4A
216-2328

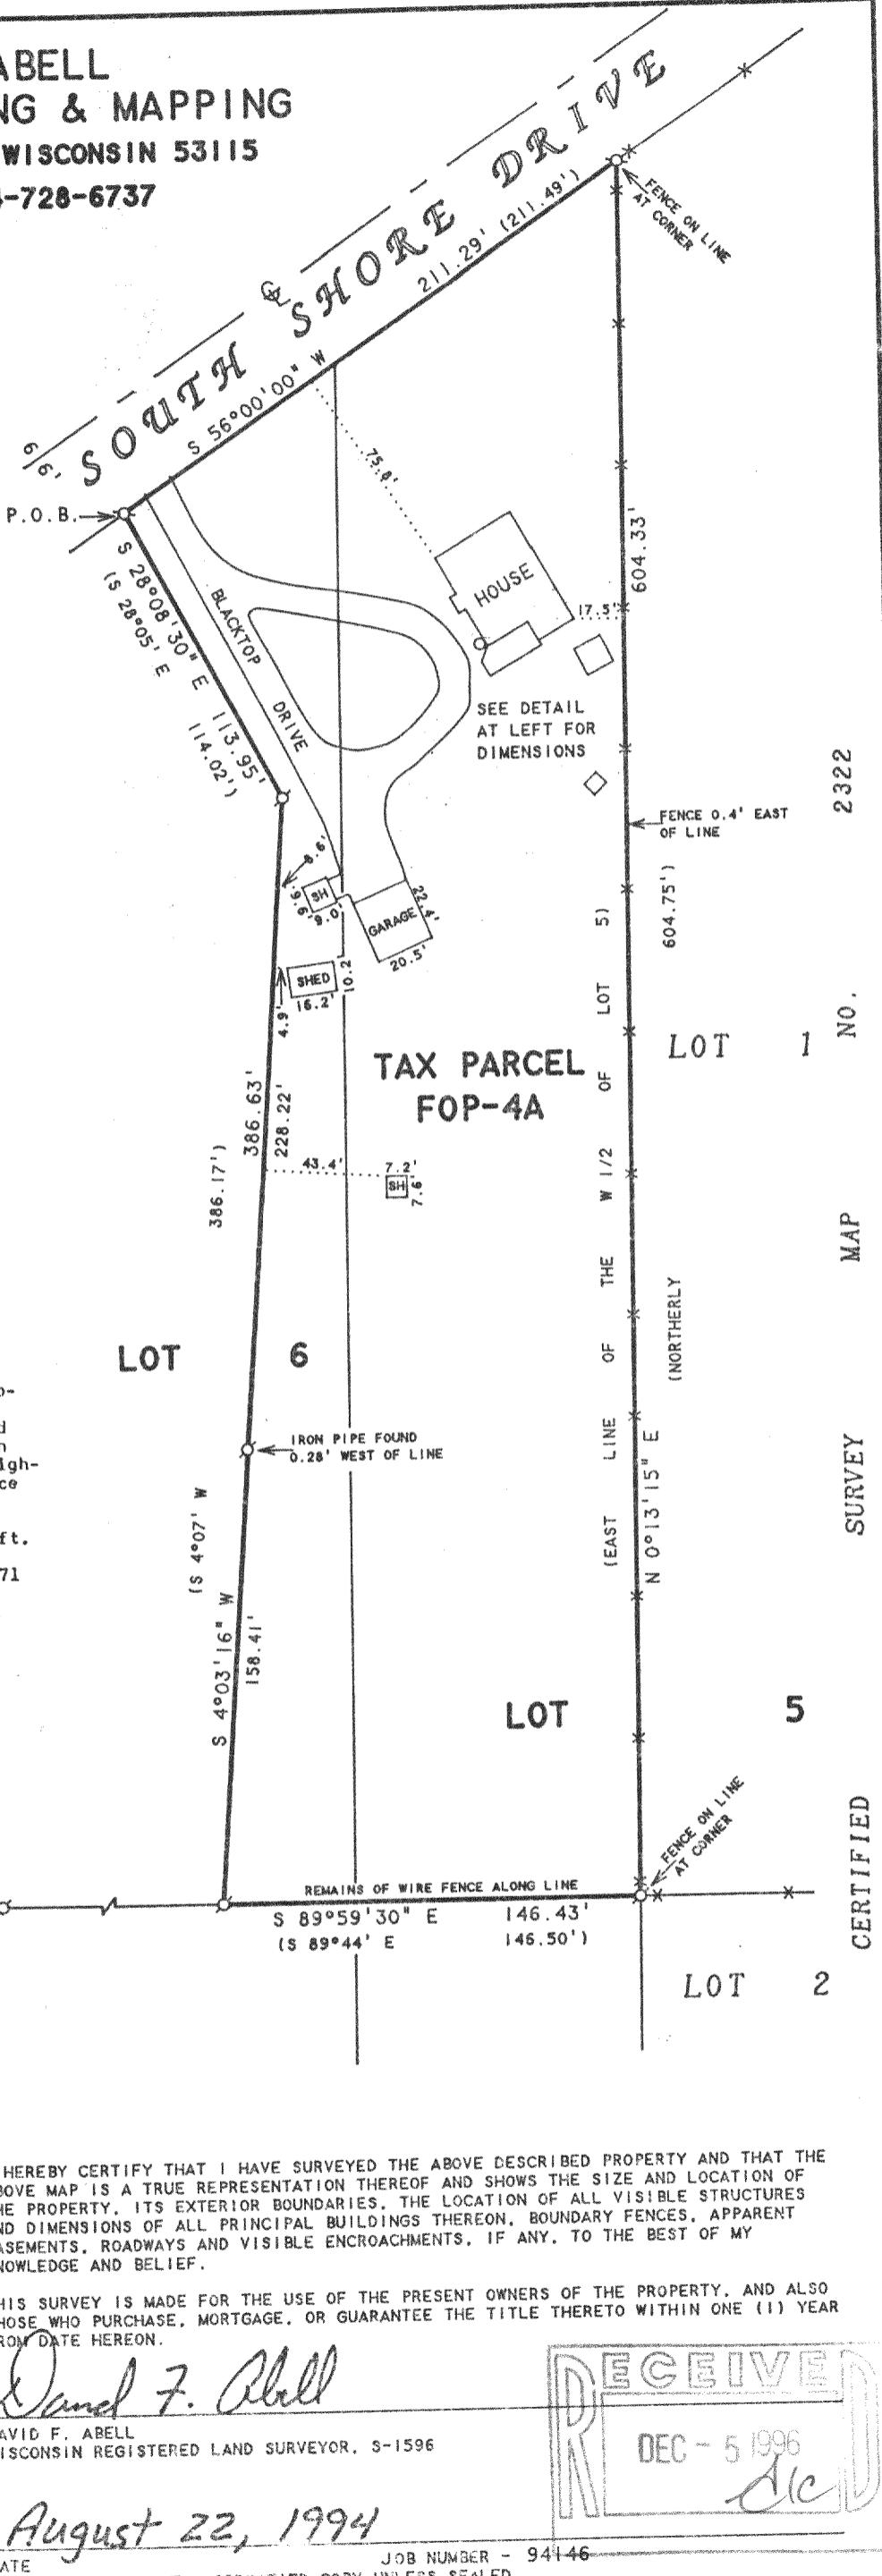

2322

NO.

MAP

SURVEY

CERTIFIED