


ABELL  
SURVEYING & MAPPING  
DEHAVAN, WISCONSIN 53115  
414-728-6737

LOT 1

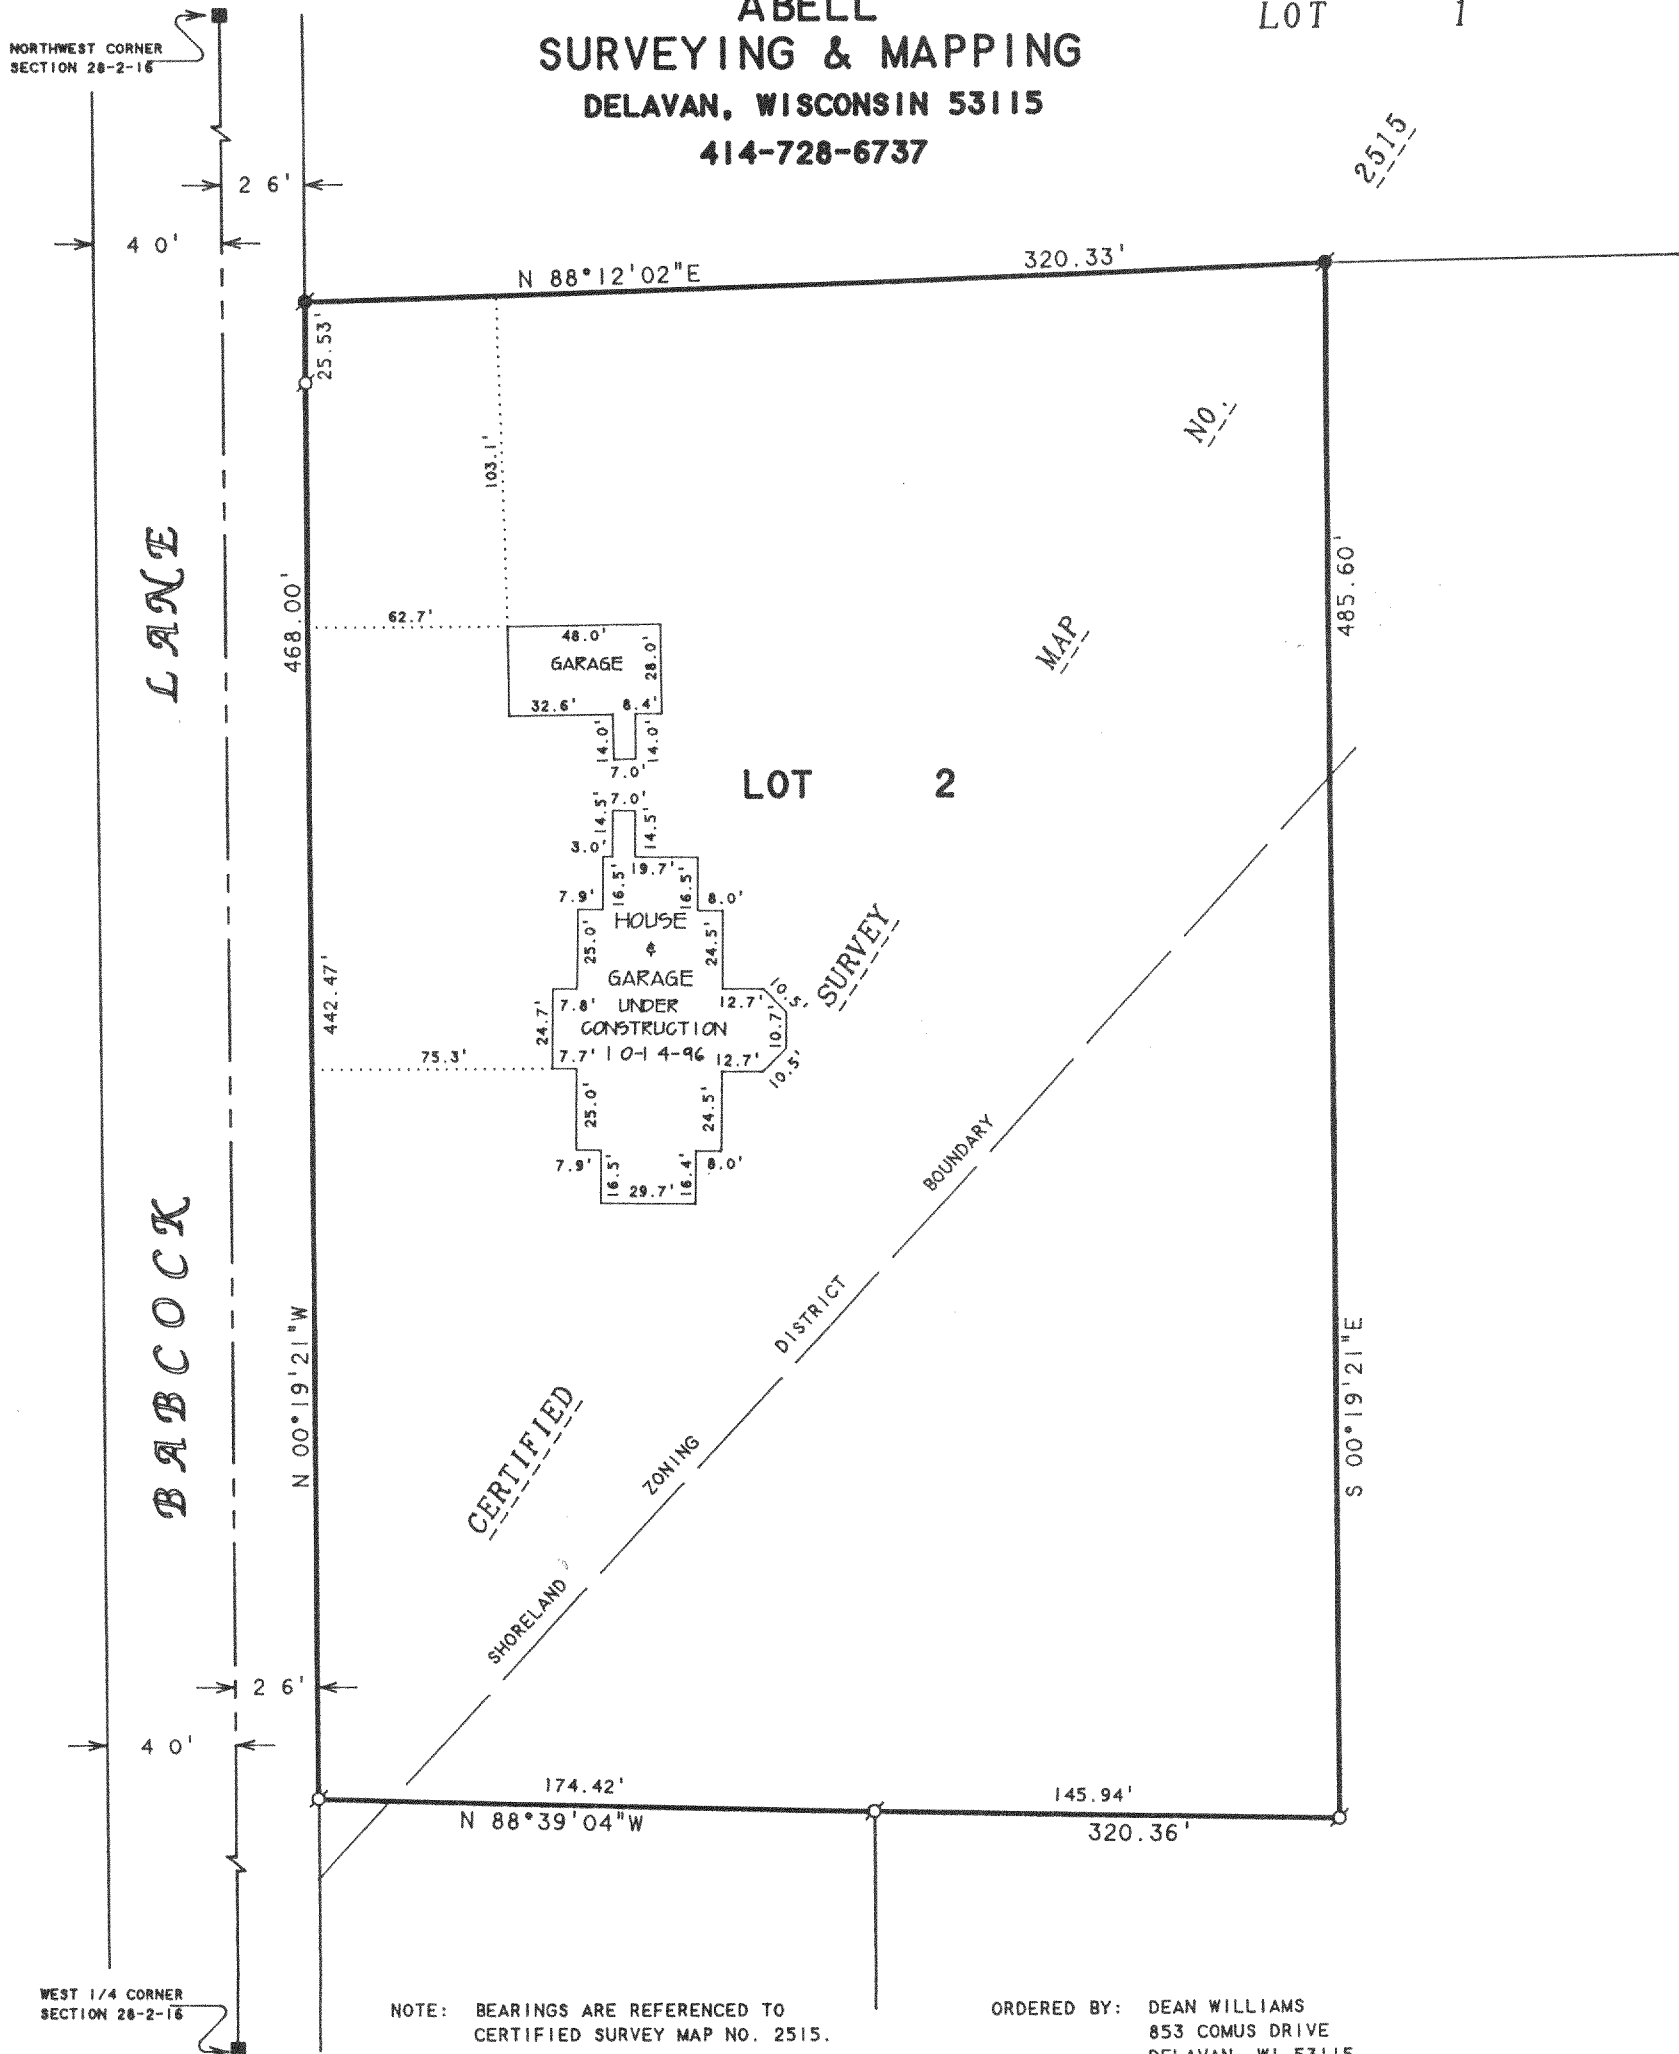

CERTIFIED

ZONING

DISTRICT

BOUNDARY

MAP

LOT 2

NOTE: BEARINGS ARE REFERENCED TO  
CERTIFIED SURVEY MAP NO. 2515.

ORDERED BY: DEAN WILLIAMS  
853 COMUS DRIVE  
DEHAVAN, WI 53115

PLAT OF SURVEY OF

LOT 2, CERTIFIED SURVEY MAP NO. 2515, LOCATED IN  
THE NORTHWEST 1/4 OF SECTION 28, T2N, R16E, WALWORTH  
COUNTY, WISCONSIN.

N



SCALE 1"=60'

LEGEND


- -CONCRETE MONUMENT FOUND
- -IRON PIPE FOUND
- -IRON ROD FOUND

I, DAVID F. ABELL, DO HEREBY CERTIFY THAT I HAVE SURVEYED THE PROPERTY HEREON  
DESCRIBED ACCORDING TO THE OFFICAL RECORDS AND THAT THE PLAT HEREON IS A  
CORRECT REPRESENTATION OF THE PROPERTY LINES TO THE BEST OF MY KNOWLEDGE AND  
BELIEF.

David F. Abell  
DAVID F. ABELL  
WISCONSIN REGISTERED LAND SURVEYOR, S-1596

October 25, 1996

DATE JOB NUMBER - 94148  
NOTE: THIS IS NOT A CERTIFIED COPY UNLESS SEALED.

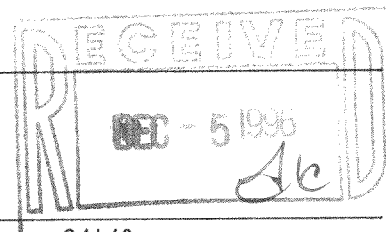

FA-2515-2  
216-2330