


GEORGE T. DUNHAM
SURVEYING & SUBDIVIDING
DELAVAN, WISCONSIN

N



Scale - 1" = 20'
o = Iron Pipe

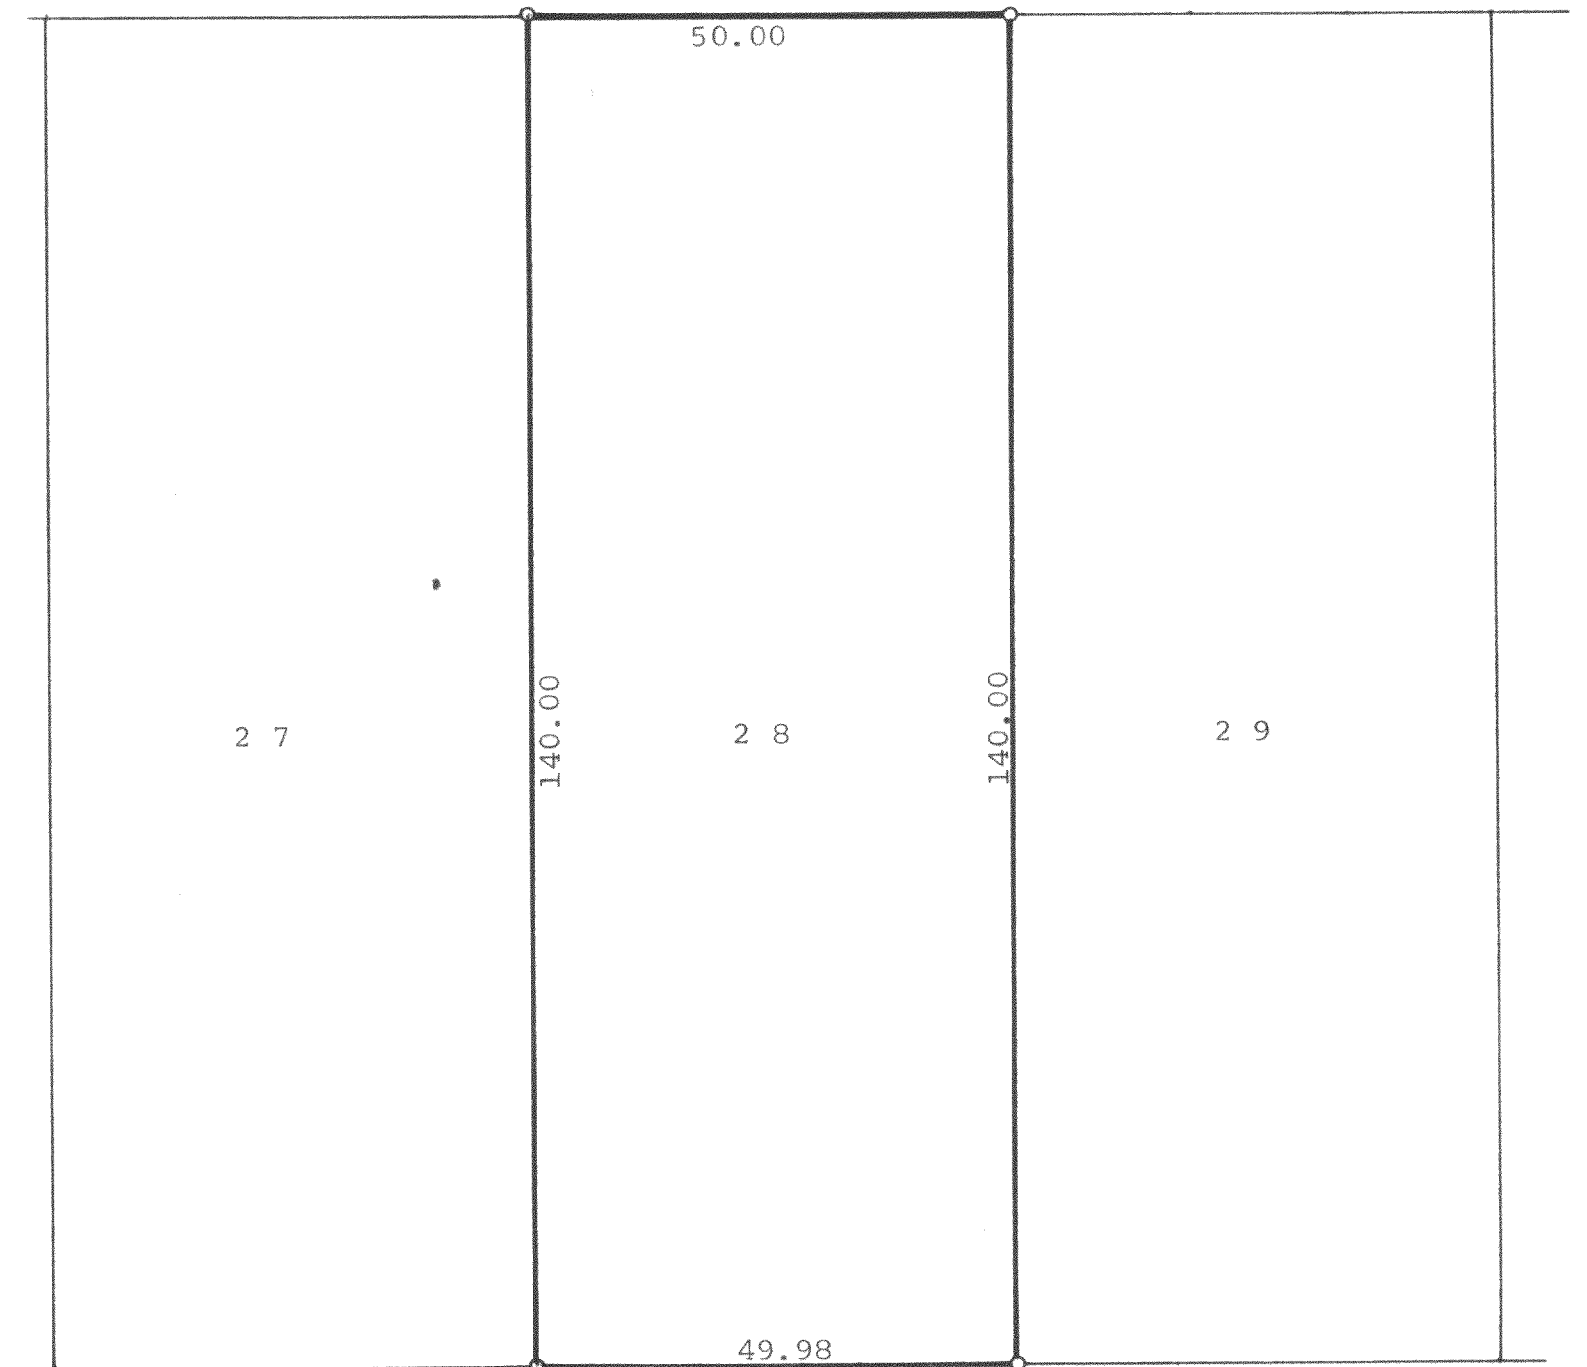

SCHROEDER AVENUE

Plat of survey of Lot 28, Block 9, Inlet Oaks Subdivision
No. 4 located in Section 15, T 2 N, R 16 E, Walworth County,
Wisconsin.
November 11, 1966

George T. Dunham
George T. Dunham, Surveyor

216-234