
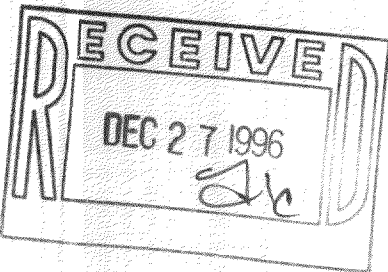


PLAT OF SURVEY

LEGAL DESCRIPTION
Lot 8 of Shady Side Park Subdivision and Lot 7 of James Weed Subdivision of Shadyside Park Subdivision, Located in the Northeast 1/4 of Section 33, Town 2 North, Range 16 East, Town of Delavan, County of Walworth, State of Wisconsin.

Ordered by: Alan Inbinder

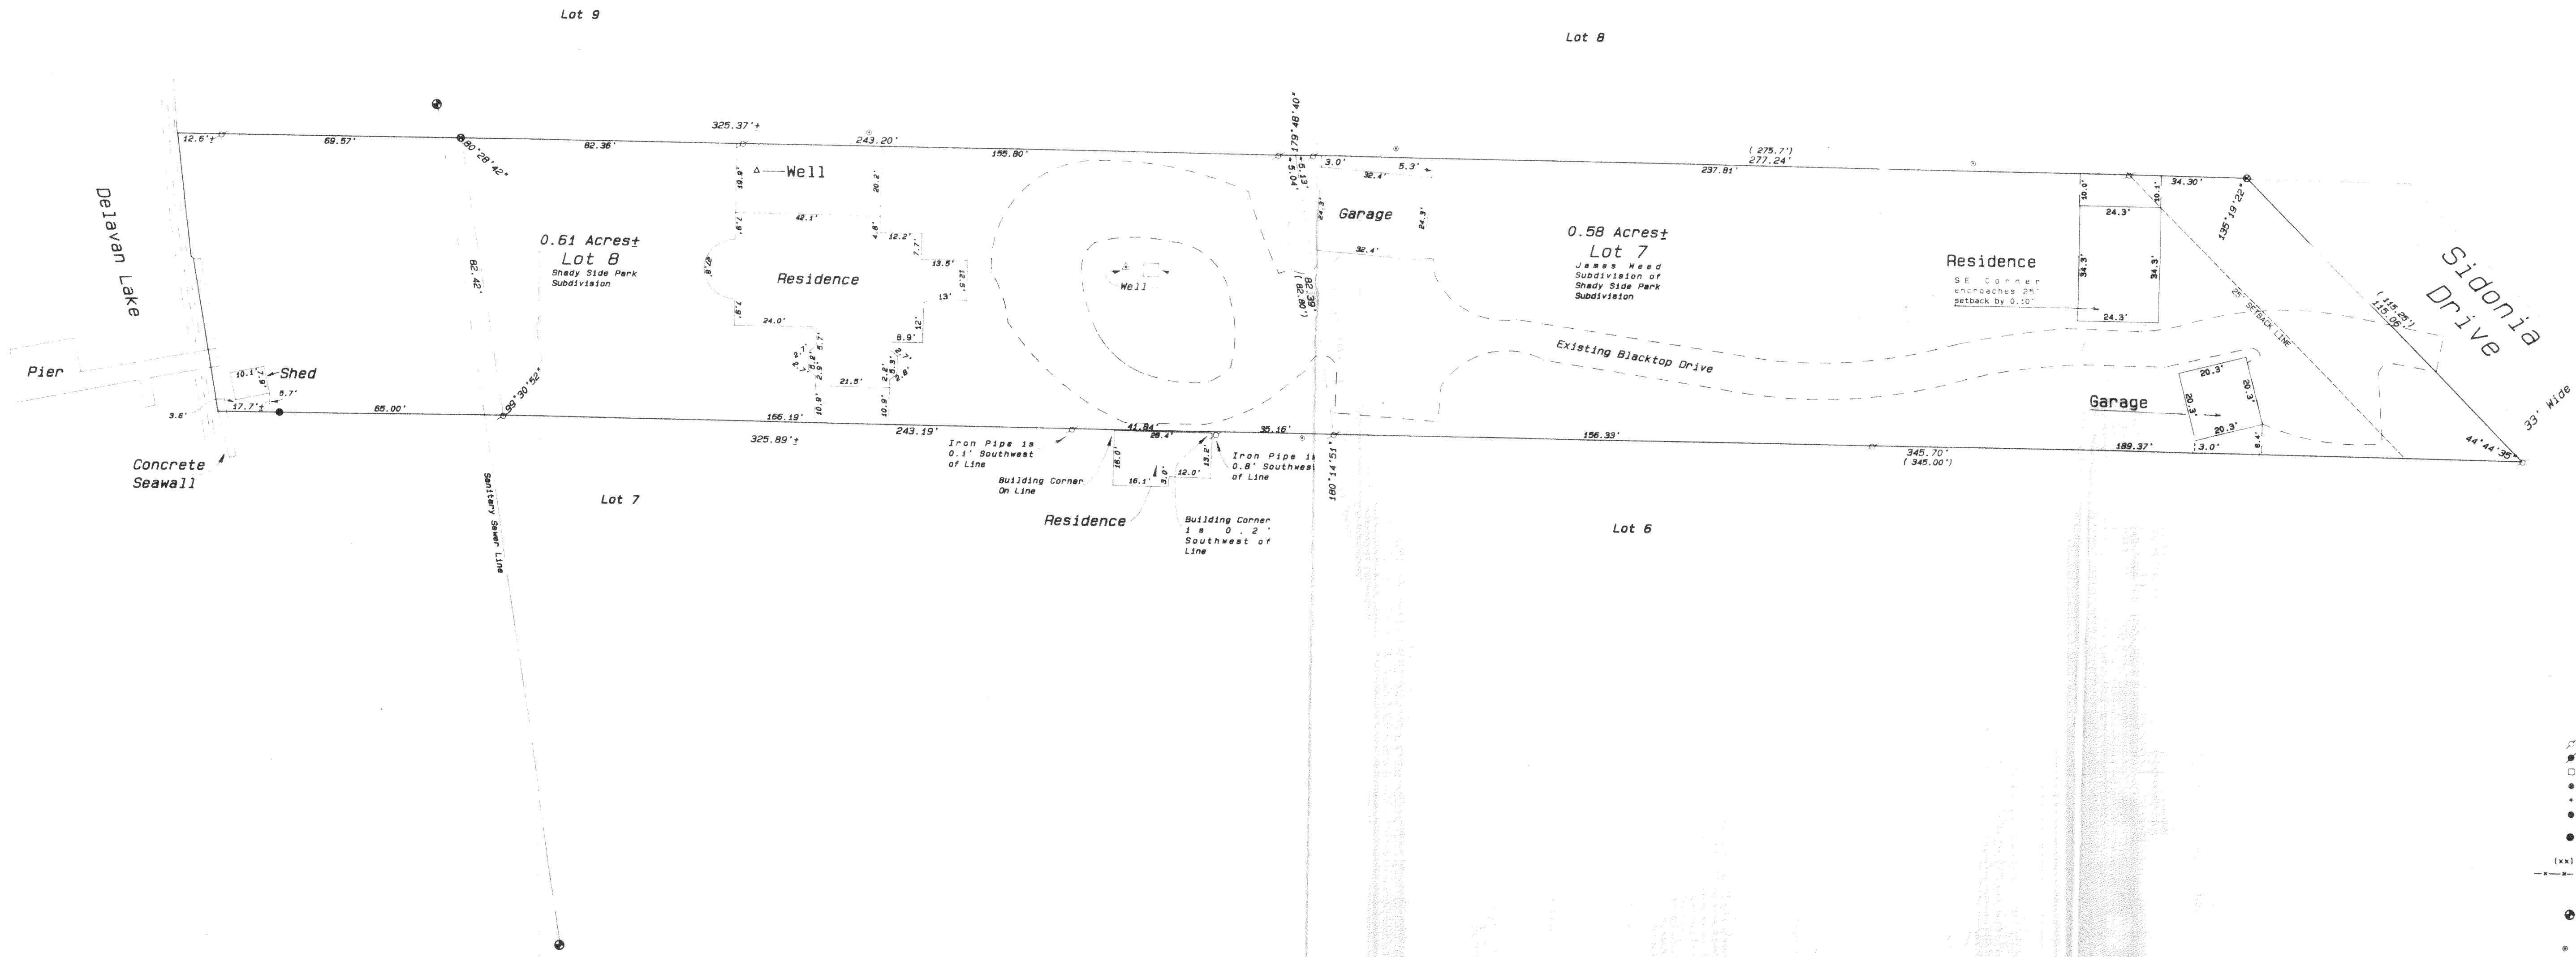

I hereby certify that I have surveyed the above described property and that the above map is a true representation thereof and shows the size and location of the property, its exterior boundaries, the location of all visible structures and dimensions of all principal buildings thereon, boundary fences, apparent easements, roadways and visible encroachments, if any.
This survey is made for the use of the present owners of the property, and also those who purchase, mortgage, or guarantee the title thereto within one year from date hereof.
Kenneth B. Abernathy, Jr.
KENNETH B. ABERNATHY, JR.
WISCONSIN REGISTERED LAND SURVEYOR,
S-1594
Date: August 20, 1992 Job No. 1992-615

Revised 10-18-96