


**ABELL  
SURVEYING & MAPPING  
DELAVAN, WISCONSIN 53115  
414-728-6737**

ORDERED BY: GENE PURCELL  
1103 COMPTON  
ADDISON, IL 60101

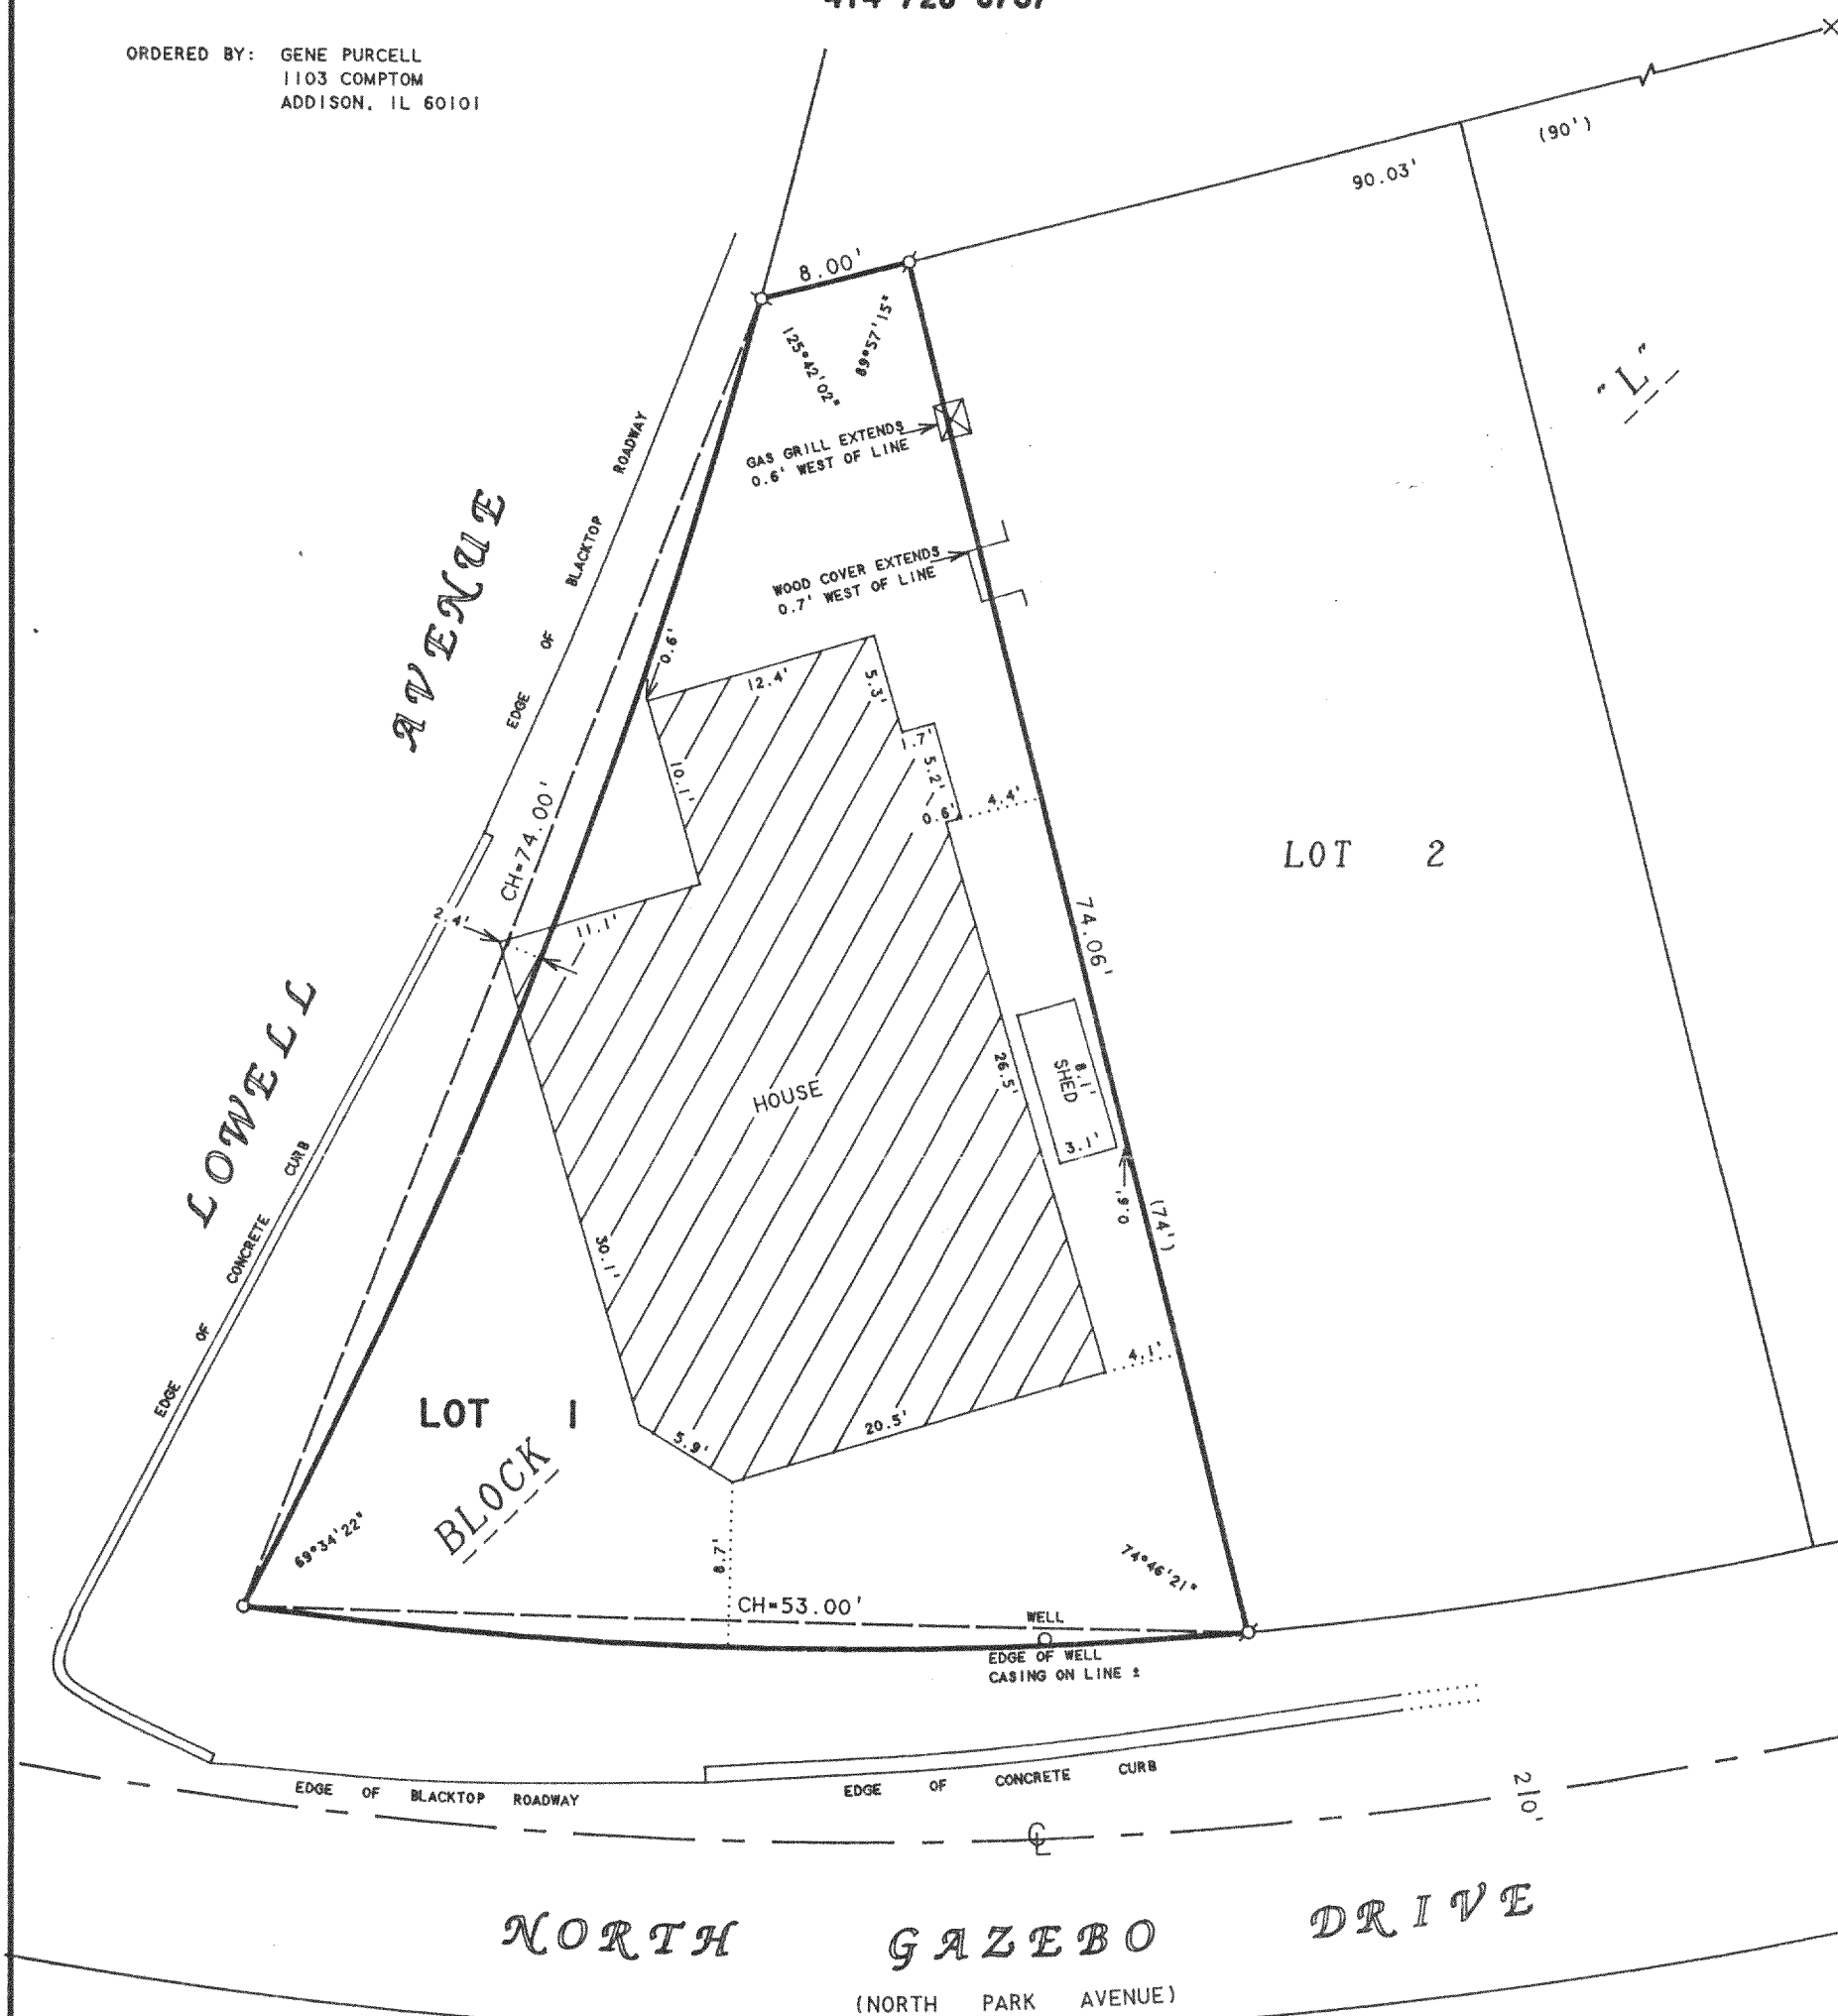

**PLAT OF SURVEY OF**

LOT 1, BLOCK "L", DELAVAN LAKE ASSEMBLY  
GROUNDS, LOCATED IN T2N, R16E, WALWORTH  
COUNTY, WISCONSIN.

**N**



SCALE 1"=10'

**LEGEND**

- - IRON PIPE FOUND
- × - CUT CROSS IN CONCRETE FOUND
- - IRON PIPE SET
- ( ) - RECORDED AS


I, DAVID F. ABELL, DO HEREBY CERTIFY THAT I HAVE SURVEYED THE PROPERTY HEREON  
DESCRIBED ACCORDING TO THE OFFICIAL RECORDS AND THAT THE PLAT HEREON IS A  
CORRECT REPRESENTATION OF THE PROPERTY LINES TO THE BEST OF MY KNOWLEDGE AND  
BELIEF.

*David F. Abell*

DAVID F. ABELL  
WISCONSIN REGISTERED LAND SURVEYOR, S-1596

*October 17, 1996*

DATE: October 17, 1996 JOB NUMBER - 96180  
NOTE: THIS IS NOT A CERTIFIED COPY UNLESS SEALED.

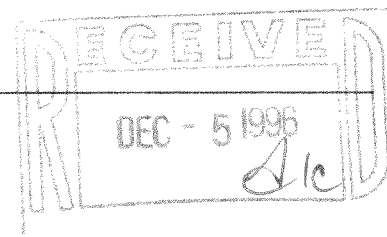

FDLA-117

216-2350