


165.03'

DRIVE 14' WIDE

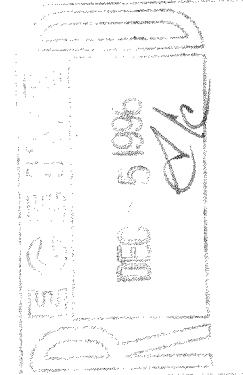

DATE / / JOB NUMBER - 96131
NOTE: THIS IS NOT A CERTIFIED COPY UNLESS SEALED.

216-2362