


**ABELL
SURVEYING & MAPPING
DELAVAN, WISCONSIN 53115
414-728-6737**


ORDERED BY: KEEFE REAL ESTATE
704 W. MAIN ST.
LAKE GENEVA, WI 53147

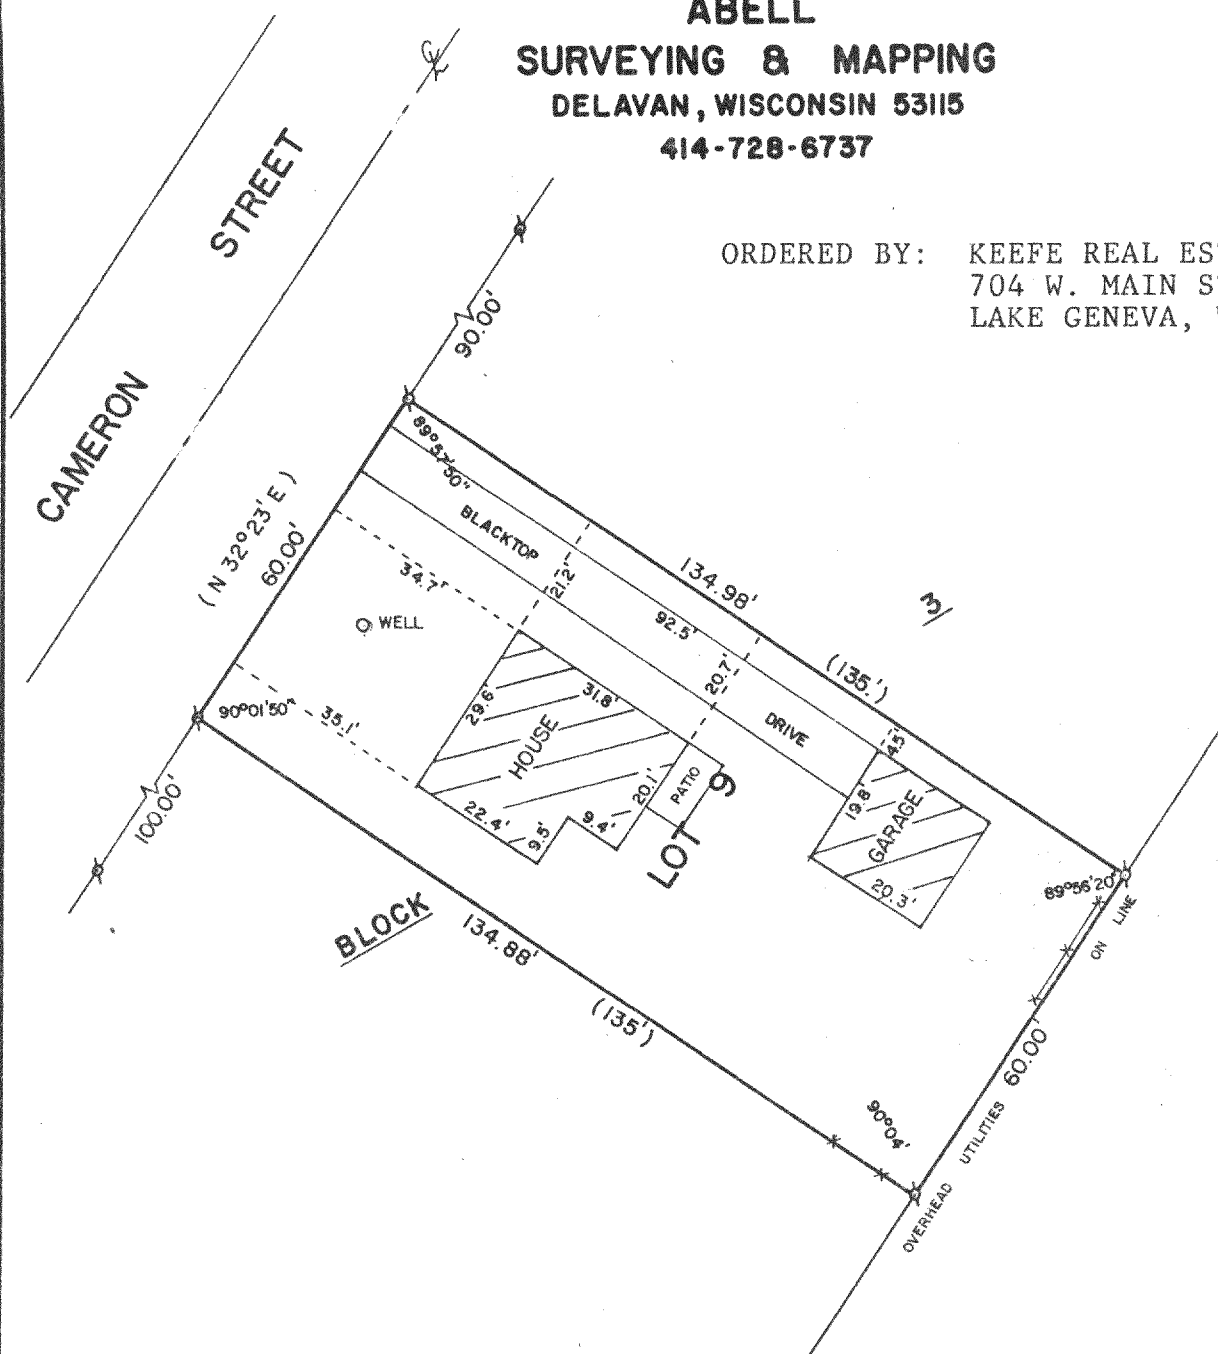

PLAT OF SURVEY OF

LOT 9, BLOCK 3, DELMAR SUBDIVISION, T2N,R16E,
WALWORTH COUNTY, WISCONSIN.

UPDATE SURVEY FOR: CENTURY 21-SKANDIA REALTY
312 S. 7th STREET
DATED: 8/15/96 DELAVAN, WI 53115

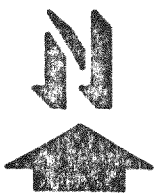


SCALE - 1"=30'

LEGEND

♂ - IRON PIPE FOUND
() - RECORDED AS
* - WIRE FENCE

I, DAVID F. ABELL, DO HEREBY CERTIFY
THAT I HAVE SURVEYED THE PROPERTY
HEREON DESCRIBED ACCORDING TO THE
OFFICIAL RECORDS AND THAT THE PLAT
HEREON IS A CORRECT REPRESENTATION
OF THE PROPERTY LINES TO THE BEST OF
MY KNOWLEDGE AND BELIEF.

David F. Abell
DAVID F. ABELL
WISCONSIN REGISTERED LAND SURVEYOR, S-1596

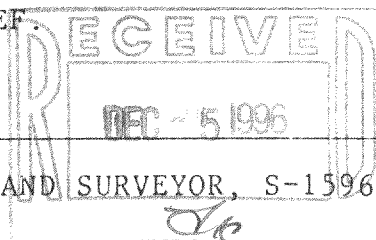

April 17, 1987
DATE JOB NUMBER - 87040
NOTE: THIS IS NOT A CERTIFIED COPY UNLESS SEALED.

216-2363
FDM-171