


GEORGE T. DUNHAM
SURVEYING & SUBDIVIDING
DELAVER, WISCONSIN

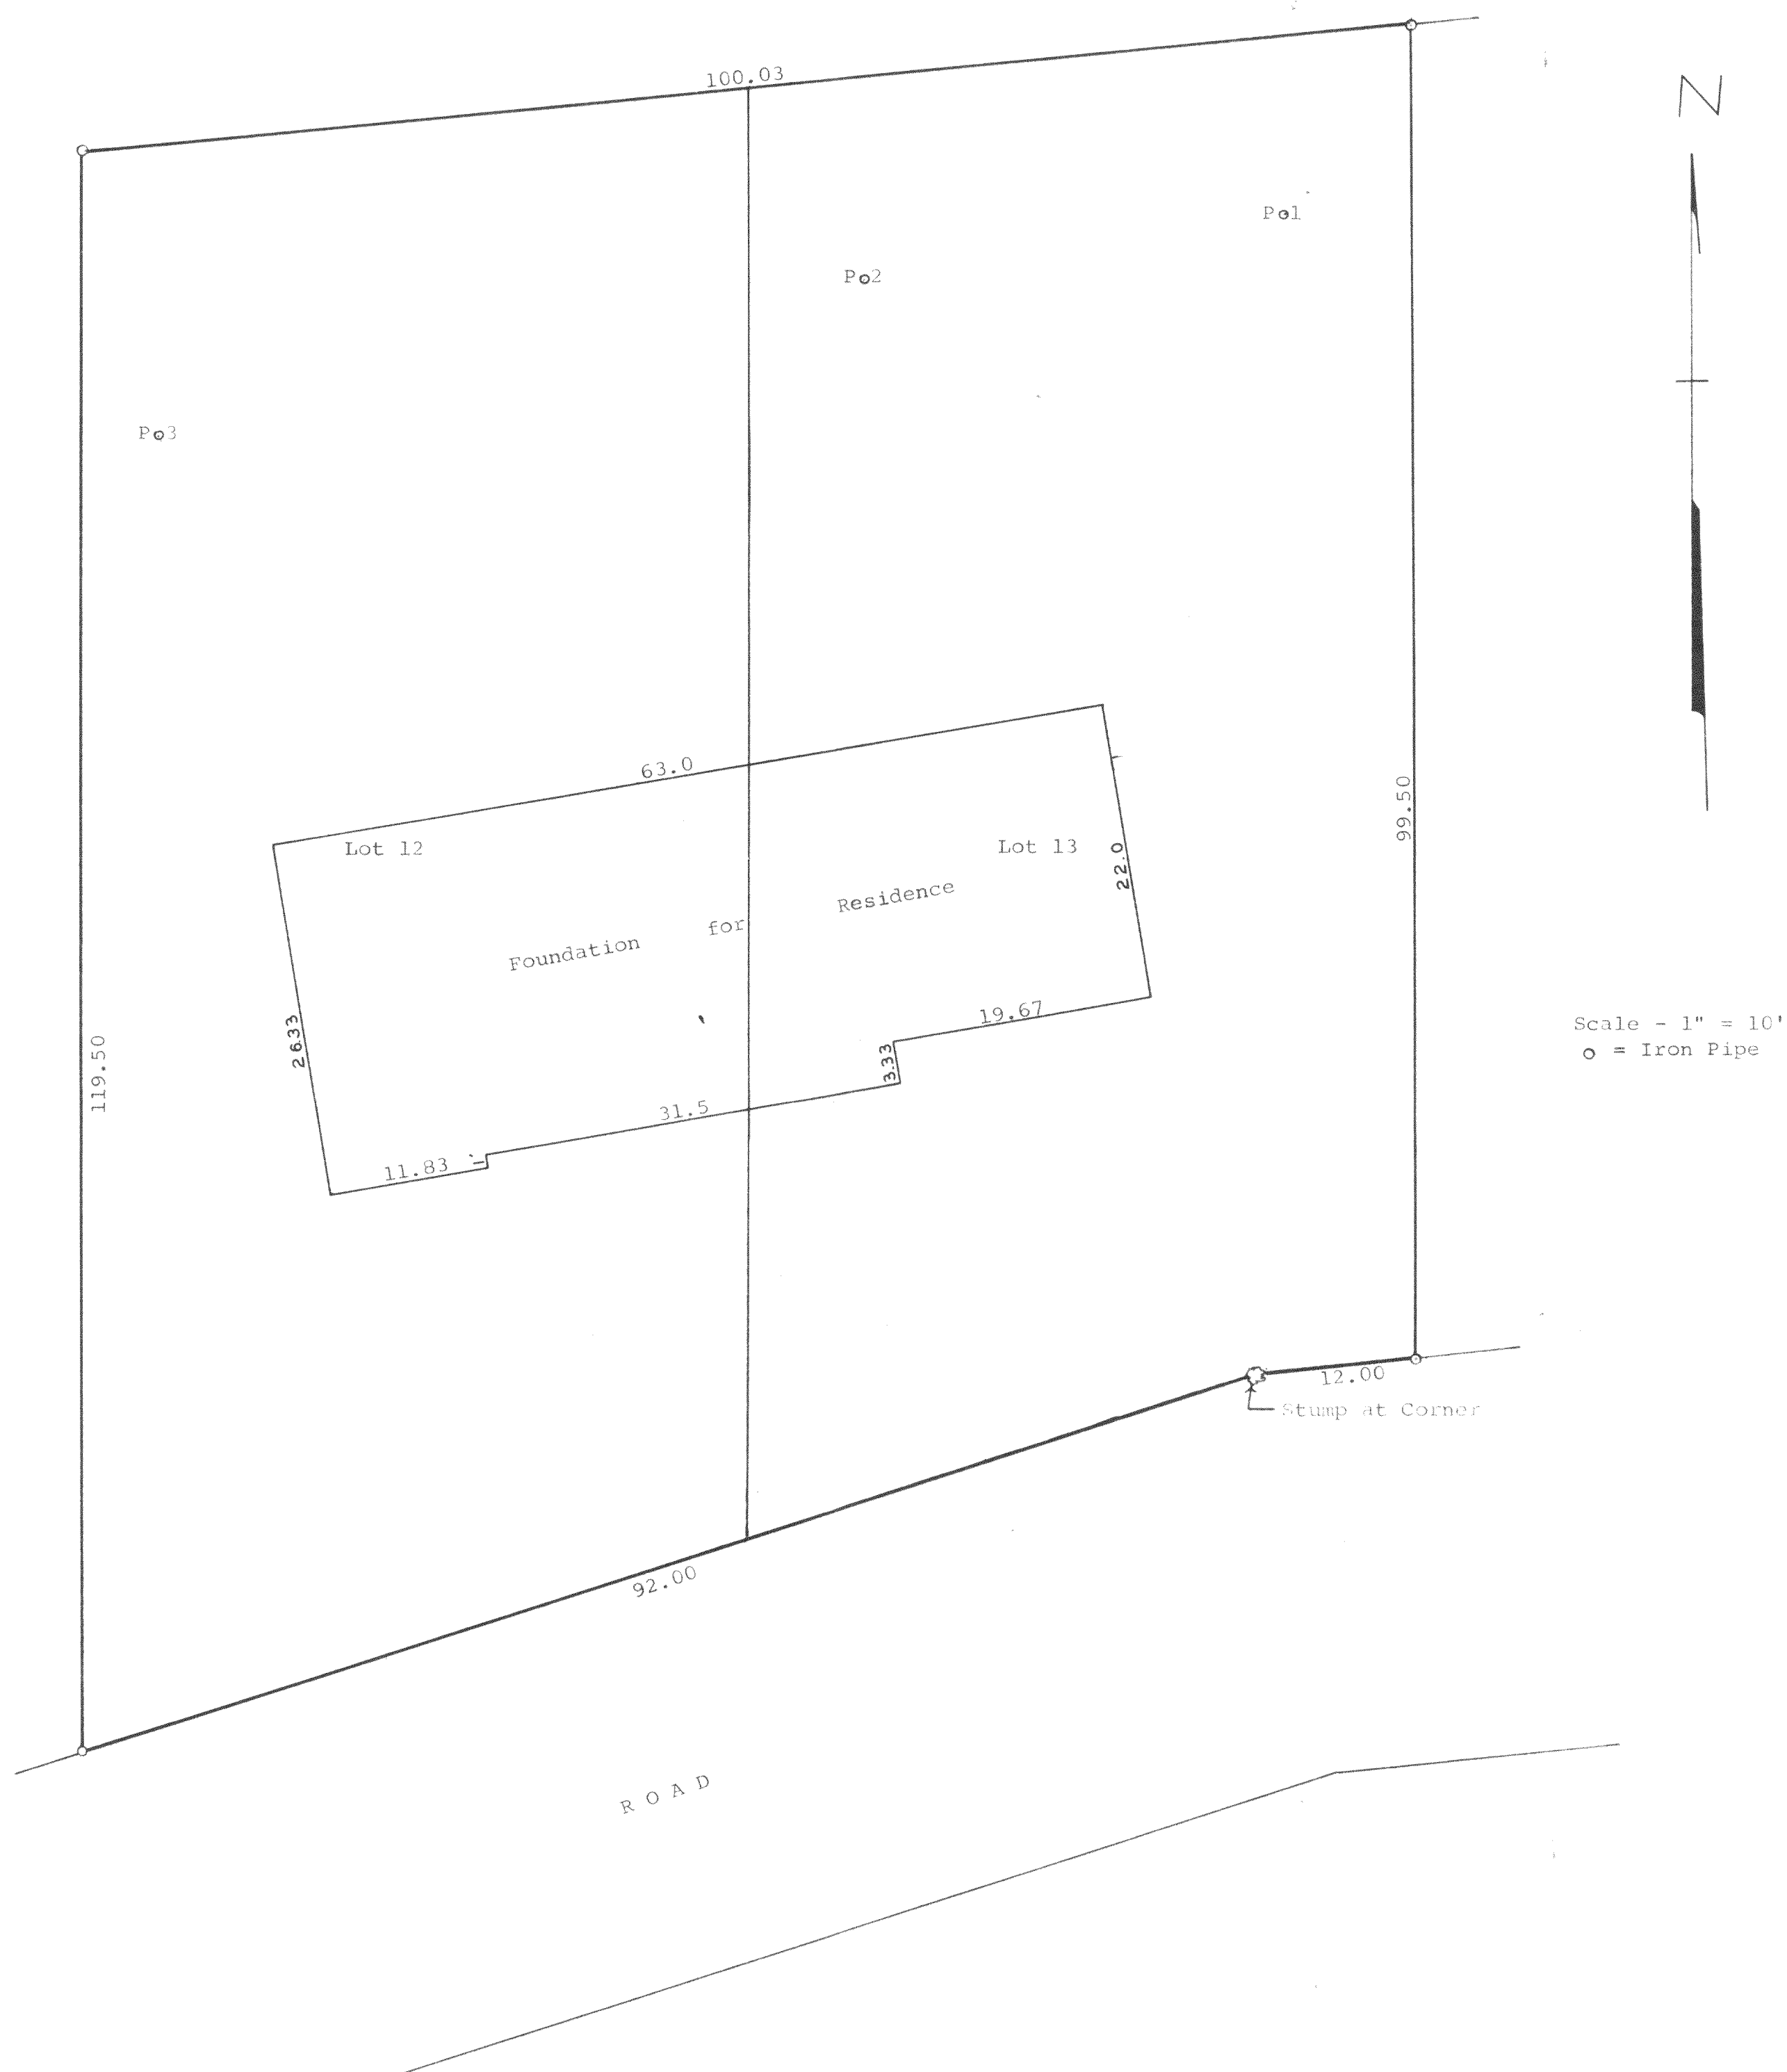

Plat of survey of Lots 12 and 13 in Block 7, Inlet Oaks
Subdivision No. 4 located in Section 15, T 2 N, R 16 E,
Walworth County, Wisconsin.
January 20, 1967
Revised March 3, 1967
George T. Dunham
George T. Dunham, Surveyor