




FDM-59E
216-2400

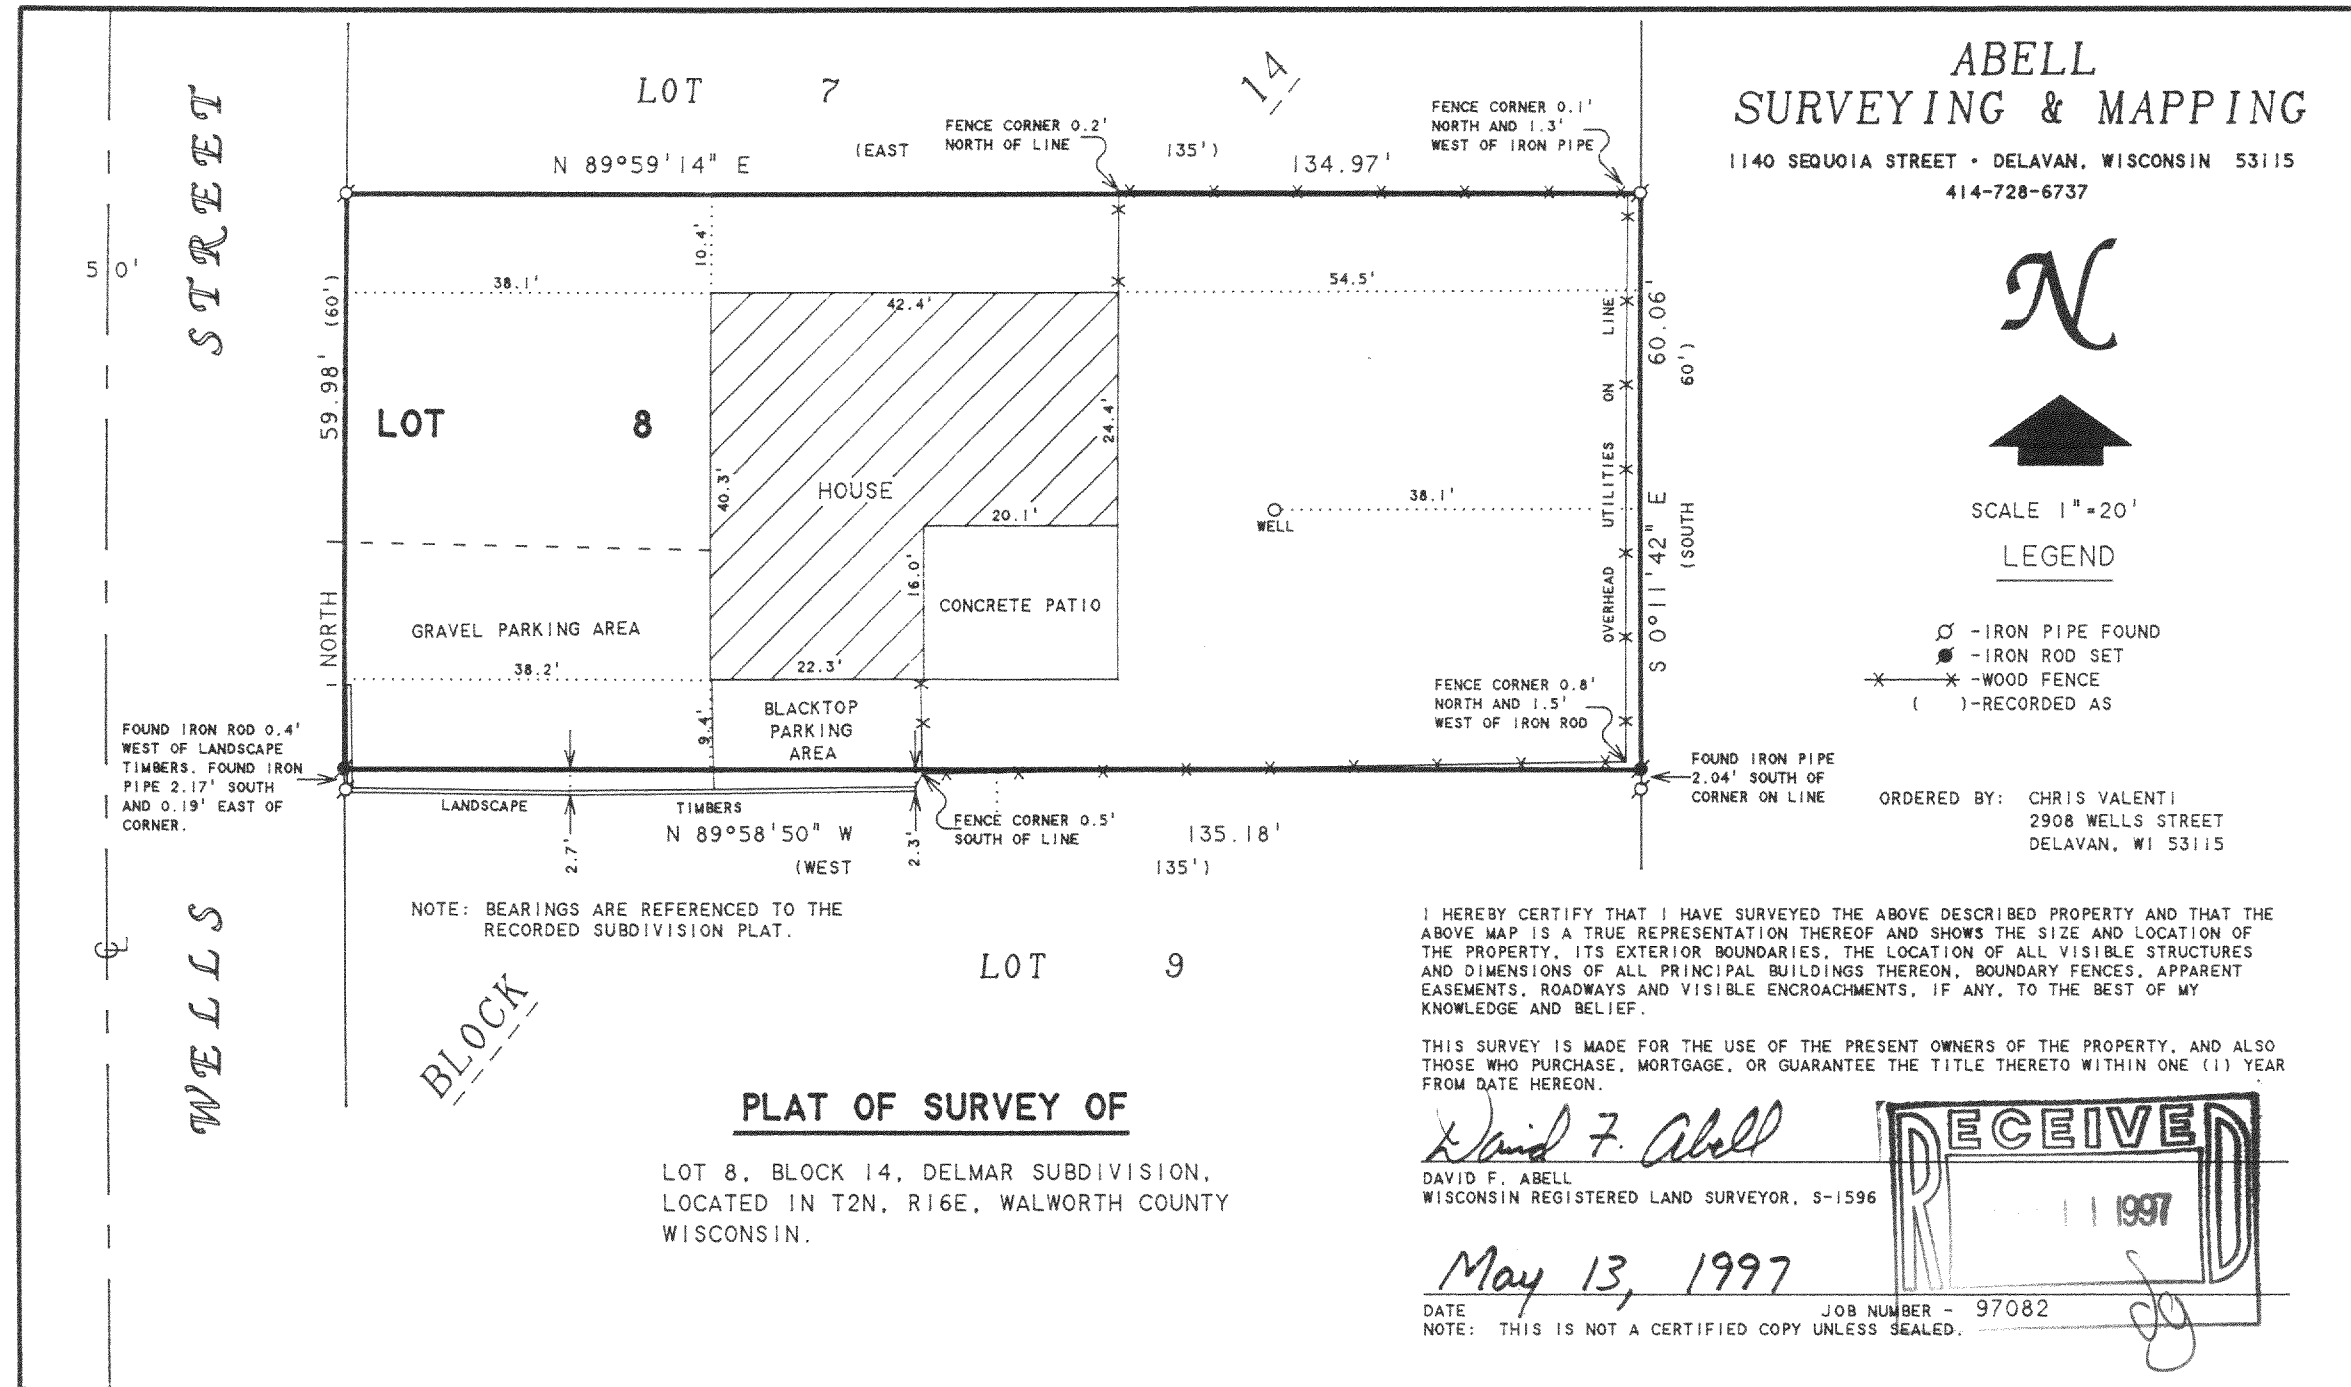